


Map No. _____ Sec. 1 Twp. 26 R. 4Well No. 5-Abraham Farm _____Empire Company

NORTH

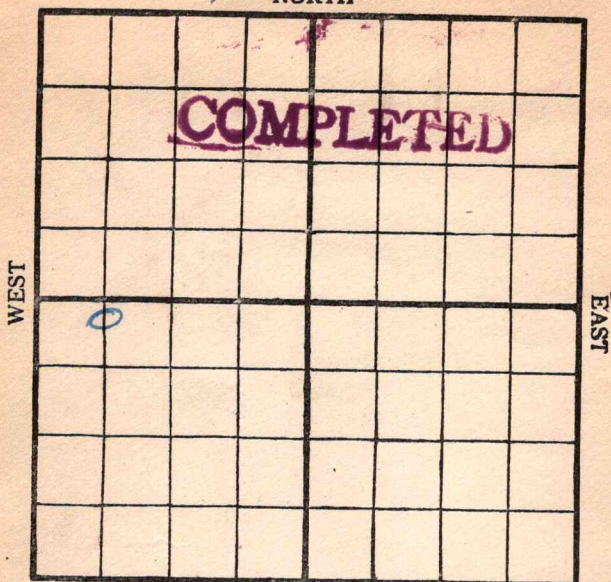

SOUTH

Location _____

Rig Up _____

Drilling Remarks:

Drilling Remarks:

RECORD

Cased _____ in. _____ ft.

Sand _____

Gas _____

Oil _____

Total Depth _____

PRODUCTION

1st 24 hrs. Nat. _____

1st 24 h.s. after shot _____

Gas _____ cu. ft

Dry Hole _____

Abandoned _____

Map No. H14 Sec. 1 Twp. 26 R. 4Well No. 5 Abraham FarmEmpire Company

NORTH

WEST

EAST

SOUTH

Location ✓Rig Up ✓

Drilling and remarks

RECORD

Cased _____ in. _____ Ft.

Sand _____

Gas _____

Oil _____

Total Depth _____

PRODUCTION

1st 24 hrs. Nat. _____

1st 24 hrs. after shot _____

Gas _____ Cu. Ft.

Dry Hole _____

Abandoned _____

FIRST REPORT


Date

10/24, 1917 Condy Scout

Map No. _____ Sec. 1 Twp. 26 R. 4Well No. 5 Rolston _____ Farm __________
Engine _____ Company _____

NORTH

WEST

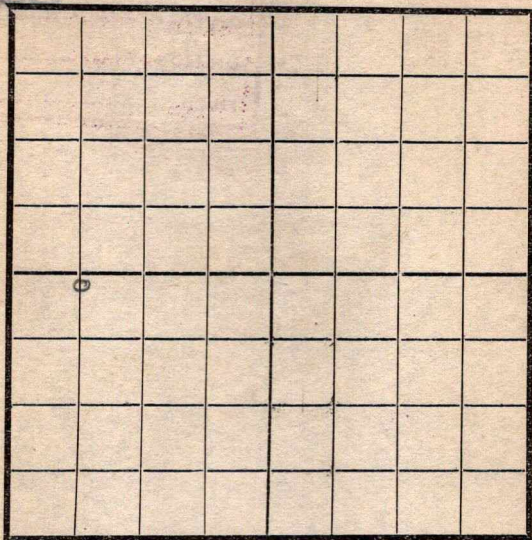

EAST

SOUTH

Location _____

Rig Up ☒ _____

Drilling and remarks _____

RECORD

Cased _____ in _____ Ft

Sand _____

Gas _____

Oil _____

Total Depth _____

PRODUCTION

1st 24 hrs. Nat. _____

1st 24 hrs. after shot _____

Gas _____ Cu. Ft

Dry Hole _____

Abandoned _____

Date


11-7, 1917 Conley _____ Scout _____

Map No. _____ Sec. 1 Twp. 26 R. 4
 Well No. 5 Palston Farm _____
Engine Company _____

NORTH

WEST

EAST

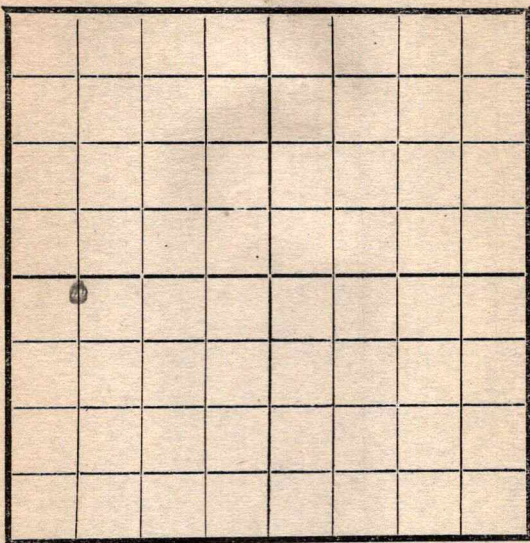

SOUTH

RECORD	
Location _____	Cased _____ in. _____ Ft.
Rig Up _____	Sand _____
Drilling and remarks	Gas _____
<i>Rigging up</i>	Oil _____
	Total Depth _____
	PRODUCTION
	1st 24 hrs. Nat. _____
	1st 24 hrs. after shot _____
	Gas _____ Cu. Ft.
	Dry Hole _____
	Abandoned _____

Date 11/14, 1917 C. C. C. Scout _____

Map No. _____ Sec. 1 Twp. 26 R. 4Well No. 5 Palstan Farm
Engine Company

NORTH

WEST

EAST

SOUTH

Location _____

Rig Up _____

Drilling and remarks

Rigging

RECORD

Cased _____ in. _____ Ft.

Sand _____

Gas _____

Oil _____

Total Depth _____

PRODUCTION

1st 24 hrs. Nat. _____

1st 24 hrs. after shot _____

Gas _____ Cu. Ft.

Dry Hole _____

Abandoned _____

Date


11/21, 1917 Carley Scout

Map No. _____ Sec. 1 Twp. 26 R. 4Well No. 5 Palston Farm _____
Engine Company _____

NORTH

WEST

EAST

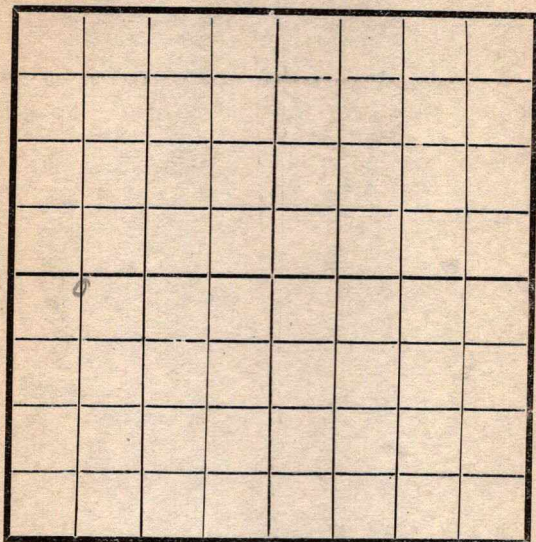

SOUTH

Location _____

Rig Up _____

Drilling and remarks

720

RECORD

Cased _____ in. _____ Ft.

Sand _____

Gas _____

Oil _____

Total Depth _____

PRODUCTION

1st 24 hrs. Nat. _____

1st 24 hrs. after shot _____

Gas _____ Cu. Ft.

Dry Hole _____

Abandoned _____


Date

11/28, 1917 C. L. C. Co. Scout

Map No. _____ Sec. 1 Twp. 26 R. 4Well No. 51 Ralston Farm _____Empire Company _____

NORTH

WEST

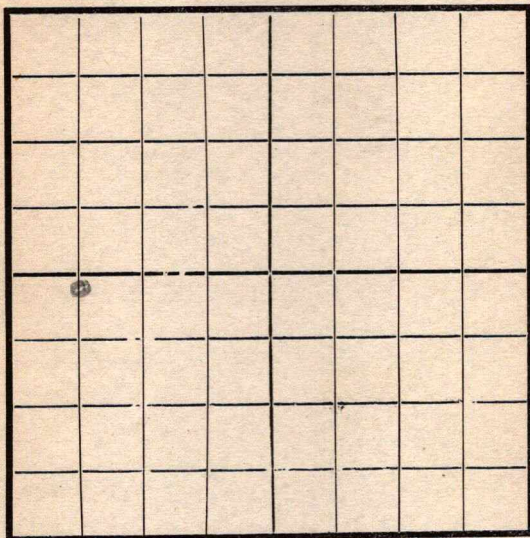

EAST

SOUTH

Location _____

Rig Up _____

Drilling and remarks

950

RECORD

Cased _____ in. _____ Ft.

Sand _____

Gas _____

Oil _____

Total Depth _____

PRODUCTION

1st 24 hrs. Nat. _____

1st 24 hrs. after shot _____

Gas _____ Cu. Ft.

Dry Hole _____

Abandoned _____


Date

10/5, 1917 Conroy Scout

Map No. _____ Sec. 1 Twp. 26 R. 4Well No. 5 Rolston FarmEmpire Company

NORTH

WEST

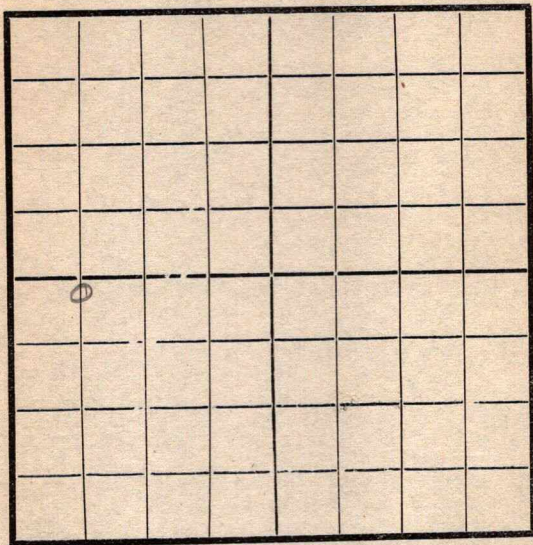

EAST

SOUTH

Location _____

Rig Up _____

Drilling and remarks

42 950

RECORD

Cased _____ in. _____ Ft.

Sand _____

Gas _____

Oil _____

Total Depth _____

PRODUCTION

1st 24 hrs. Nat. _____

1st 24 hrs. after shot _____

Gas _____ Cu. Ft.

Dry Hole _____

Abandoned _____


Date

1/2, 1918 S. Cardiff Scout

Map No. _____ Sec. 1 Twp. 26 R. 4Well No. 5 Ralston Farm _____Cummins Company _____

NORTH

WEST

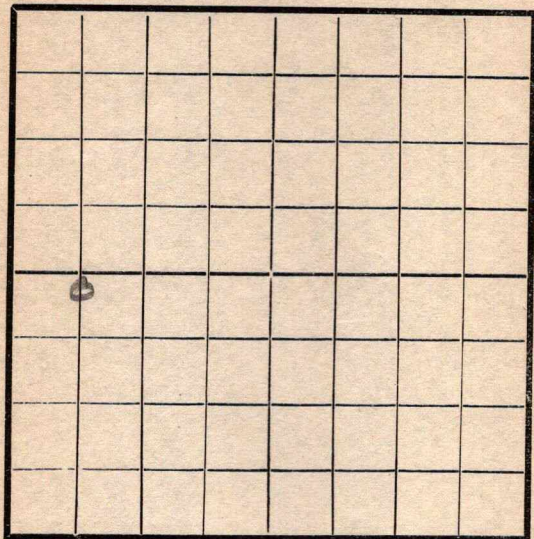

EAST

SOUTH

Location _____

Rig Up _____

Drilling and remarks

LD
950

RECORD

Cased _____ in. _____ Ft.

Sand _____

Gas _____

Oil _____

Total Depth _____

PRODUCTION

1st 24 hrs. Nat. _____

1st 24 hrs. after shot _____

Gas _____ Cu. Ft.

Dry Hole _____

Abandoned _____


Date

1/16, 1911 S. Condy Scout

Map No. _____ Sec. 1 Twp. 26 R. 4Well No. 5 Palston Farm
Empire 877 Company

NORTH

WEST

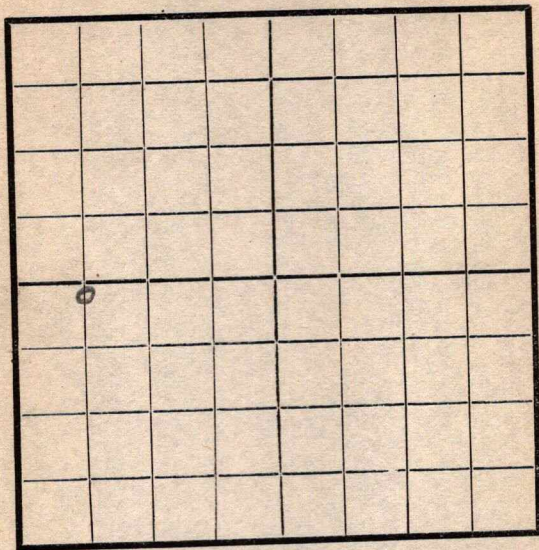

EAST

SOUTH

Location _____

Rig Up _____

Drilling and remarks

22 950'

RECORD

Cased _____ in _____ Ft.

Sand _____

Gas _____

Oil _____

Total Depth _____

PRODUCTION

1st 24 hrs. Nat. _____

1st 24 hrs. after shot _____

Gas _____ Cu. Ft.

Dry Hole _____

Abandoned _____


Date

1/23, 1918 S. Carby Scout

Map No. _____ Sec. 1 Twp. 26 R. 4
 Well No. 5 Palatka Farm _____
Engine Company _____

NORTH

WEST

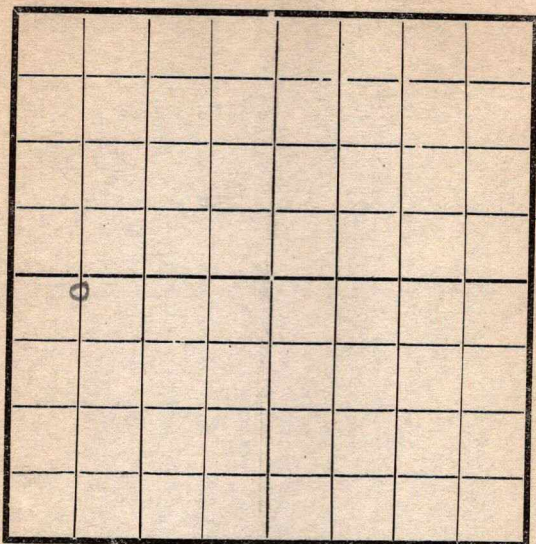

EAST

SOUTH

RECORD

Location _____
 Rig Up _____
 Drilling and remarks

sd
950

Cased _____ in. _____ Ft.
 Sand _____
 Gas _____
 Oil _____
 Total Depth _____

PRODUCTION

1st 24 hrs. Nat. _____
 1st 24 hrs. after shot _____
 Gas _____ Cu. Ft.
 Dry Hole _____
 Abandoned _____


Date

2/6, 1918 C. Condy Scout

Map No. _____ Sec. 1 Twp. 26 R. 4Well No. 5 Ralston FarmEmpire Company

NORTH

WEST

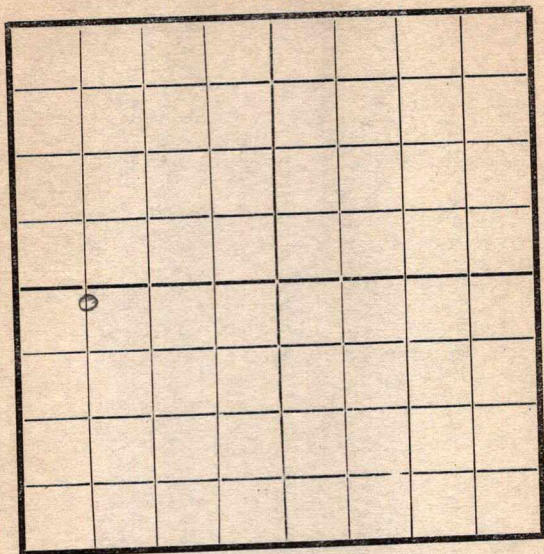

EAST

SOUTH

Location _____

Rig Up _____

Drilling and remarks

Fishing
950

RECORD

Cased _____ in. _____ Ft.

Sand _____

Gas _____

Oil _____

Total Depth _____

PRODUCTION

1st 24 hrs. Nat. _____

1st 24 hrs. after shot _____

Gas _____ Cu. Ft.

Dry Hole _____

Abandoned _____

Date

2/13, 191*8* *C. C. C.* Scout

Map No. _____ Sec. 1 Twp. 26 R. 4
 Well No. 57 Palstan Farm _____
Engine Company _____

NORTH

WEST

EAST

SOUTH

Location _____

Rig Up _____

Drilling and remarks

RECORD

Cased _____ in _____ Ft.

Sand _____

Gas _____

Oil _____

Total Depth _____

PRODUCTION

1st 24 hrs. Nat. _____

1st 24 hrs. after shot _____

Gas _____ Cu. Ft.

Dry Hole _____


Abandoned _____

Date

Nov 8, 1911 Scout _____

Map No. _____ Sec. 1 Twp. 26 R. 4
Well No. 5 Ralston Farm _____
Cambridge Company _____

NORTH

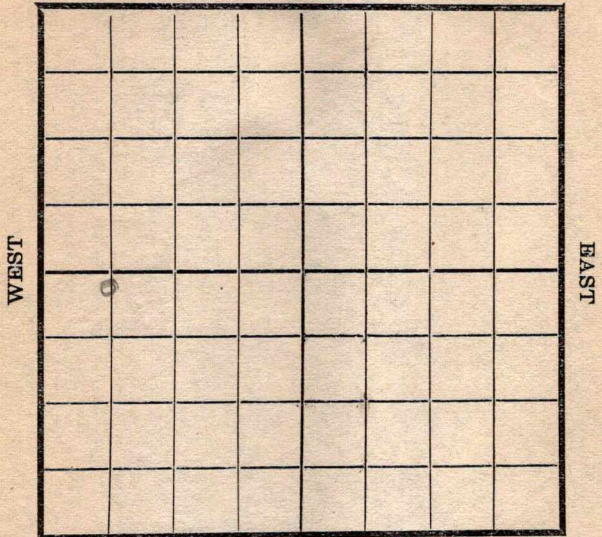

SOUTH


	RECORD
Location _____	Cased _____ in. _____ Ft.
Rig Up _____	Sand _____
Drilling and remarks	Gas _____
	Oil _____
	Total Depth _____
	PRODUCTION
	1st 24 hrs. Nat. _____
	1st 24 hrs. after shot _____
	Gas _____ Cu. Ft.
	Dry Hole _____
	Abandoned _____

Date 7/27, 1918 Cardiff Scout

Map No. _____ Sec. 1 Twp. 26 R. 4Well No. 5 Palston Farm __________Evergreen Company _____

NORTH

WEST

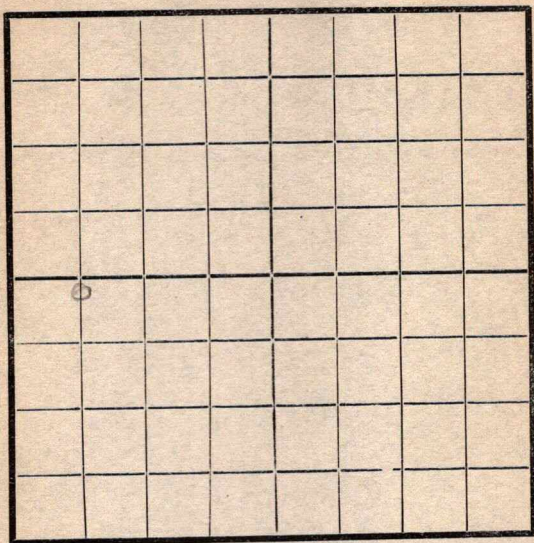

EAST

SOUTH

Location _____

Rig Up _____

Drilling and remarks

22 1435

RECORD

Cased _____ in. _____ Ft.

Sand _____

Gas _____

Oil _____

Total Depth _____

PRODUCTION

1st 24 hrs. Nat. _____

1st 24 hrs. after shot _____

Gas _____ Cu. Ft.

Dry Hole _____


Abandoned _____

Date

3/6, 1918 Condit Scout _____

Map No. _____ Sec. 1 Twp. 26 R. 4
 Well No. 5 Ralston Farm _____
Engine Company _____
 NORTH

WEST

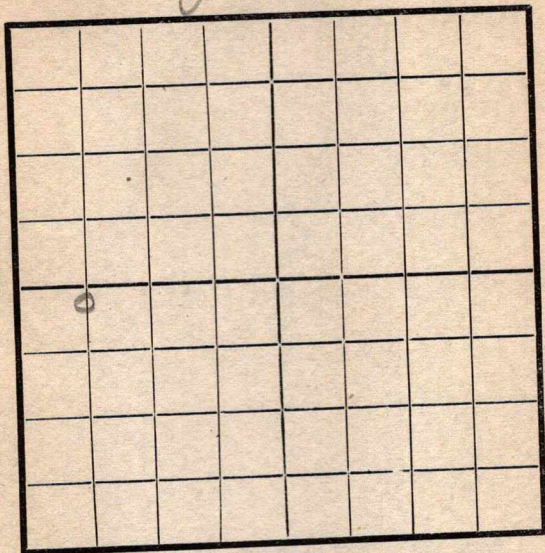

EAST

SOUTH

Location _____
 Rig Up _____
 Drilling and remarks

1435

RECORD

Cased _____ in. _____ Ft.
 Sand _____
 Gas _____
 Oil _____
 Total Depth _____

PRODUCTION

1st 24 hrs. Nat. _____
 1st 24 hrs. after shot _____
 Gas _____ Cu. Ft.
 Dry Hole _____
 Abandoned _____

Date

3/13, 1918 Scout

Map No. _____ Sec. 1 Twp. 26 R. 4Well No. 51 Ralston Farm _____Cumprine Company _____

NORTH

WEST

EAST

SOUTH

Location _____

Rig Up _____

Drilling and remarks

DD 1435

RECORD

Cased _____ in. _____ Ft.

Sand _____

Gas _____

Oil _____

Total Depth _____

PRODUCTION

1st 24 hrs. Nat. _____

1st 24 hrs. after shot _____

Gas _____ Cu. Ft.

Dry Hole _____

Abandoned _____

Date

3/20, 1911 J. C. Cady Scout _____

Map No. _____ Sec. 1 Twp. 26 R. 4Well No. 51 Balston Farm __________Cambridge Company

NORTH

WEST

EAST

SOUTH

Location _____

Rig Up _____

Drilling and remarks

1600

RECORD

Cased _____ in. _____ Ft.

Sand _____

Gas _____

Oil _____

Total Depth _____

PRODUCTION

1st 24 hrs. Nat. _____

1st 24 hrs. after shot _____

Gas _____ Cu. Ft.

Dry Hole _____

Abandoned _____

Date


3/27, 1918 Cambridge Scout

Map No. _____ Sec. 1 Twp. 26 R. 4

Well No. 5 Palstan

Empire Company

NORTH

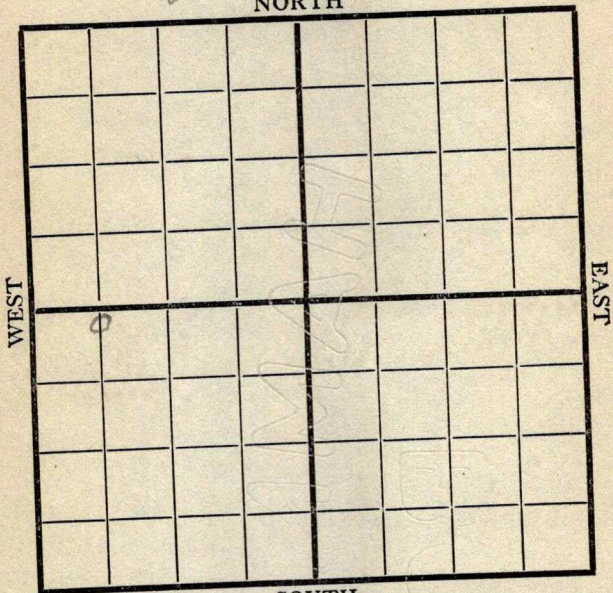

SOUTH

Location _____
Rig up _____
Drilling and Remarks:

1970

RECORD

Cased _____ in., _____ ft.
Sand _____
Gas _____
Oil _____
Total Depth _____

PRODUCTION

1st 24 hrs. Nat. _____
1st 24 hrs. after shot _____
Gas _____ Cu. Ft.
Dry Hole _____
Abandoned _____

Date
APR 3 1918


191

Carley Scout

Map No. _____ Sec. 1 Twp. 26 R. 4Well No. 5 Palston Farm __________Empire Company

NORTH

WEST

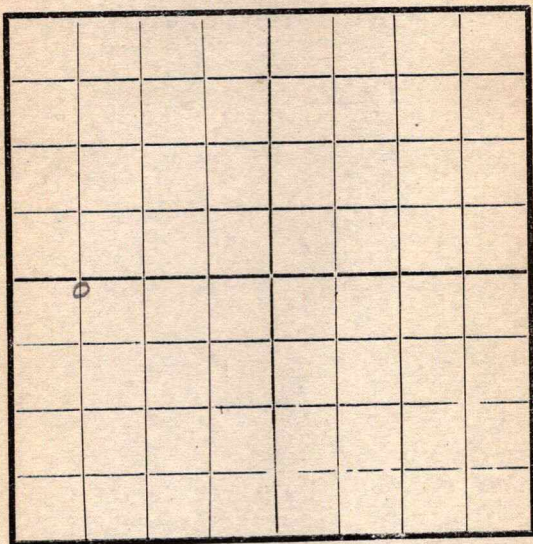

EAST

SOUTH

Location _____

Rig Up _____

Drilling and remarks

2100

RECORD

Cased _____ in _____ Ft.

Sand _____

Gas _____

Oil _____

Total Depth _____

PRODUCTION

1st 24 hrs. Nat. _____

1st 24 hrs. after shot _____

Gas _____ Cu. Ft.

Dry Hole _____

Abandoned _____

Date

APR 18 1918

_____, 191_____

Condy Scout

Map No. _____ Sec. 1 Twp. 26 R. 4Well No. 58 Ralston Farm __________Empire Company _____

NORTH

WEST

EAST

SOUTH

Location _____

Rig Up _____

Drilling and remarks

RECORD

Cased _____ in. _____ Ft.

Sand _____

Gas _____

Oil _____

Total Depth _____

PRODUCTION

1st 24 hrs. Nat. _____

1st 24 hrs. after shot _____

Gas _____ Cu. Ft.

Dry Hole _____

Abandoned _____


Date

4/17, 1918 _____ Scout Conley

Map No. K14 Sec. 1 Twp. 26 R. 4Well No. 57 Palston FarmCompany Company

NORTH

WEST

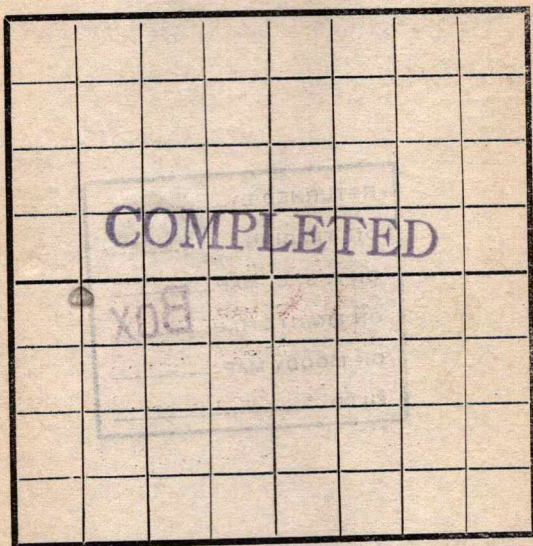

EAST

SOUTH

RECORD

Location -----

Rig Up -----

Drilling and remarks

Cased ----- in. ----- Ft.

Sand 2385-2425

Gas -----

Oil -----

Total Depth -----

PRODUCTION

1st 24 hrs. Nat. -----

1st 24 hrs. after shot -----

Gas ----- Cu. Ft.

Dry Hole -----

Abandoned -----

Date

4/25-8 191 Conley Scout