


Map No. _____ Sec. 8 Twp. 23 R. 4
 Well No. 2 Eggestone Farm
North Ref Company

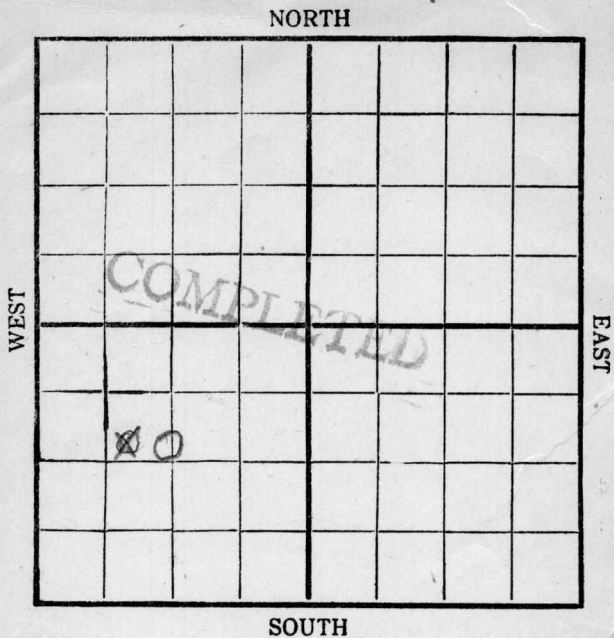

Location _____

Drilling Remarks:

8-16-19

Sand 2404' - 2423'
flowing 700 bbls per day

Rig Up _____

Drilling Remarks:

RECORD

Cased _____ in. _____ ft.

Sand _____

Gas _____

Oil _____

Total Depth _____

PRODUCTION

1st 24 hrs. Nat. _____

1st 24 hrs. after shot _____

Gas _____ cu. ft.

Dry Hole _____

Abandoned _____

Map No. K14 Sec. 8 Twp. 23 R. 4

Well No. 3 Eyestone


National Ref. Company

Contractor

NORTH

WEST

EAST

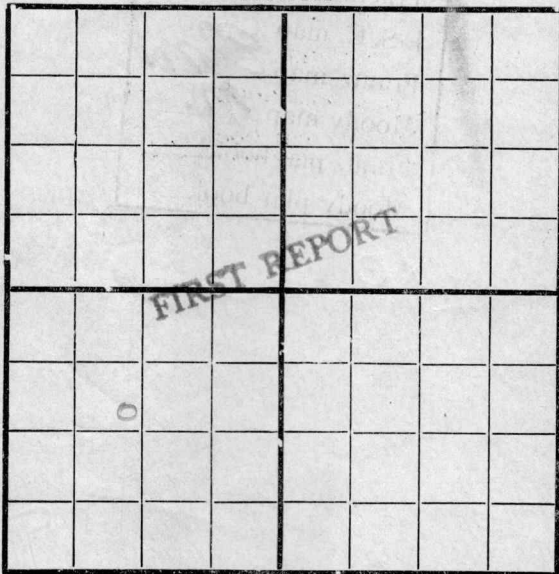

SOUTH

1120 N-W

Location _____

Rig up _____

Drilling and Remarks:

Timbers

RECORD

Cased _____ in., _____ ft.

Sand _____

Gas _____

Oil _____

Total Depth _____

PRODUCTION

1st 24 hrs. Nat. _____

1st 24 hrs. after shot _____

Gas _____ Cu. Ft.

Dry Hole _____

Abandoned _____


Date

Pyle

6/7 1919

Sco

Map No. K14 Sec. 8 Twp. 23 R. 4
Well No. 3 Eyestone
National Ref. Company
Contractor

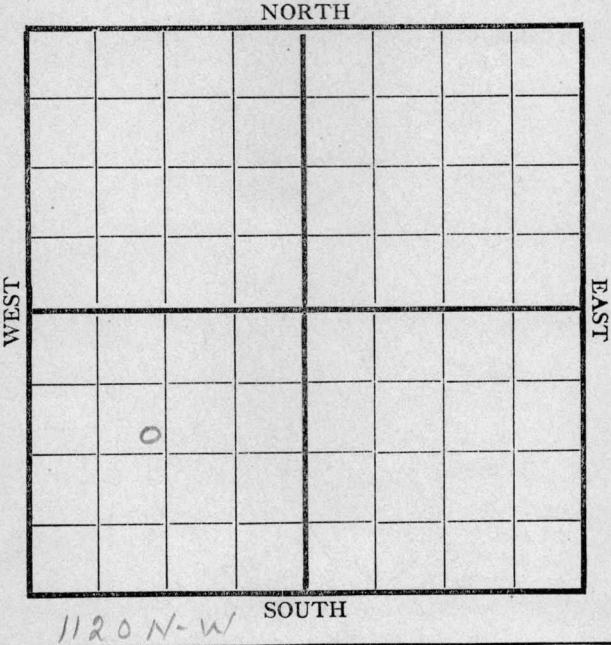

Location _____ Rig up ☒ _____ Drilling and Remarks:	RECORD
	Cased _____ in., _____ ft. Sand _____ Gas _____ Oil _____ Total Depth _____
	PRODUCTION
	1st 24 hrs. Nat. _____ 1st 24 hrs. after shot _____ Gas _____ Cu. Ft. Dry Hole _____ Abandoned _____

Date 6/14 1919 Pyle Scout

Map No. _____ Sec. 8 Twp. 23 R. 4Well No. 3 EyestoneNorth Ref. Company _____

Contractor _____

SECTION PLAT

1120 Ft. from N. Line

_____ Ft. from S. Line

_____ Ft. from E. Line

1120 Ft. from W. Line

Location _____

Rig up _____

Drilling and Remarks:

Rig up
6/14

RECORD

Cased _____ in., _____ ft.

Sand _____

Gas _____

Oil _____

Total Depth _____

PRODUCTION

1st 24 hrs. Nat. _____

1st 24 hrs. after shot _____

Gas _____ Cu. Ft.

Dry Hole _____

Abandoned _____

Date


6/21 1919 Office Scout

Map No. K14 Sec. 8 Twp. 23 R. 4
 Well No. 3 Eyestone
National Ref. Company
 Contractor

NORTH

WEST

EAST

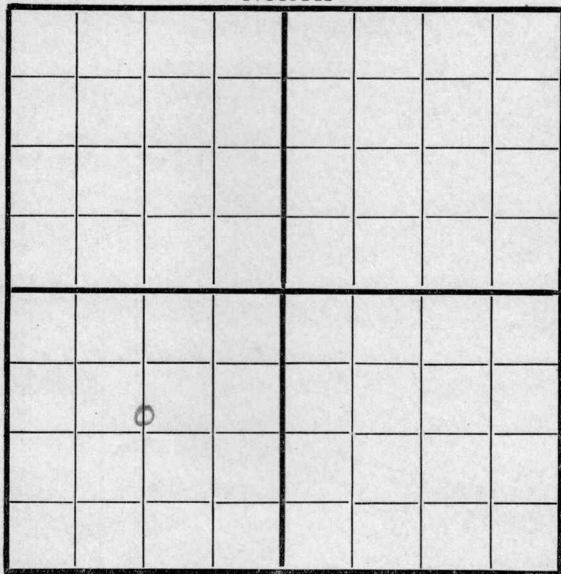

1320 W

SOUTH

1120 N

Location _____

Rig up _____

Drilling and Remarks:

Spud ding

Elev. 1367'

RECORD

Cased _____ in., _____ ft.

Sand _____

Gas _____

Oil _____

Total Depth _____

PRODUCTION

1st 24 hrs. Nat. _____

1st 24 hrs. after shot _____

Gas _____ Cu. Ft.

Dry Hole _____

Abandoned _____

Date

4/28 1919

Gyle Scout


Map No. K14 Sec. 8 Twp. 23 R. 4Well No. 3 EyestoneNational Ref Company

Contractor

NORTH

WEST

EAST

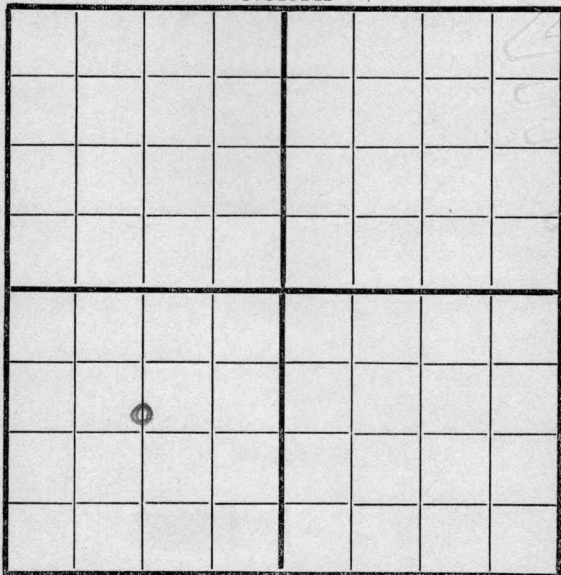

SOUTH

1120 N1320 W

Location _____

Rig up _____

Drilling and Remarks:

400'

RECORD

Cased _____ in., _____ ft.

Sand _____

Gas _____

Oil _____

Total Depth _____

PRODUCTION

1st 24 hrs. Nat. _____

1st 24 hrs. after shot _____

Gas _____ Cu. Ft.

Dry Hole _____

Abandoned _____

Date

7/1 1919 Pyke Scout


Map No. K14 Sec. 8 Twp. 23 R. 4Well No. 3 EyestoneNational Ref Company

Contractor

NORTH

WEST

EAST

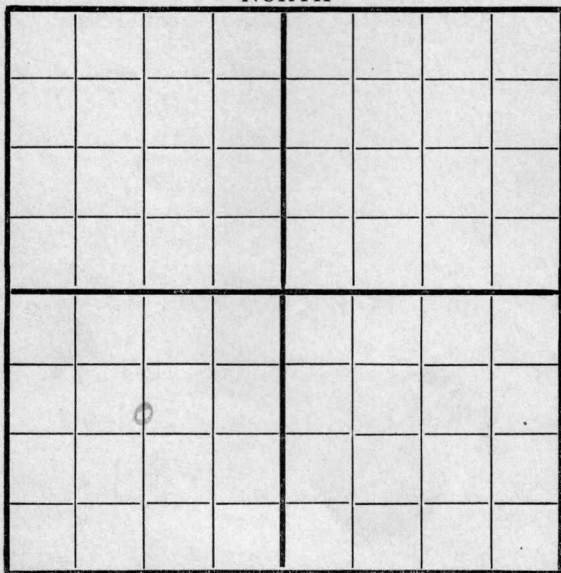

1320 W SOUTH

1120 N

Location _____

Rig up _____

Drilling and Remarks:

1000'

RECORD

Cased _____ in., _____ ft.

Sand _____

Gas _____

Oil _____

Total Depth _____

PRODUCTION

1st 24 hrs. Nat. _____

1st 24 hrs. after shot _____

Gas _____ Cu. Ft.

Dry Hole _____


Abandoned _____

Date

7/12 1919

Pyle Scout

Map No. K14 Sec. 8 Twp. 23 R. 4
Well No. 3 Eyestone
National Ref Company
Contractor

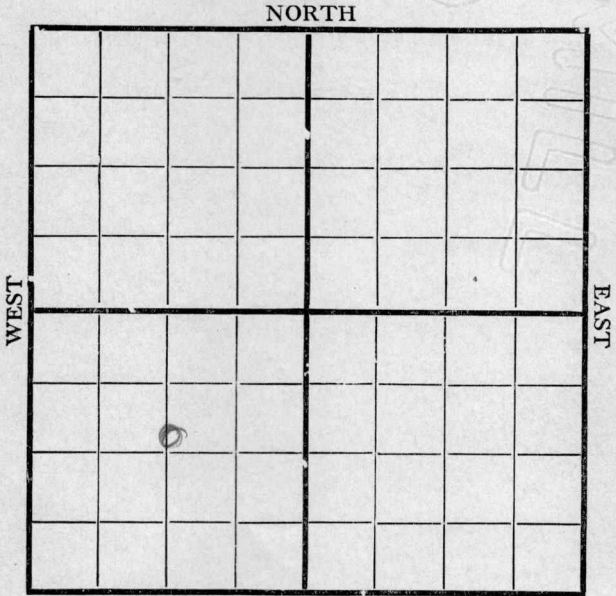

1320 W SOUTH 1120 N

Location _____
Rig up _____
Drilling and Remarks:

1860'

RECORD

Cased _____ in., _____ ft.
Sand _____
Gas _____
Oil _____
Total Depth _____

PRODUCTION

1st 24 hrs. Nat. _____
1st 24 hrs. after shot _____
Gas _____ Cu. Ft.
Dry Hole _____
Abandoned _____

Date 7/16 1919 Pyle Scout

Map No. K14 Sec. 8 Twp. 23 R. 4


Well No. 3 Eyestone
National Ref Company

Contractor

NORTH

WEST

EAST

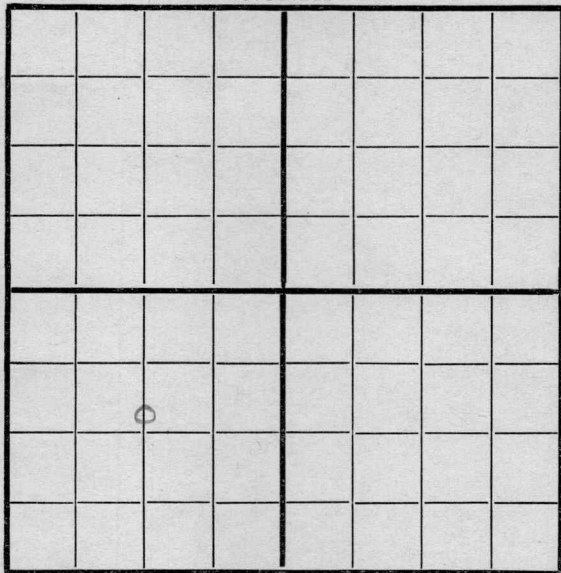

SOUTH

1320 W

200 S

Location _____

Rig up _____

Drilling and Remarks:

2140'

RECORD

Cased _____ in., _____ ft.

Sand _____

Gas _____

Oil _____

Total Depth _____

PRODUCTION

1st 24 hrs. Nat. _____

1st 24 hrs. after shot _____

Gas _____ Cu. Ft.

Dry Hole _____

Abandoned _____

Date


7/25 1919 Pyh Scout

Map No. K14 Sec. 8 Twp. 23 R. 4
 Well No. 3 Epestone
National Ref Company
 Contractor

NORTH

WEST

EAST

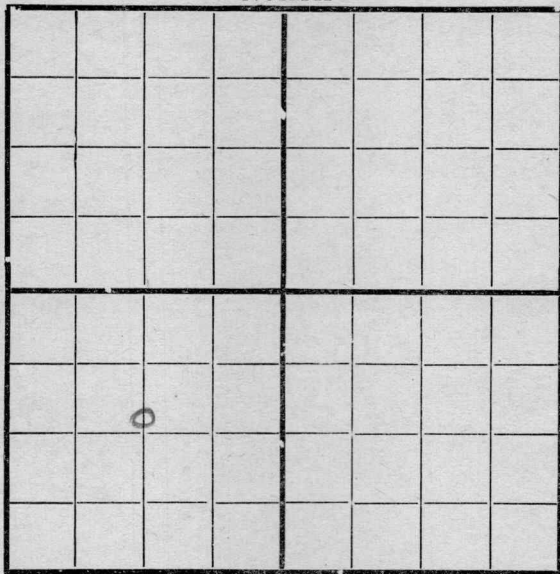

1320 W SOUTH

1120 E

Location _____

Rig up _____

Drilling and Remarks:

flowing
48 bbls
per hour

RECORD

Cased _____ in., _____ ft.

Sand 2404 - 2423

Gas _____

Oil _____

Total Depth _____

PRODUCTION

1st 24 hrs. Nat. _____

1st 24 hrs. after shot _____

Gas _____ Cu. Ft.

Dry Hole _____

Abandoned _____

Date

7/29 1919

Pyle


Scout

Map No. K14 Sec. 8 Twp. 23 R. 4Well No. 3 Eyestone FarmNational Ref Company

NORTH

WEST

EAST

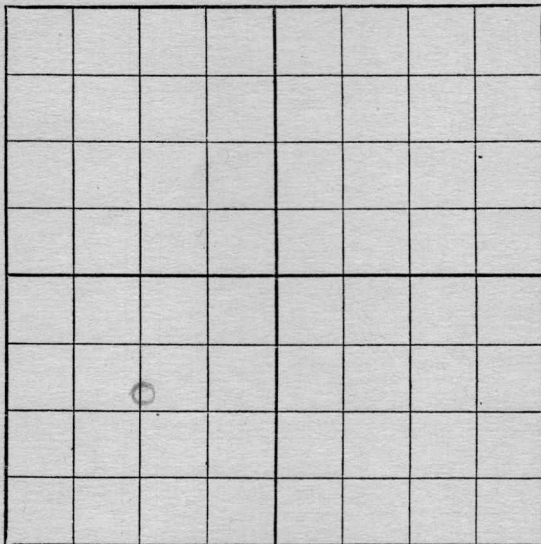

1320 W SOUTH

1120 N

Location

Rig up

Drilling and Remarks:

Swabbing
about 50 bbls
per hour

RECORD

Cased in. Ft.

Sand 2404-2423

Gas

Oil

Total Depth

PRODUCTION

1st 24 hrs. Nat.

1st 24 hrs. after shot

Gas Cu. Ft.

Dry Hole

Abandoned

Date

8/4, 1919, Oyle Scout


Map No. K14 Sec. 8 Twp. 23 R. 4Well No. 3 EyestoneNational Ref. Company

Contractor

NORTH

WEST

EAST

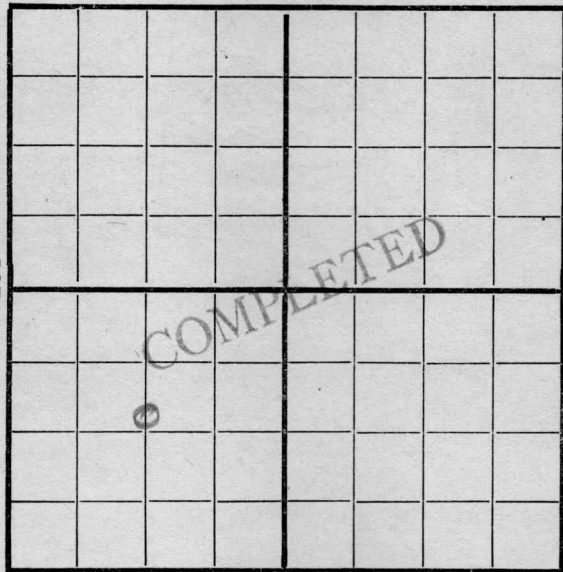

1320 W

SOUTH

1120 N

Location _____

Rig up _____

Drilling and Remarks:

flowing
700 bbls
per day

RECORD

Cased _____ in. _____ ft.

Sand 2404-2423

Gas _____

Oil _____

Total Depth _____

PRODUCTION

1st 24 hrs. Nat. _____

1st 24 hrs. after shot _____

Gas _____ Cu. Ft.

Dry Hole _____

Abandoned _____

Date

8/11 1919Cy h

Scout