


Map No. _____ Sec. 8 Twp. 23 R. 24
 Well No. 4 Eyestone Farm
National Ref Company

NORTH

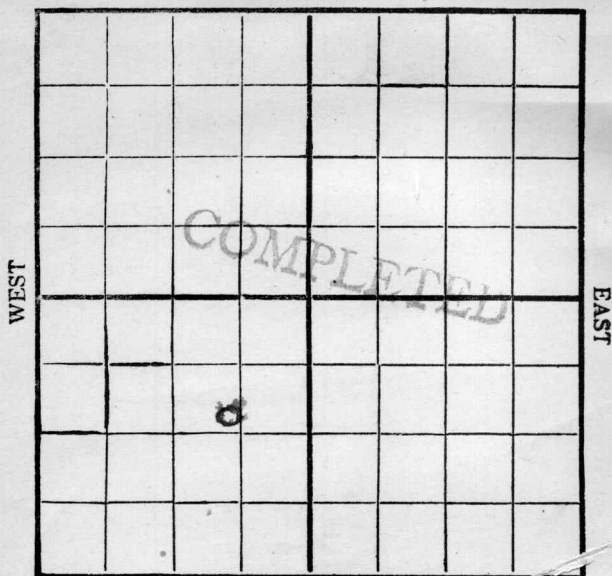

SOUTH

Location _____

Rig Up _____

Drilling Remarks:

Drilling Remarks:

8-16-19

Sand 2419' - 2427 1/2
1000 lbs

Oil 2420' - 2427 1/2

RECORD

Cased _____ in. _____ ft.

Sand _____

Gas _____

Oil _____

Total Depth _____

PRODUCTION

1st 24 hrs. Nat. _____

1st 24 hrs. after shot _____

Gas _____ cu. ft.

Dry Hole _____

Abandoned _____


Map No. K14 Sec. 8 Twp. 23 R. 4Well No. 4 EyestoneNational Ref. Company

Contractor

NORTH

WEST

EAST

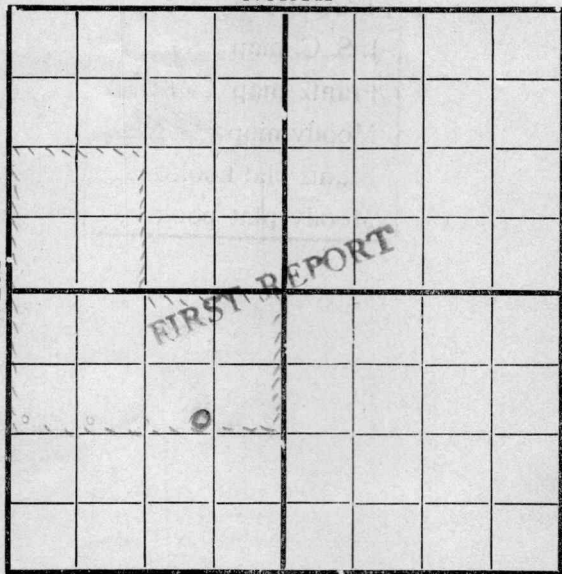

SOUTH

Location _____

Rig up _____

Drilling and Remarks:

Timber

RECORD

Cased _____ in., _____ ft.

Sand _____

Gas _____

Oil _____

Total Depth _____

PRODUCTION

1st 24 hrs. Nat. _____

1st 24 hrs. after shot _____

Gas _____ Cu. Ft.

Dry Hole _____

Abandoned _____

Date


6/17 1919Cyle Scout

Map No. K14 Sec. 8 Twp. 23 R. 4
 Well No. 4 Exystone
National Ref Company
 Contractor

NORTH

WEST

EAST

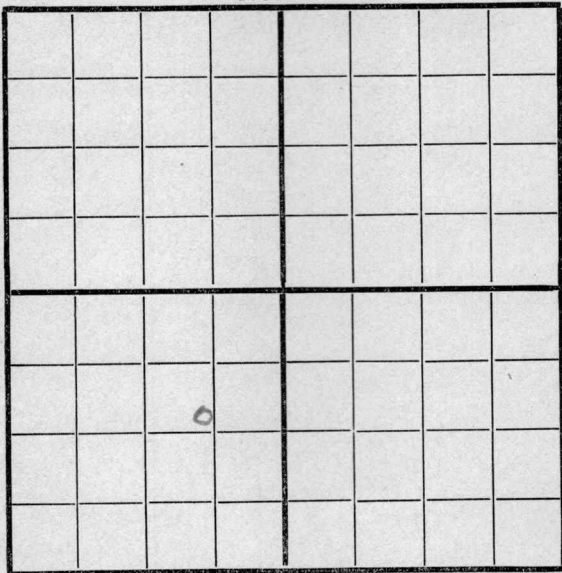

760 E SOUTH

1120 N

Location _____

Rig up _____

Drilling and Remarks:

Rig in up

Elev 1370

RECORD

Cased _____ in., _____ ft.

Sand _____

Gas _____

Oil _____

Total Depth _____

PRODUCTION

1st 24 hrs. Nat. _____

1st 24 hrs. after shot _____

Gas _____ Cu. Ft.

Dry Hole _____

Abandoned _____

Date


6/28

1919

Oyle

Scout

Map No. K 14 Sec. 8 Twp. 23 R. 4
 Well No. 4 Eyestone
National Ref Company
 Contractor

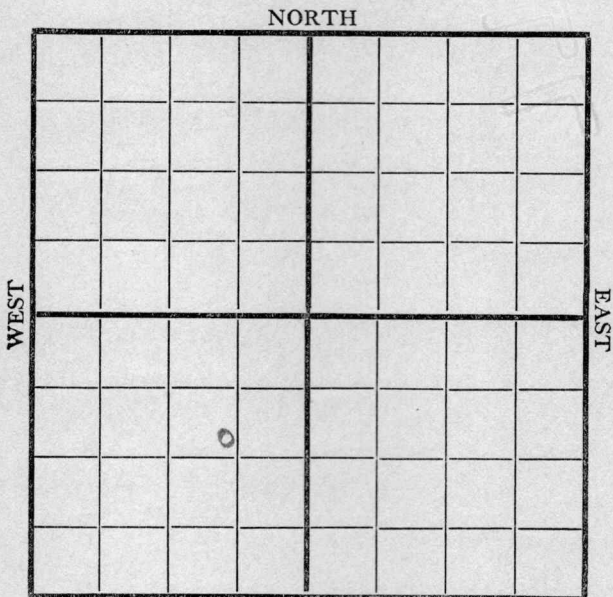

760 E

1120 N

RECORD

Location _____

Cased _____ in., _____ ft.

Rig up _____

Sand _____

Drilling and Remarks:

Gas _____

Oil _____

Total Depth _____

PRODUCTION

1st 24 hrs. Nat. _____

1st 24 hrs. after shot _____

Gas _____ Cu. Ft.

Dry Hole _____

Abandoned _____

Date

7/1

1919

Oyle

Scout


Map No. K 14 Sec. 8 Twp. 23 R. 4Well No. 4 EyestoneNational Ref Company

Contractor

NORTH

WEST

EAST

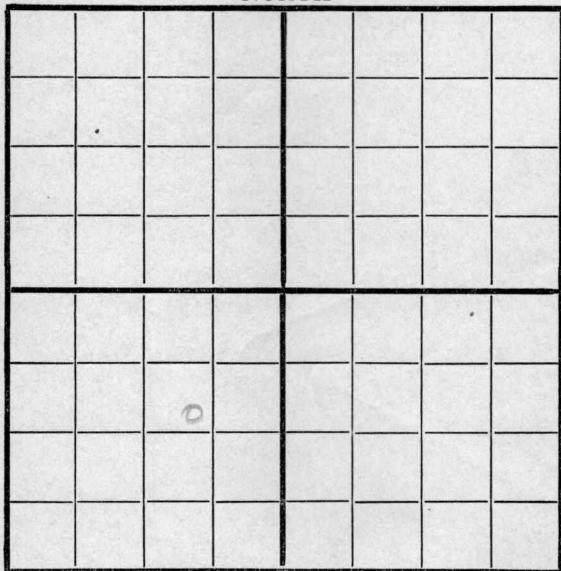

SOUTH

760 E

1120 W

Location _____

Rig up _____

Drilling and Remarks:

Rig n' up

RECORD

Cased _____ in., _____ ft.

Sand _____

Gas _____

Oil _____

Total Depth _____

PRODUCTION

1st 24 hrs. Nat. _____

1st 24 hrs. after shot _____

Gas _____ Cu. Ft.

Dry Hole _____

Abandoned _____

Date

7/12 1919Cyde

Scout


Map No. K14 Sec. 8 Twp. 23 R. 4Well No. 4 Eyestone
National Ref Company

Contractor

NORTH

WEST

EAST

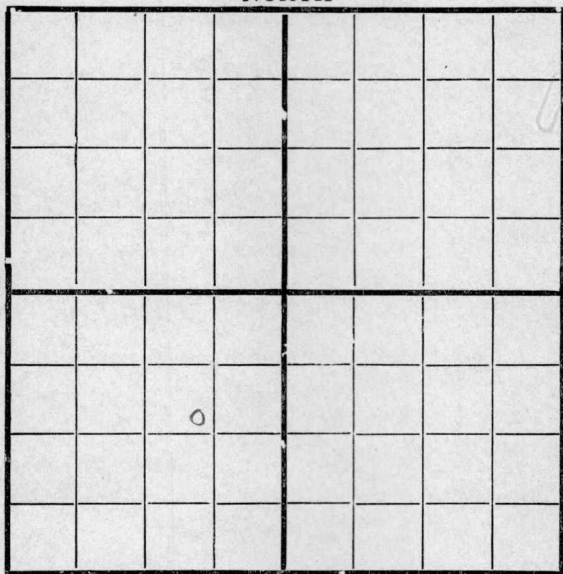

SOUTH

760 E

1120 N

Location _____

Rig up _____

Drilling and Remarks:

350'

RECORD

Cased _____ in., _____ ft.

Sand _____

Gas _____

Oil _____

Total Depth _____

PRODUCTION

1st 24 hrs. Nat. _____

1st 24 hrs. after shot _____

Gas _____ Cu. Ft.

Dry Hole _____

Abandoned _____

Date


7/16 1919 Pyle Scout

Map No. K16 Sec. 8 Twp. 23 R. 4
 Well No. 4 Eyestone
National Ref Company _____
 Contractor _____

NORTH

WEST

EAST

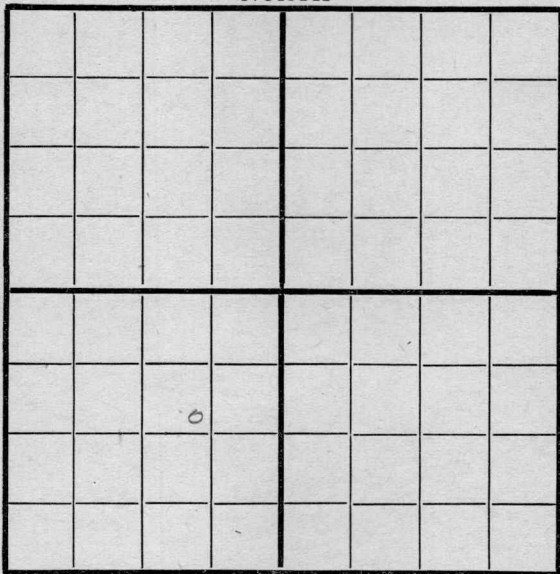

SOUTH

760 E

1120 N

Location _____

Rig up _____

Drilling and Remarks:

650'

RECORD

Cased _____ in., _____ ft.

Sand _____

Gas _____

Oil _____

Total Depth _____

PRODUCTION

1st 24 hrs. Nat. _____

1st 24 hrs. after shot _____

Gas _____ Cu. Ft.

Dry Hole _____

Abandoned _____

Date

7/25 1919 Pyle Scout


Map No. K14 Sec. 8 Twp. 23 R. 4Well No. 4 EyestoneNational Ref Company

Contractor

NORTH

WEST

EAST

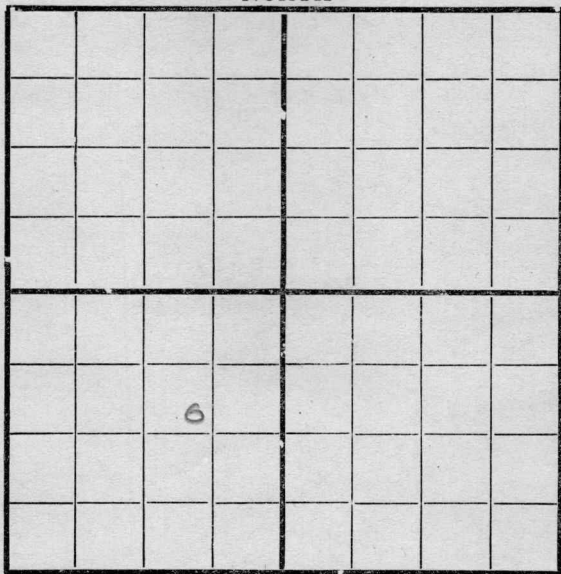

SOUTH

760 E1120 N

Location _____

Rig up _____

Drilling and Remarks:

1000'

RECORD

Cased _____ in., _____ ft.

Sand _____

Gas _____

Oil _____

Total Depth _____

PRODUCTION

1st 24 hrs. Nat. _____

1st 24 hrs. after shot _____

Gas _____ Cu. Ft.

Dry Hole _____

Abandoned _____


Date

7/29 1919 Chy W Scout

Map No. K14 Sec. 8 Twp. 23 R. 4Well No. 4 Eyestone FarmNational Company

NORTH

WEST

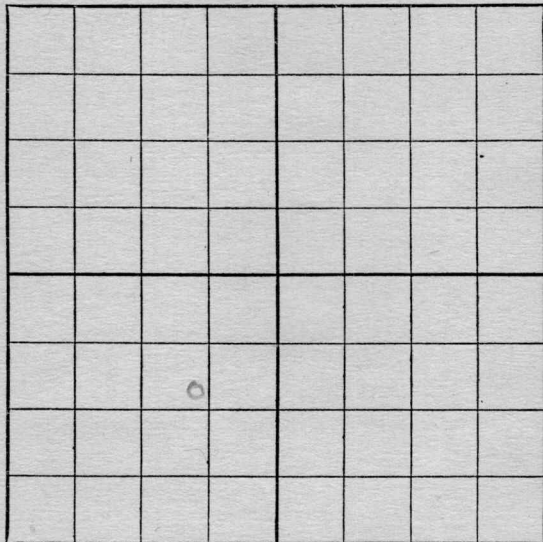

EAST

SOUTH

Location

Rig up

Drilling and Remarks:

RECORD

Cased in. Ft.

Sand

Gas

Oil

Total Depth

PRODUCTION

1st 24 hrs. Nat.

1st 24 hrs. after shot

Gas Cu. Ft.

Dry Hole

Abandoned

Date

8/4, 1919, Py a Scout


Map No. K 14 Sec. 8 Twp. 23 R. 4Well No. H Eyestone
National Ref Company

Contractor

NORTH

WEST

EAST

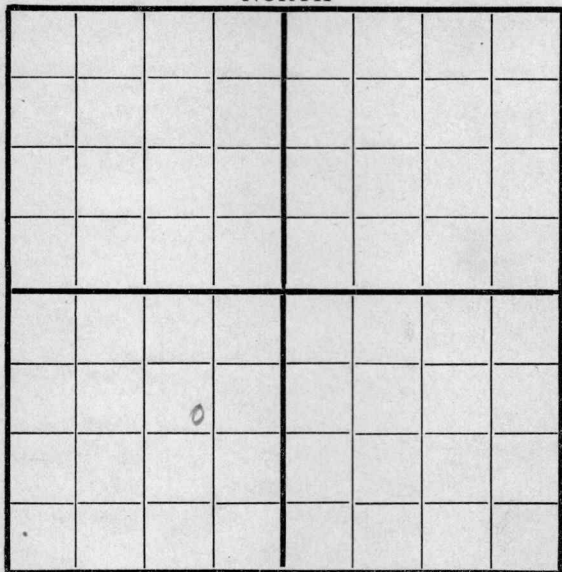

SOUTH

Location -----

Rig up -----

Drilling and Remarks:

2260'

RECORD

Cased ----- in., ----- ft.

Sand -----

Gas -----

Oil -----

Total Depth -----

PRODUCTION

1st 24 hrs. Nat. -----

1st 24 hrs. after shot -----

Gas ----- Cu. Ft.

Dry Hole -----

Abandoned -----

Date

8/

1919

Pyle

Scout

11

Map No. _____ Sec. 8 Twp. 23 R. 4

Well No. 4 Cyclone

National Ref. Company

Contractor

SECTION PLAT

1120 Ft. from N. Line

_____ Ft. from S. Line

760 Ft. from E. Line

_____ Ft. from W. Line

Location _____

Rig up _____

Drilling and Remarks:

July
2260'

8/6

RECORD

Cased _____ in., _____ ft.

Sand _____

Gas _____

Oil _____

Total Depth _____

PRODUCTION

1st 24 hrs. Nat. _____

1st 24 hrs. after shot _____

Gas _____ Cu. Ft.

Dry Hole _____

Abandoned _____

Date

8/23 1919 Officer Scout

Map No. K 14 Sec. 8 Twp. 23 R. 4
 Well No. 4 Eyestone
National Ref Company
 Contractor

NORTH

SOUTH

WEST

EAST

COMPLETED

760 E

1120 N

Location _____

Rig up _____

Drilling and Remarks:

RECORD

Cased _____ in., _____ ft.
 Sand 2419 - 2427 1/2
 Gas _____
 Oil 2420 - 2427 1/2
 Total Depth _____

PRODUCTION

1st 24 hrs. Nat. 1000 bbls
 1st 24 hrs. after shot _____
 Gas _____ Cu. Ft.
 Dry Hole _____
 Abandoned _____

Date

8/18

1919

Pyle

Scout