

Map No. _____ Sec. _____ Twp. 26 R. 4

Well No. 12 Ralston Farm _____

Empire Company _____

NORTH

WEST

EAST



SOUTH

Location _____

Rig Up _____

Drilling Remarks:

Drilling Remarks:

RECORD

PRODUCTION

Cased _____ in. _____ ft.

1st 24 hrs. Nat. _____

Sand _____

1st 24 hrs. after shot _____

Gas _____

Gas _____ cu. ft.

Oil _____

Dry Hole _____

Total Depth _____


Abandoned _____

Map No. K14 Sec. 1 Twp. 26 R. 4
Well No. 12 Polston Farm
Empire Company

NORTH

WEST

EAST

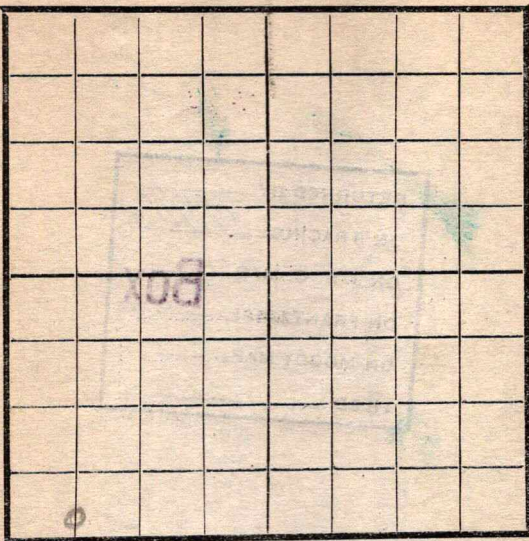

SOUTH

Location _____
Rig Up ☒ _____
Drilling and remarks _____

FIRST REPORT

RECORD

Cased _____ in _____ Ft
Sand _____
Gas _____
Oil _____
Total Depth _____

PRODUCTION

1st 24 hrs. Nat. _____
1st 24 hrs. after shot _____
Gas _____ Cu. Ft.
Dry Hole _____
Abandoned _____

Date 5/9, 1918 C. C. Cuddy Scout

Map No. _____ Sec. 1 Twp. 26 R. 4Well No. 12 Palatka Farm _____Company EmpireMarshall & Mc Ginnis - El Dorado, KS

NORTH

WEST

EAST

SOUTH

Location _____

Rig Up _____

Drilling and remarks

150

RECORD

Cased _____ in. _____ Ft.

Sand _____

Gas _____

Oil _____

Total Depth _____

PRODUCTION

1st 24 hrs. Nat. _____

1st 24 hrs. after shot _____

Gas _____ Cu. Ft.

Dry Hole _____

Abandoned _____

Date

6/19, 1918Scout [Signature]


Map No. _____ Sec. 1 Twp. 26 R. 4Well No. 12 RalstonE. M. M. Co. Company

Contractor

NORTH

WEST

EAST

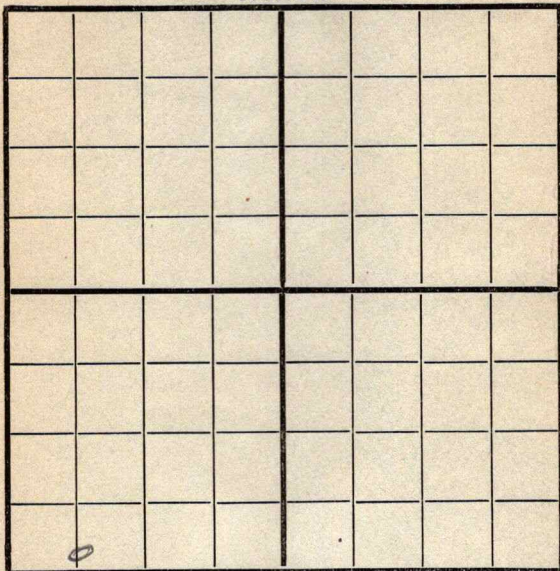

SOUTH

Location _____

Rig up _____

Drilling and Remarks:

920

RECORD

Cased _____ in., _____ ft.

Sand _____

Gas _____

Oil _____

Total Depth _____

PRODUCTION

1st 24 hrs. Nat. _____

1st 24 hrs. after shot _____

Gas _____ Cu. Ft.


Dry Hole _____

Abandoned _____

Date

6/26 1918 E. M. M. Co. Scout

Map No. _____ Sec. 1 Twp. 26 R. 4
Well No. 12 Polston
Empire Company _____
Contractor _____

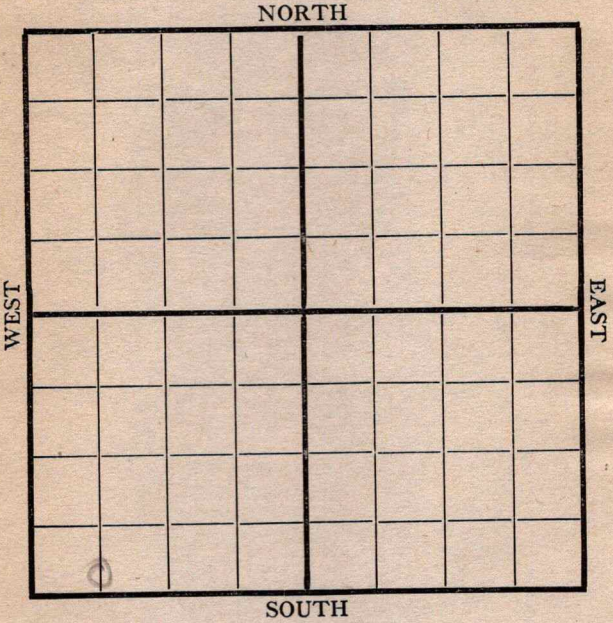


Location _____ Rig up _____ Drilling and Remarks: 1100	RECORD
	Cased _____ in., _____ ft.
	Sand _____
	Gas _____
	Oil _____
	Total Depth _____
	PRODUCTION
	1st 24 hrs. Nat. _____
	1st 24 hrs. after shot _____
	Gas _____ Cu. Ft.
	Dry Hole _____
	Abandoned _____

Date 7/3 1918 Scandey Scout

Map No. _____ Sec. 1 Twp. 26 R. 4
Well No. 12 Palston
Empire Company

Contractor

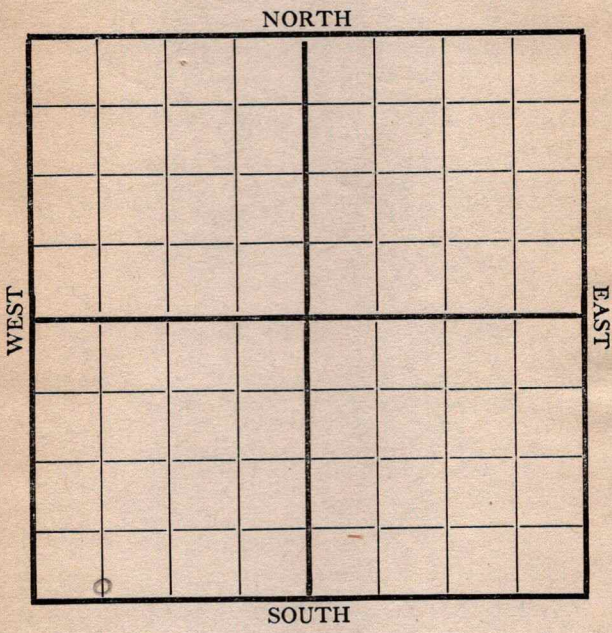

Location _____ Rig up _____ Drilling and Remarks: 1660	RECORD Cased _____ in., _____ ft. Sand _____ Gas _____ Oil _____ Total Depth _____ PRODUCTION 1st 24 hrs. Nat. _____ 1st 24 hrs. after shot _____ Gas _____ Cu. Ft. Dry Hole _____ Abandoned _____
--	--

Date 7/10 1918 S. Condy Scout

Map No. _____ Sec. 1 Twp. 26 R. 7

Well No. 12 Ralskan

Company

Contractor

NORTH

WEST

EAST

SOUTH

Location -----

Rig up-----

Drilling and Remarks:

Shut Down
1660

RECORD

Cased-----in., -----ft.

Sand-----

Gas

Oil _____

Total Depth.....

PRODUCTION

1st 24 hrs. Nat. -----

1st 24 hrs. after shot-----

Gas-----Cu. Ft.

Dry Hole.....

Abandoned.....

Date _____

7/17

191

Scout

Map No. _____ Sec. 1 Twp. 26 R. 4
 Well No. 12 Palston
 _____ Company
 _____ Contractor

NORTH								
WEST								EAST
SOUTH								

	RECORD
Location _____	Cased _____ in., _____ ft.
Rig up _____	Sand _____
Drilling and Remarks:	Gas _____
<u>1750</u>	Oil _____
	Total Depth _____
	PRODUCTION
	1st 24 hrs. Nat. _____
	1st 24 hrs. after shot _____
	Gas _____ Cu. Ft.
	Dry Hole _____
	Abandoned _____


Date 7/24 191 8 C. C. C. C. Scout

Map No. _____ Sec. 1 Twp. 26 R. 4
 Well No. 12 Palston
Empire Company
 Contractor _____

NORTH

WEST

EAST

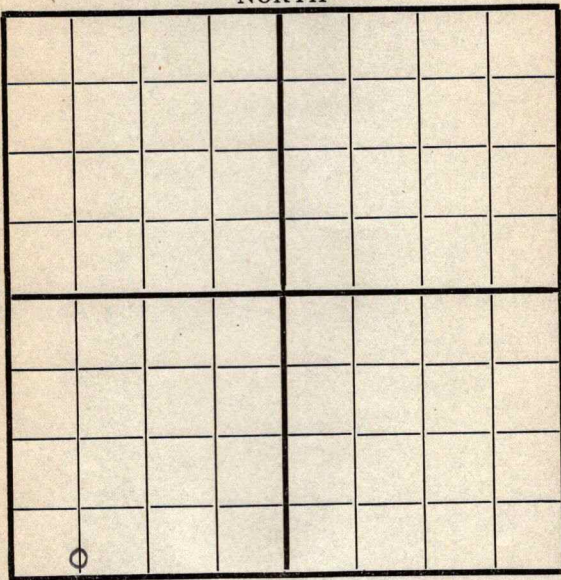

SOUTH

200' N. of S. Line = 660' E. of W. Line.

200'S - 660'W
 Location _____

Rig up _____

Drilling and Remarks:

1970'

RECORD

Cased _____ in., _____ ft.

Sand _____

Gas _____

Oil _____

Total Depth _____

PRODUCTION

1st 24 hrs. Nat. _____

1st 24 hrs. after shot _____

Gas _____ Cu. Ft.

Dry Hole _____

Abandoned _____

Date

7/31

191


Candy

Scout

Map No. _____ Sec. 1 Twp. 26 R. 4Well No. 12 Palston
E. Empire Company

Contractor

NORTH

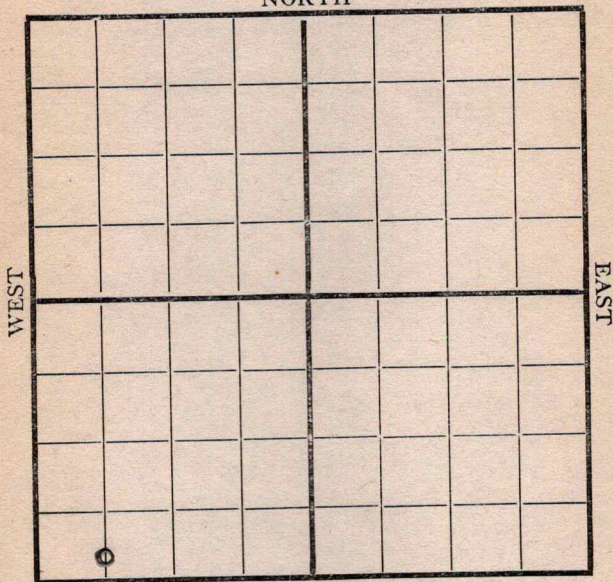

SOUTH

Location 2008 660 W

RECORD

Rig up _____

Drilling and Remarks:

Cased _____ in., _____ ft.

Sand _____

Gas _____

Oil _____

Total Depth _____

PRODUCTION

1st 24 hrs. Nat. _____

1st 24 hrs. after shot _____

Gas _____ Cu. Ft.

Dry Hole _____

Abandoned _____

Date

8/7


191

P. Conley

Scout

Map No. _____ Sec. 1 Twp. 26 R. 4Well No. 12 Palston_____Emery Company_____Emery Contractor

NORTH

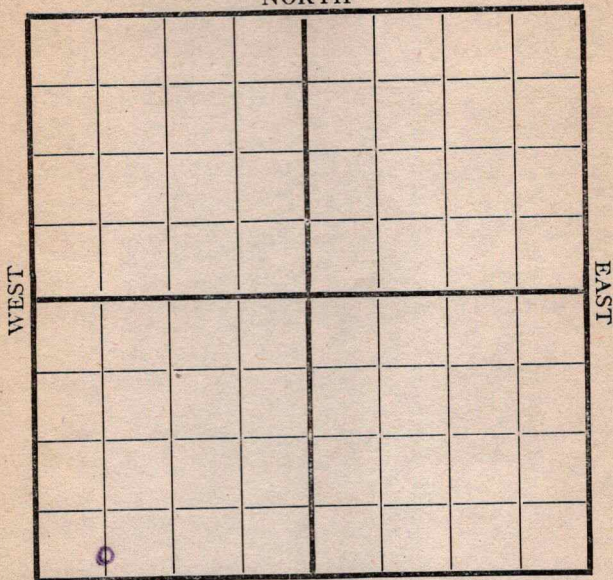

SOUTH

200 6
660 W

Location _____

Rig up _____

Drilling and Remarks:

J. D. 2347

1119 2367

RECORD

Cased _____ in., _____ ft.

Sand _____

Gas _____

Oil _____

Total Depth _____

PRODUCTION

1st 24 hrs. Nat. _____

1st 24 hrs. after shot _____

Gas _____ Cu. Ft.

Dry Hole _____

Abandoned _____


Date

8/15 1918 Oyle

Scout

Map No. K14 Sec. 1 Twp. 26 R. 4
 Well No. 12 Kilsten
Empire Company
 Contractor

NORTH

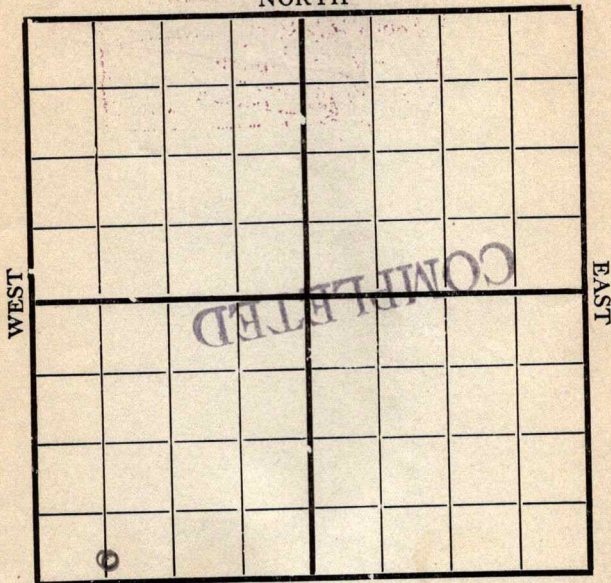

SOUTH

200' A - 66' W.

Location _____

Rig up _____

Drilling and Remarks:

RECORD

Cased _____ in., _____ ft.

Sand 2347-2390

Gas _____

Oil _____

Total Depth _____

PRODUCTION

1st 24 hrs. Nat. 2000 bbl

1st 24 hrs. after shot _____

Gas _____ Cu. Ft.

Dry Hole _____

Abandoned _____

Date

8/201918Gyle Scout