

Map No. _____ Sec. 8 Twp. 23 R. 4
Well No. 5 Eyestone _____ Farm
National Ref _____ Company

NORTH

WEST

EAST

SOUTH

Location -----

Rig Up -----

Drilling Remarks:

Drilling Remarks:

RECORD

PROLUTION

Cased_____in. _____ft.

1st 24 hrs. Nat.-----

Sand -----

1st 24 hrs. after shot.-----

Gas -----

Gas-----cu. ft.

Oil_____

Dry Hole -----

Total Depth -----

Abandoned -----


Map No. K14 Sec. 8 Twp. 23 R. 4Well No. 5 EyestoneNational Ref. Company

Contractor

NORTH

WEST

EAST

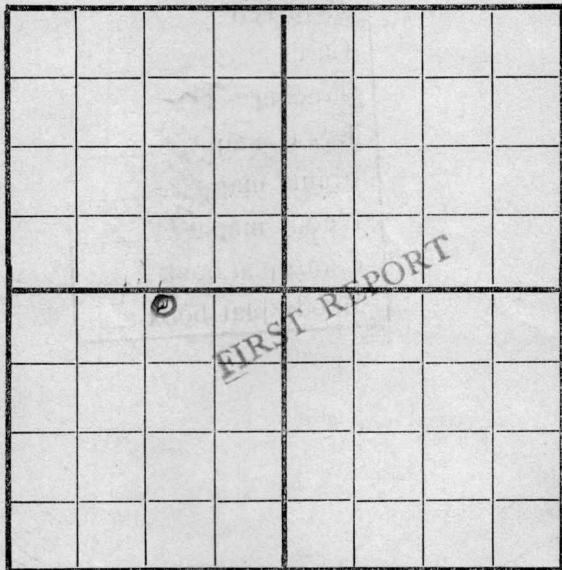

1120 E

SOUTH

200 N

Location _____

Rig up ☒ _____

Drilling and Remarks:

RECORD

Cased _____ in., _____ ft.

Sand _____

Gas _____

Oil _____

Total Depth _____

PRODUCTION

1st 24 hrs. Nat. _____

1st 24 hrs. after shot _____

Gas _____ Cu. Ft.

Dry Hole _____

Abandoned _____

Date

7/11

191

9

Pyle

Scout


Map No. 1514 Sec. 8 Twp. 23 R. 4Well No. 5 EgyptoneNational Ref Company

Contractor

NORTH

WEST

EAST

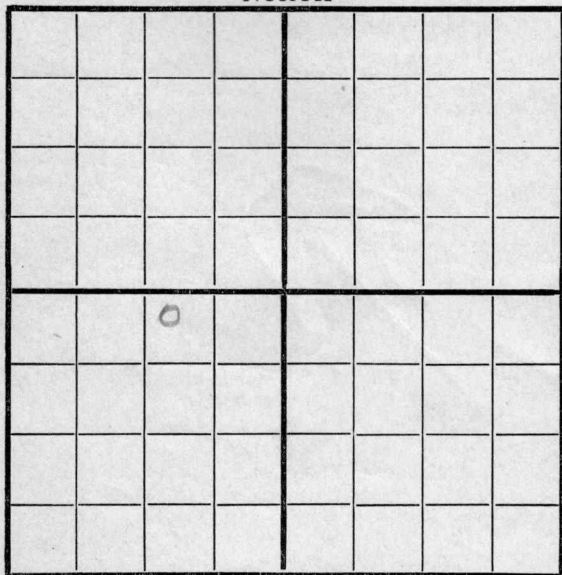

SOUTH

Location _____

Rig up _____

Drilling and Remarks:

Spud

RECORD

Cased _____ in., _____ ft.

Sand _____

Gas _____

Oil _____

Total Depth _____

PRODUCTION

1st 24 hrs. Nat. _____

1st 24 hrs. after shot _____

Gas _____ Cu. Ft.

Dry Hole _____

Abandoned _____

Date


7/12 1919 Cyle Scout

Map No. H14 Sec. 8 Twp. 23 R. 4
 Well No. 5 Eyestone
National Ref Company
 Contractor

NORTH

WEST

EAST

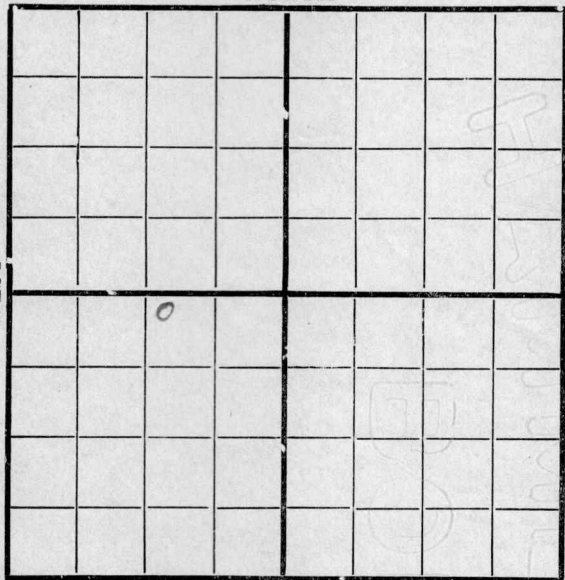

200 N

SOUTH

1120 E

Location _____

Rig up _____

Drilling and Remarks:

550

RECORD

Cased _____ in., _____ ft.

Sand _____

Gas _____

Oil _____

Total Depth _____

PRODUCTION

1st 24 hrs. Nat. _____

1st 24 hrs. after shot _____

Gas _____ Cu. Ft.

Dry Hole _____

Abandoned _____

Date

7/16 1919

Payle Scout

Map No. K14 Sec. 8 Twp. 23 R. 4


Well No. 5 Eyestone
National Ref Company

Contractor

NORTH

WEST

EAST

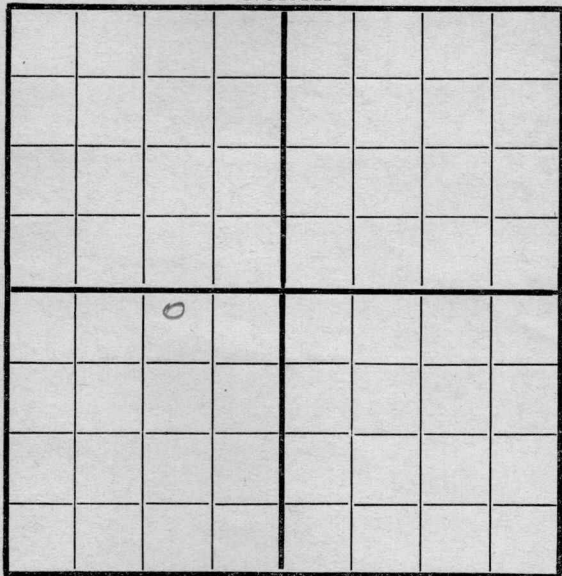

SOUTH

200 N

1120 E

Location _____

Rig up _____

Drilling and Remarks:

900'

RECORD

Cased _____ in., _____ ft.

Sand _____

Gas _____

Oil _____

Total Depth _____

PRODUCTION

1st 24 hrs. Nat. _____

1st 24 hrs. after shot _____

Gas _____ Cu. Ft.

Dry Hole _____

Abandoned _____

Date

7/1 1919


Oyke

Scout

125

Map No. K 14 Sec. 8 Twp. 23 R. 4
 Well No. 5 Eyestone
National Ref Company
 Contractor

NORTH

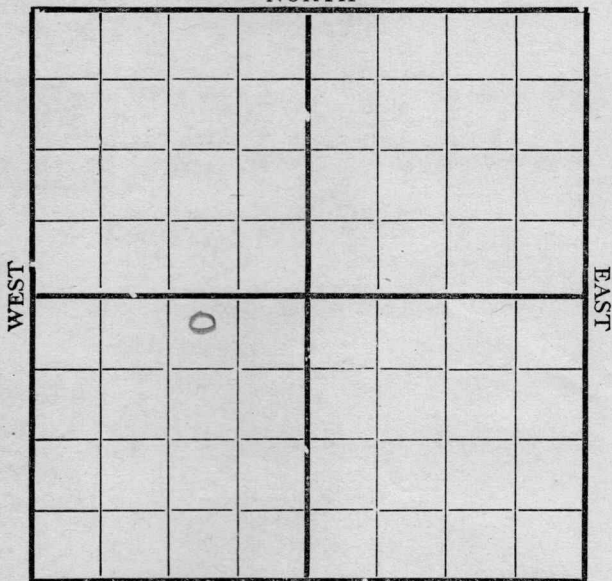

200 N

SOUTH

1120 E

Location _____

Rig up _____

Drilling and Remarks:

1200'

RECORD

Cased _____ in., _____ ft.

Sand _____

Gas _____

Oil _____

Total Depth _____

PRODUCTION

1st 24 hrs. Nat. _____

1st 24 hrs. after shot _____

Gas _____ Cu. Ft.

Dry Hole _____

Abandoned _____


Date

7/29 1919 Ly L Scout

Map No. K14 Sec. 8 Twp. 23 R. 4
 Well No. 5 Eyestone Farm
Matronal Company

NORTH

WEST

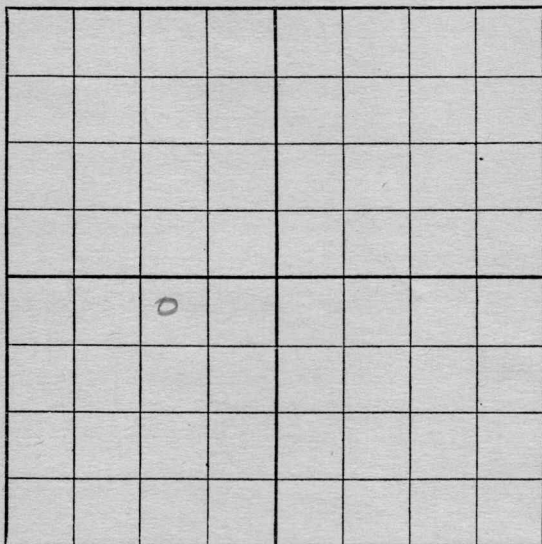

EAST

200 N

SOUTH

1120 E

Location

Rig up

Drilling and Remarks:

1540'

RECORD

Cased in. Ft.

Sand

Gas

Oil

Total Depth

PRODUCTION

1st 24 hrs. Nat.

1st 24 hrs. after shot

Gas Cu. Ft.

Dry Hole

Abandoned

Date

8/4, 1919, Pyle Scout


Map No. K 14 Sec. 8 Twp. 23 R. 4Well No. 5 EyestoneNational Ref. _____ Company _____

Contractor _____

NORTH

WEST

EAST

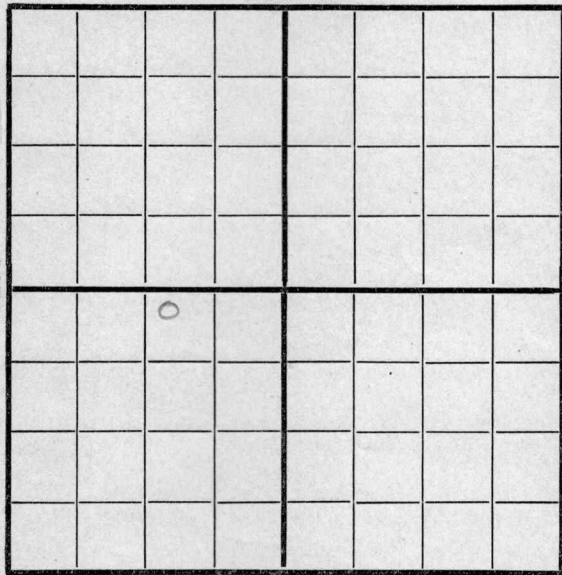

SOUTH

200 N

1120 E

Location _____

Rig up _____

Drilling and Remarks:

8' 1/4 @ 1770'

RECORD

Cased _____ in., _____ ft.

Sand _____

Gas _____

Oil _____

Total Depth _____

PRODUCTION

1st 24 hrs. Nat. _____

1st 24 hrs. after shot _____

Gas _____ Cu. Ft.

Dry Hole _____

Abandoned _____

Date

8/11

1919


Pyle

Scout

Sec. 8 Twp. 23 Rge. 4
Owner National Ref
Farm Eyestone Well No. 5
Contractor _____

Feet from lines, N. 200 E. 1120 S. _____ W. _____

Casing used _____
15½ _____ ft.
12½ _____ ft.
10 _____ ft.
8¼ _____ ft.
6⅝ _____ ft.
5 3-16 _____ ft.

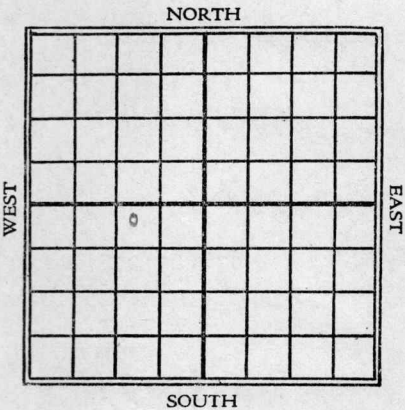

Location _____
Rig _____
Drilling at 2100 ft. Fishing at _____ ft.
Total Depth _____ Completed _____
1st 24 Hrs. Nat. _____ Producing _____
1st 24 Hrs. Shot _____ Dry Hole _____
Gas _____ Cu. ft. Abandoned _____
Sands — give name and depth. Top _____ Bottom _____

Date of Report 8/23
Reported by _____

Pyle

Map No. K14 Sec. 8 Twp. 23 R. 4
 Well No. 5 Eyestone
National Ref Company
 _____ Contractor

SECTION PLAT

200 Ft. from N. Line

_____ Ft. from S. Line

1120 Ft. from E. Line

_____ Ft. from W. Line

	0		

Location _____

Rig up _____

Drilling and Remarks:

Top Sand
2420
12 ft in
2300 ft oil
in hole

RECORD

Cased _____ in., _____ ft.

Sand _____

Gas _____

Oil _____

Total Depth _____

PRODUCTION

1st 24 hrs. Nat. _____

1st 24 hrs. after shot _____

Gas _____ Cu. Ft.

Dry Hole _____

Abandoned _____

Date

8/30 1919

Pyle

Scout

Map No. K14 Sec. 8 Twp. 23 R. 4Well No. 5 EggestoneNational Ref Company

Contractor

SECTION PLAT

200 Ft. from N. Line

Ft. from S. Line

1120 Ft. from E. Line

Ft. from W. Line

	0		

Location

Rig up

Drilling and Remarks:

2300 ft oil
in hole
will drill
deeper

RECORD

Cased _____ in., _____ ft.

Sand 2420-2432

Gas _____

Oil _____

Total Depth _____

PRODUCTION

1st 24 hrs. Nat. _____

1st 24 hrs. after shot _____

Gas _____ Cu. Ft.

Dry Hole _____

Abandoned _____

Date

9/2 1919

Pyle

Scout

Map No. K14 Sec. 8 Twp. 23 R. 4Well No. 5 EyestoneNational Ref Company

Contractor

SECTION PLAT

200 Ft. from N. Line

-----Ft. from S. Line

1120 Ft. from E. Line

-----Ft. from W. Line

	0		

Location -----

Rig up -----

Drilling and Remarks:

RECORD

Cased ----- in., ----- ft.

Sand 2420-2455

Gas -----

Oil -----

Total Depth -----

PRODUCTION

1st 24 hrs. Nat. 500 bbls

1st 24 hrs. after shot -----

Gas ----- Cu. Ft.

Dry Hole -----

Abandoned -----

Date

9/8 191 9

Pyle

Scout