


Map No. _____ Sec. 1 Twp. 26 R. 4
 Well No. 14 Calston Farm
Empire & Co Company

NORTH

WEST

EAST

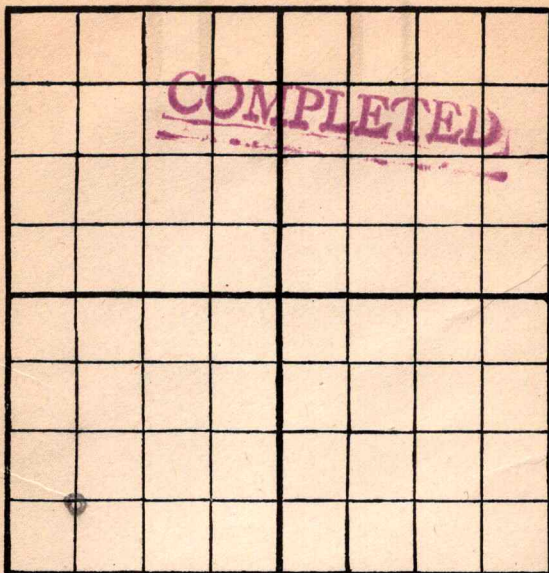

SOUTH

Location _____

Rig Up _____

Drilling Remarks:

Drilling Remarks:

RECORD

PRODUCTION

Cased _____ in. _____ ft.

1st 24 hrs. Nat. _____

Sand _____

1st 24 hrs. after shot _____

Gas _____

Gas _____ cu. ft.

Oil _____

Dry Hole _____


Total Depth _____

Abandoned _____

Map No. _____ Sec. 1 Twp. 26 R. 4Well No. 14 Polston Farm _____
Engine Company _____

NORTH

WEST

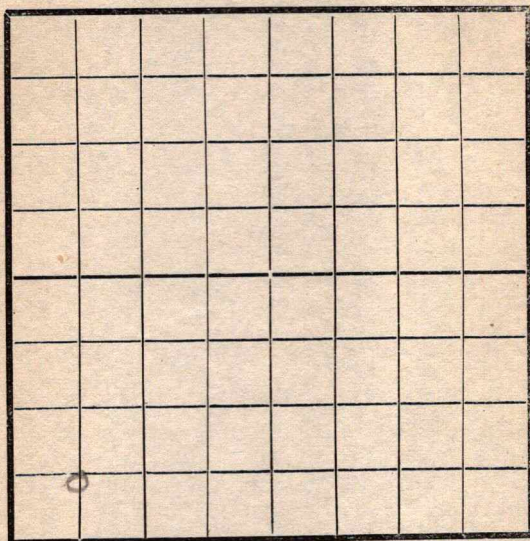

EAST

SOUTH

Location _____

Rig Up ☒ _____

Drilling and remarks _____

RECORD

Cased _____ in _____ Ft.

Sand _____

Gas _____

Oil _____

Total Depth _____

PRODUCTION

1st 24 hrs. Nat. _____

1st 24 hrs. after shot _____

Gas _____ Cu. Ft.

Dry Hole _____

Abandoned _____


Date _____

_____, 191____ Scout _____

Map No. _____ Sec. 1 Twp. 26 R. 4Well No. 14 Polston Farm __________
Empire Company

NORTH

WEST

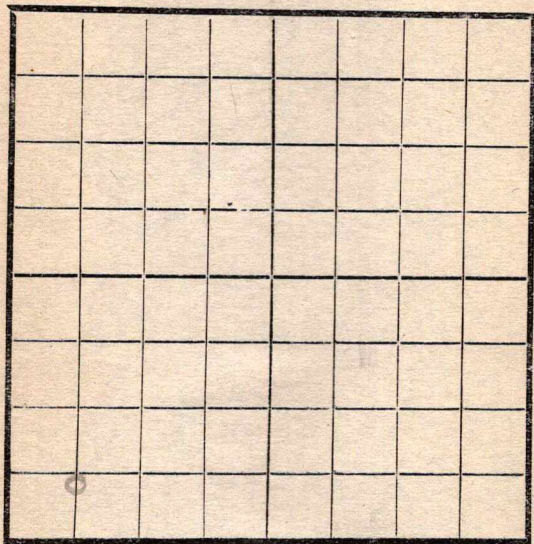

EAST

SOUTH

Location _____

Rig Up _____

Drilling and remarks

RECORD

Cased _____ in. _____ Ft.

Sand _____

Gas _____

Oil _____

Total Depth _____

PRODUCTION

1st 24 hrs. Nat. _____

1st 24 hrs. after shot _____

Gas _____ Cu. Ft.

Dry Hole _____


Abandoned _____

Date

July 29, 1911 S. Landry Scout

Map No. _____ Sec. 1 Twp. 26 R. 4
 Well No. 14 Palstan
E. Murphy Company
 Contractor _____

NORTH

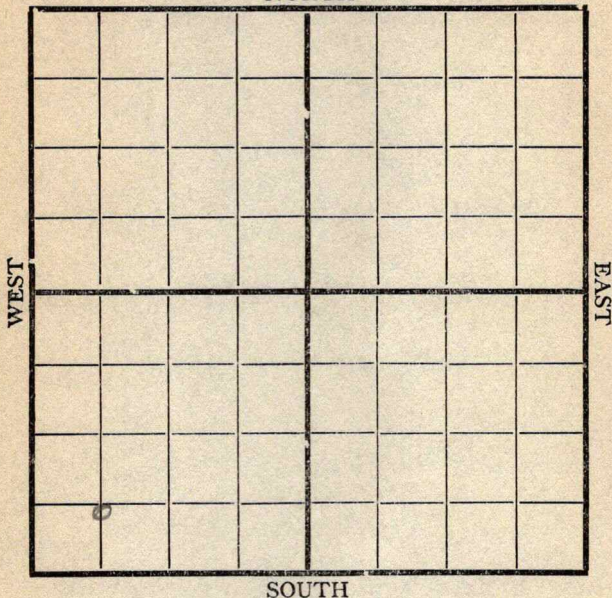

SOUTH

Location _____

Rig up _____

Drilling and Remarks:

735

RECORD

Cased _____ in., _____ ft.

Sand _____

Gas _____

Oil _____

Total Depth _____

PRODUCTION

1st 24 hrs. Nat. _____

1st 24 hrs. after shot _____

Gas _____ Cu. Ft.

Dry Hole _____

Abandoned _____

Date

6/5

191

8. Cordell

Scout

Map No. _____ Sec. 1 Twp. 26 R. 4Well No. 14 BelstonEngine Company

Contractor

NORTH

WEST

EAST

SOUTH

Location _____

Rig up _____

Drilling and Remarks:

1050

RECORD

Cased _____ in., _____ ft.

Sand _____

Gas _____

Oil _____

Total Depth _____

PRODUCTION

1st 24 hrs. Nat. _____

1st 24 hrs. after shot _____

Gas _____ Cu. Ft.

Dry Hole _____

Abandoned _____


Date

6/13 191 8 Conley Scout

Map No. _____ Sec. 1 Twp. 26 R. 4
 Well No. 14 Palston Farm _____
Engine Company _____

NORTH

WEST

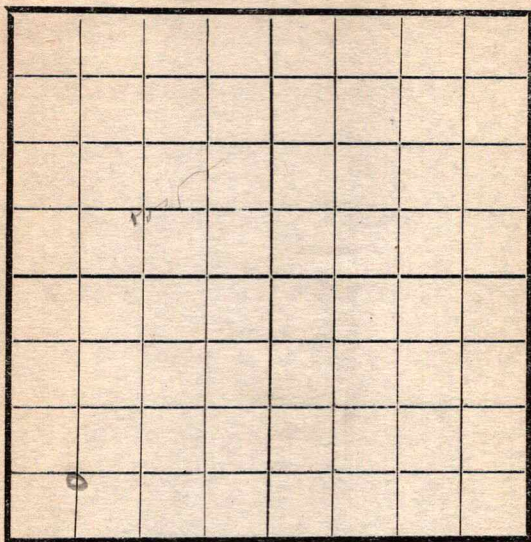

EAST

SOUTH

Location _____
 Rig Up _____
 Drilling and remarks

1590

RECORD

Cased _____ in. _____ Ft.
 Sand _____
 Gas _____
 Oil _____
 Total Depth _____

PRODUCTION

1st 24 hrs. Nat. _____
 1st 24 hrs. after shot _____
 Gas _____ Cu. Ft.
 Dry Hole _____
 Abandoned _____

Date

6/19, 1918 J. C. C. C. Scout


Map No. _____ Sec. 1 Twp. 26 R. 4Well No. 14 PalstonEmpire Company

Contractor _____

NORTH

WEST

EAST

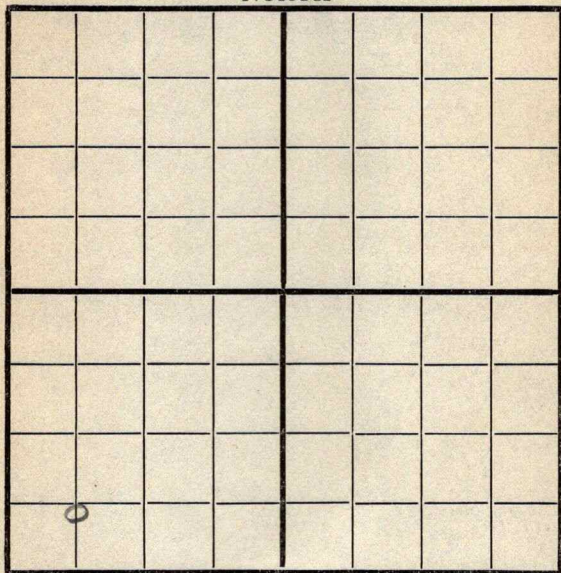

SOUTH

Location _____

Rig up _____

Drilling and Remarks:

1635

RECORD

Cased _____ in., _____ ft.

Sand _____

Gas _____

Oil _____

Total Depth _____

PRODUCTION

1st 24 hrs. Nat. _____

1st 24 hrs. after shot _____

Gas _____ Cu. Ft.

Dry Hole _____

Abandoned _____

Date

6/26 1918 C. C. C. C. Scout

Map No. _____ Sec. 1 Twp. 26 R. 4Well No. 14 Robinson_____
Company_____
Contractor

NORTH

WEST

EAST

SOUTH

Location _____

Rig up _____

Drilling and Remarks:

RECORD

Cased _____ in., _____ ft.

Sand _____

Gas _____

Oil _____

Total Depth _____

PRODUCTION

1st 24 hrs. Nat. _____

1st 24 hrs. after shot _____

Gas _____ Cu. Ft.

Dry Hole _____


Abandoned _____

Date

7/3
191 8Scout

Map No. _____ Sec. 1 Twp. 26 R. 4
 Well No. 14 Palston
Empire Company
 _____ Contractor

NORTH

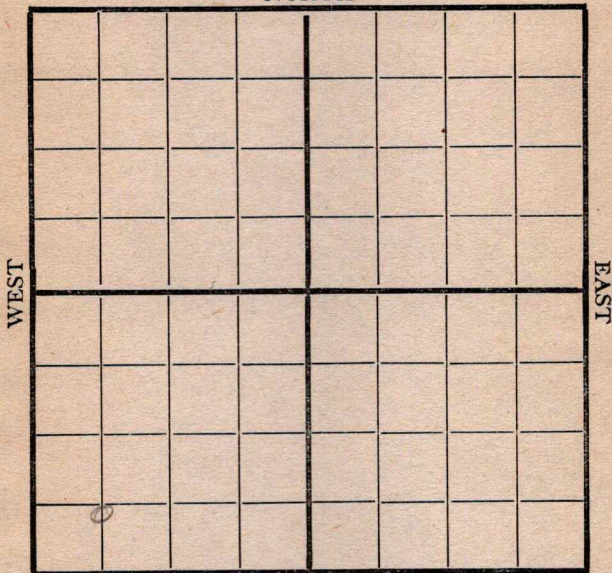

SOUTH

Location _____

Rig up _____

Drilling and Remarks:

Fishing
1800

RECORD

Cased _____ in., _____ ft.

Sand _____

Gas _____

Oil _____

Total Depth _____

PRODUCTION

1st 24 hrs. Nat. _____

1st 24 hrs. after shot _____

Gas _____ Cu. Ft.

Dry Hole _____

Abandoned _____

Date

7/10 191 S. Canby Scout

Map No. _____ Sec. 1 Twp. 26 R. 4Well No. 14 Palatka

_____ Company

_____ Contractor

NORTH

WEST

EAST

SOUTH

RECORD

Location _____

Cased _____ in., _____ ft.

Rig up _____

Sand _____

Drilling and Remarks:

Gas _____

Oil _____

Total Depth _____

PRODUCTION

1st 24 hrs. Nat. _____

1st 24 hrs. after shot _____

Gas _____ Cu. Ft.

Dry Hole _____

Abandoned _____

Date

191

Scout

Map No. _____ Sec. 1 Twp. 26 R. 4
 Well No. 14 Palatka
Cummins Company
 _____ Contractor

NORTH

WEST

EAST

SOUTH

Location _____

Rig up _____

Drilling and Remarks:

Fishing
1870

RECORD

Cased _____ in., _____ ft.

Sand _____

Gas _____

Oil _____

Total Depth _____

PRODUCTION

1st 24 hrs. Nat. _____

1st 24 hrs. after shot _____

Gas _____ Cu. Ft.

Dry Hole _____

Abandoned _____

Date

7/24

191

8

Carney


Scout

Map No. _____ Sec. 1 Twp. 26 R. 4
 Well No. 14 Palston
Empire Company
 Contractor _____

NORTH

WEST

EAST

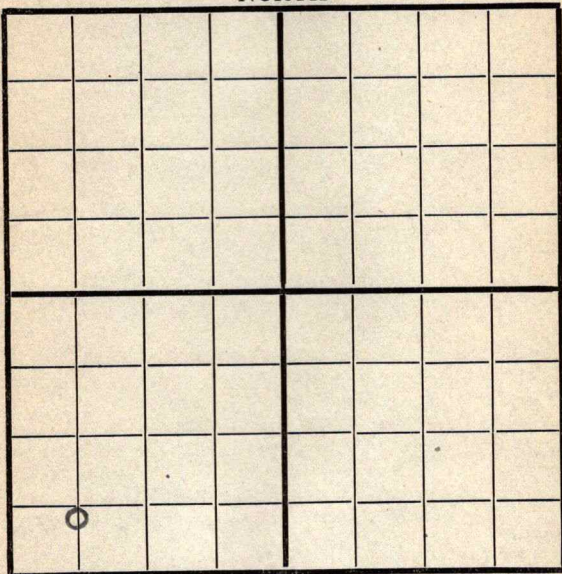

SOUTH

~~660' E of T.R. - 600' N of S.R.~~
 Location 660' W - 600' S

RECORD

Cased _____ in., _____ ft.
 Sand _____
 Gas _____
 Oil _____
 Total Depth _____

PRODUCTION


1st 24 hrs. Nat. _____
 1st 24 hrs. after shot _____
 Gas _____ Cu. Ft.
 Dry Hole _____
 Abandoned _____

Date

7/311918
Conley Scout

Map No. _____ Sec. 1 Twp. 26 R. 4Well No. 14 Palatka
Emperial Company
Contractor _____

NORTH

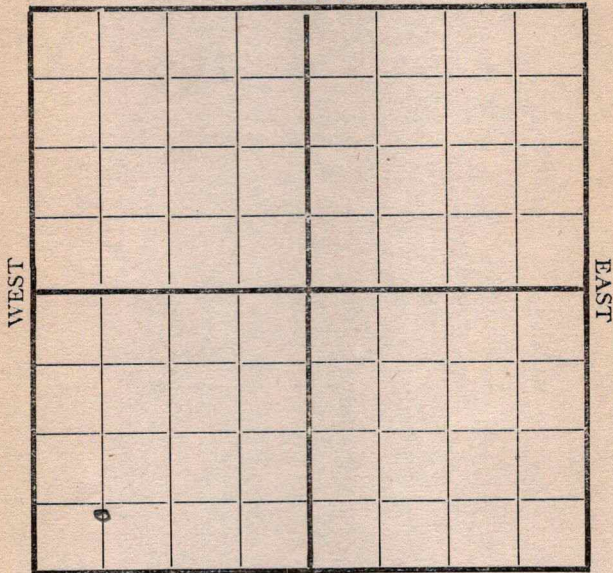660 W 75

Location _____

Rig up _____

Drilling and Remarks:

RECORD

Cased _____ in., _____ ft.

Sand _____

Gas _____

Oil _____

Total Depth _____

PRODUCTION

1st 24 hrs. Nat. _____

1st 24 hrs. after shot _____

Gas _____ Cu. Ft.

Dry Hole _____

Abandoned _____

Date

8/7

191

J. C. Condy


Scout

Map No. _____ Sec. 1 Twp. 26 R. 4Well No. 14 Palatka_____
Engineer Company_____
Contractor

NORTH

WEST

EAST

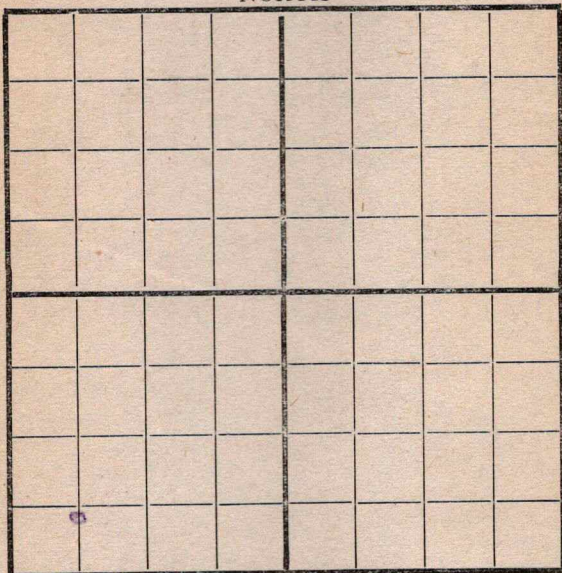

SOUTH

660 S
660 W

Location _____

Rig up _____

Drilling and Remarks:

T. S. 2384fishing

RECORD

Cased _____ in., _____ ft.

Sand _____

Gas _____

Oil _____

Total Depth _____

PRODUCTION

1st 24 hrs. Nat. _____

1st 24 hrs. after shot _____

Gas _____ Cu. Ft.

Dry Hole _____

Abandoned _____

Date

8/151918Cyph

Scout

Map No. K14 Sec. 14 Twp. 26 R. 4
 Well No. 14 Ralston
Empire Company
 Contractor

NORTH

WEST

EAST

COMPLETED

SOUTH

RECORD

Location _____
 Rig up _____
 Drilling and Remarks:

Cased _____ in., _____ ft.
 Sand 2380-2424
 Gas _____
 Oil _____
 Total Depth _____

PRODUCTION

1st 24 hrs. Nat. 200-666
 1st 24 hrs. after shot _____
 Gas _____ Cu. Ft.
 Dry Hole _____
 Abandoned _____

Date

191

Scout