


Map No. _____ Sec. 1 Twp. 26 R. 4Well No. 16 Palaton Farm
Empire Dr. Co. Company

NORTH

WEST

EAST

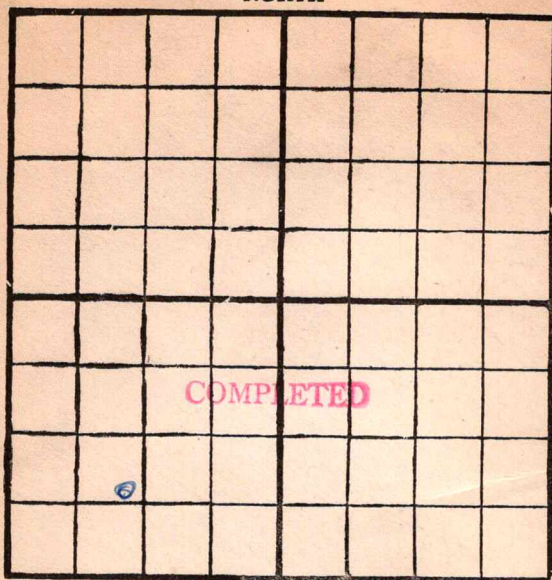

SOUTH

Location _____

Rig Up _____

Drilling Remarks:

Drilling Remarks:

RECORD

Cased _____ in. _____ ft.

Sand _____

Gas _____

Oil _____

Total Depth _____

PRODUCTION

1st 24 hrs. Nat. _____

1st 24 hrs. after shot _____

Gas _____ cu. ft.


Dry Hole _____

Abandoned _____

Map No. K14 Sec. 1 Twp. 26 R. 4
Well No. 16 Palston
Engine Company _____ Contractor _____

NORTH

WEST

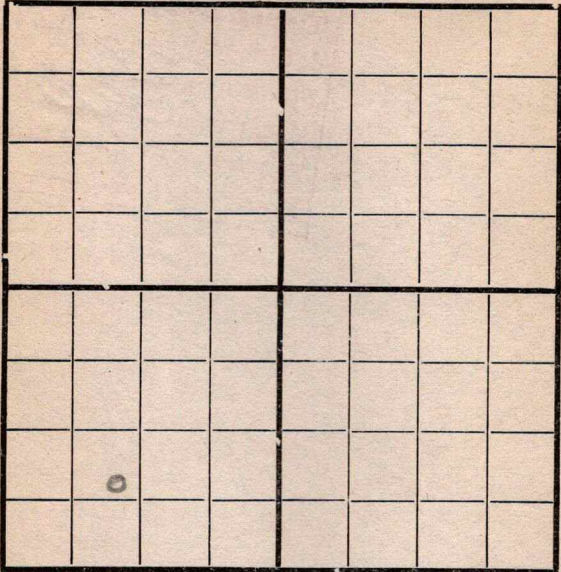

EAST

SOUTH

792 S - 1120 W

Location _____

Rig up ✓ _____

Drilling and Remarks:

FIRST REPORT

RECORD

Cased _____ in., _____ ft.

Sand _____

Gas _____

Oil _____

Total Depth _____

PRODUCTION

1st 24 hrs. Nat. _____

1st 24 hrs. after shot _____


Gas _____ Cu. Ft.

Dry Hole _____

Abandoned _____

Date

12/11 1918 S. Cardy Scout

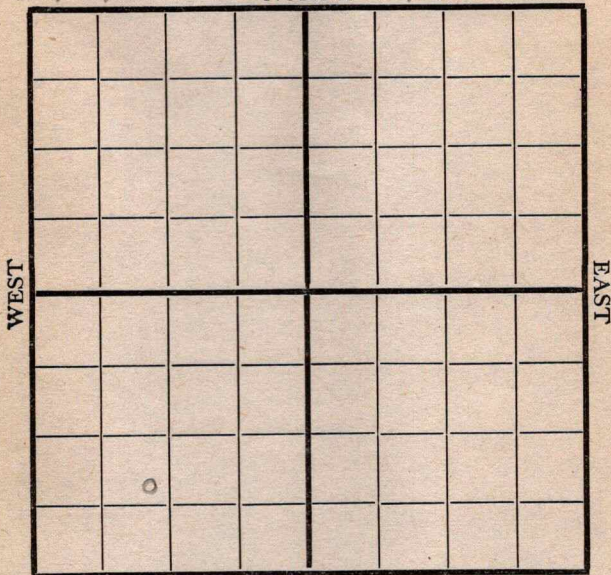Map No. K14 Sec. 1 Twp. 26 R. 4Well No. 16 PalstonCompany EmpireContractor Marshall & Mc GinnisE. L. Dwyer NORTH Kans

7902-1120 W SOUTH

Location _____

Rig up _____

Drilling and Remarks:

Let 15 1/2
at 150

RECORD

Cased _____ in., _____ ft.

Sand _____

Gas _____

Oil _____

Total Depth _____

PRODUCTION

1st 24 hrs. Nat. _____

1st 24 hrs. after shot _____

Gas _____ Cu. Ft.

Dry Hole _____

Abandoned _____

Date

12/18/88 Carney Scout


Map No. K14 Sec. 1 Twp. 26 R. 4Well No. 161 PalstonEmpire Company

Contractor

NORTH

WEST

EAST

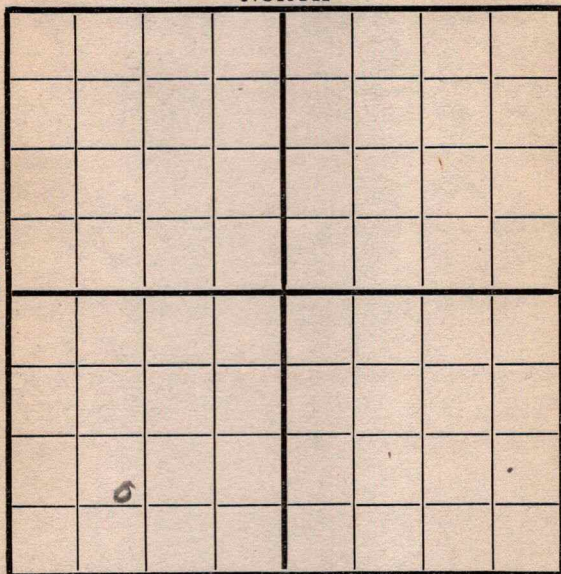

SOUTH

Location

Rig up

Drilling and Remarks:

SD
260

RECORD

Cased _____ in., _____ ft.

Sand _____

Gas _____

Oil _____

Total Depth _____

PRODUCTION

1st 24 hrs. Nat. _____

1st 24 hrs. after shot _____

Gas _____ Cu. Ft.

Dry Hole _____

Abandoned _____

Date

12/25 191 J. C. Canby Scout

Map No. K14 Sec. 1 Twp. 26 R. 4Well No. 16 BalaconCompany Engel

Contractor _____

NORTH

WEST

EAST

SOUTH

Location _____

Rig up _____

Drilling and Remarks:

RECORD

Cased _____ in., _____ ft.

Sand _____

Gas _____

Oil _____

Total Depth _____

PRODUCTION

1st 24 hrs. Nat. _____

1st 24 hrs. after shot _____

Gas _____ Cu. Ft.

Dry Hole _____

Abandoned _____

Date

191

Scout

Map No. K14 Sec. 1 Twp. 26 R. 4Well No. 16 PolstonEmpire Company

Contractor

NORTH

WEST

EAST

SOUTH

7008-1120 W

Location _____

Rig up _____

Drilling and Remarks:

275

RECORD

Cased _____ in., _____ ft.

Sand _____

Gas _____

Oil _____

Total Depth _____

PRODUCTION

1st 24 hrs. Nat. _____

1st 24 hrs. after shot _____

Gas _____ Cu. Ft.

Dry Hole _____

Abandoned _____

Date

1/8 1919 Cordell Scout


Map No. 1514 Sec. 1 Twp. 26 R. 4Well No. 16 RolstonEmery Company

Contractor

NORTH

WEST

EAST

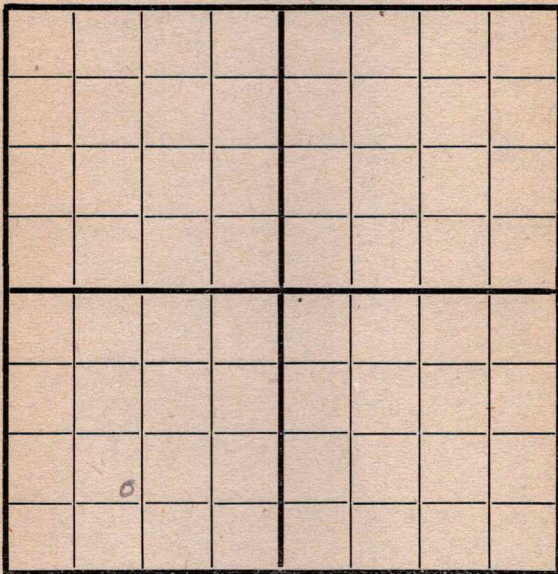

SOUTH

7008-1150 W

Location _____

Rig up _____

Drilling and Remarks:

780

RECORD

Cased _____ in., _____ ft.

Sand _____

Gas _____

Oil _____

Total Depth _____

PRODUCTION

1st 24 hrs. Nat. _____

1st 24 hrs. after shot _____

Gas _____ Cu. Ft.

Dry Hole _____

Abandoned _____

Date


1/15 191 9 Canby Scout

Map No. K14 Sec. 1 Twp. 26 R. 4
 Well No. 16 Palston
Empire Company
 Contractor

NORTH

WEST

EAST

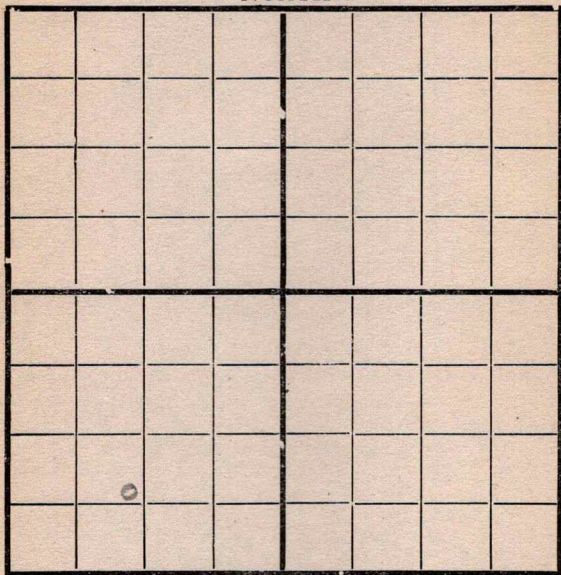

SOUTH

700 S 1130 W

Location _____

Rig up _____

Drilling and Remarks:

1290

RECORD

Cased _____ in., _____ ft.

Sand _____

Gas _____

Oil _____

Total Depth _____

PRODUCTION

1st 24 hrs. Nat. _____

1st 24 hrs. after shot _____

Gas _____ Cu. Ft.

Dry Hole _____

Abandoned _____

Date

1/22 1919 Conley Scout


Map No. K14 Sec. 1 Twp. 26 R. 4Well No. 16 Raleston
Empire Company

Contractor

NORTH

WEST

EAST

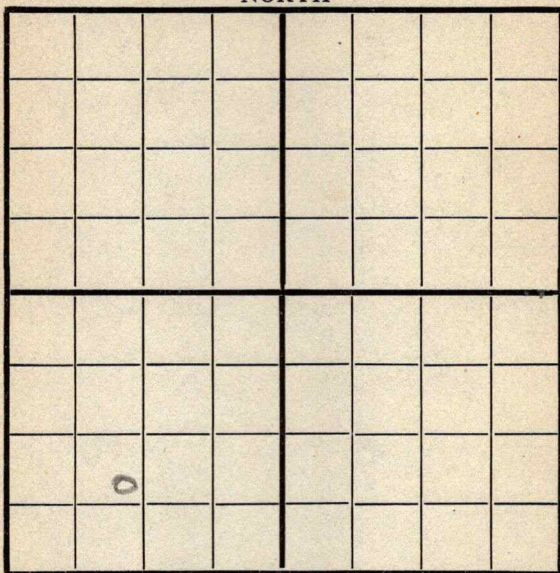

SOUTH

7905

1120 W

Location

Rig up

Drilling and Remarks:

good
showing

RECORD

Cased _____ in., _____ f

Sand 2361-237

Gas _____

Oil _____

Total Depth _____

PRODUCTION

1st 24 hrs. Nat. _____

1st 24 hrs. after shot _____

Gas _____ Cu. F

Dry Hole _____

Abandoned _____

Date

3/8 1919

Pyle

Scot

Map No. K 14 Sec. 1 Twp. 26 R. 4
 Well No. 16 Ralston
Empire Company
 Contractor

NORTH

WEST

EAST

COMPLETED

0

SOUTH

790 S

1120 W

Location _____

Rig up _____

Drilling and Remarks:

RECORD

Cased _____ in., _____ ft.

Sand 2361 - 2377

Gas _____

Oil _____

Total Depth _____

PRODUCTION

1st 24 hrs. Nat. 280 bbl

1st 24 hrs. after shot _____

Gas _____ Cu. Ft.

Dry Hole _____

Abandoned _____

Date

3/

1919

Gyle
 Scout