


Map No. _____ Sec. 8 Twp. 23 R. 4
 Well No. 2 Furness Farm
Sinclair Oil Co. Company

NORTH

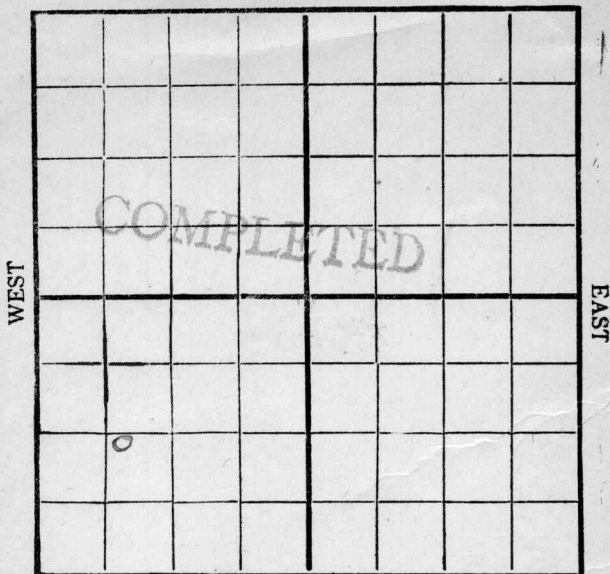

SOUTH

Location _____

Rig Up _____

Drilling Remarks:

Drilling Remarks:

8-16-19Sand 2405' - 2415'Pumping 1000 bbls per day

RECORD

PRODUCTION

Cased _____ in. _____ ft.

1st 24 hrs. Nat. _____

Sand _____

1st 24 hrs. after shot _____

Gas _____

Gas _____ cu. ft.

Oil _____

Dry Hole _____

Total Depth _____

Abandoned _____


Map No. K14 Sec. 8 Twp. 23 R. 4Well No. 2 Furman
Sinclair O & G. Company

Contractor

NORTH

WEST

EAST

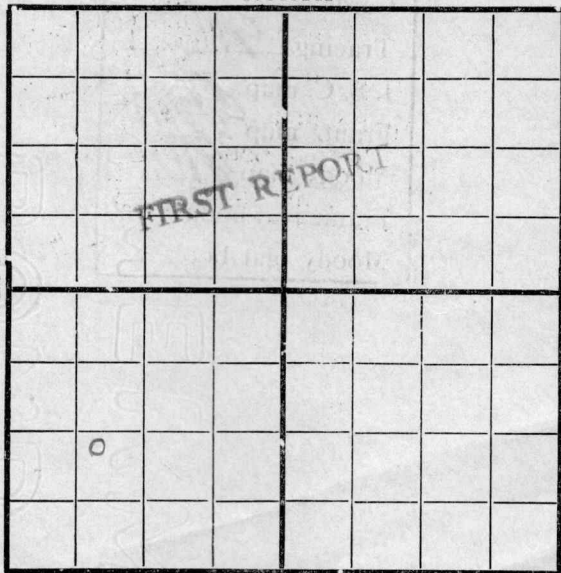

SOUTH

700 W

1120 S

Location _____

Rig up _____

Drilling and Remarks:

Timbers

RECORD

Cased _____ in., _____ ft.

Sand _____

Gas _____

Oil _____

Total Depth _____

PRODUCTION

1st 24 hrs. Nat. _____

1st 24 hrs. after shot _____

Gas _____ Cu. Ft.

Dry Hole _____

Abandoned _____

Date

Pyle


6/7 1919

Scout

Map No. 1514 Sec. 8 Twp. 23 R. 4Well No. 2 Furman
Dinclair O & S Company

Contractor

NORTH

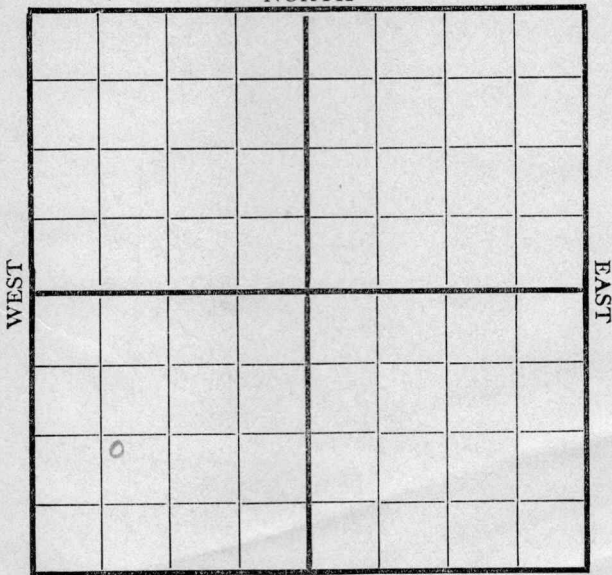

SOUTH

Location _____

Rig up ☒

Drilling and Remarks:

RECORD

Cased _____ in., _____ ft.

Sand _____

Gas _____

Oil _____

Total Depth _____

PRODUCTION

1st 24 hrs. Nat. _____

1st 24 hrs. after shot _____

Gas _____ Cu. Ft.

Dry Hole _____

Abandoned _____

Date

6/14 1919

Pyle

Scout


Map No. K14 Sec. 8 Twp. 23 R. 4Well No. 2 FurmanLinclair O & P Company

Contractor

NORTH

WEST

EAST

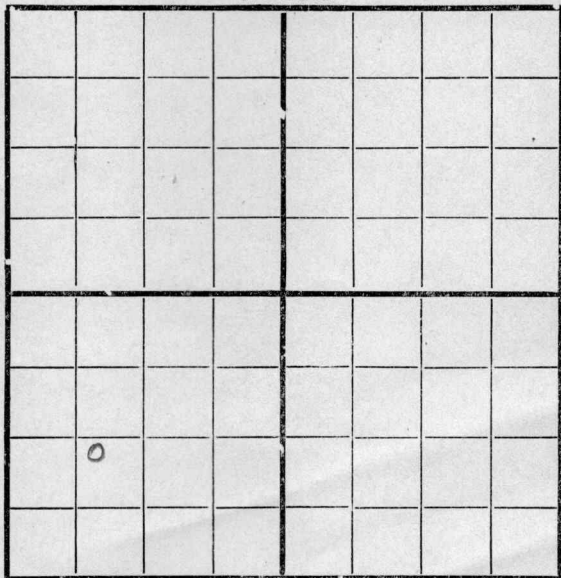

SOUTH

700 W

1120 S

Location _____

Rig up ☒

Drilling and Remarks:

RECORD

Cased _____ in., _____ ft.

Sand _____

Gas _____

Oil _____

Total Depth _____

PRODUCTION

1st 24 hrs. Nat. _____

1st 24 hrs. after shot _____

Gas _____ Cu. Ft.

Dry Hole _____

Abandoned _____

Date


6/18

1919

Pyle

Scout

Map No. K14 Sec. 8 Twp. 23 R. 4
 Well No. 2 Furman
Drinclair Oil Company
 Contractor

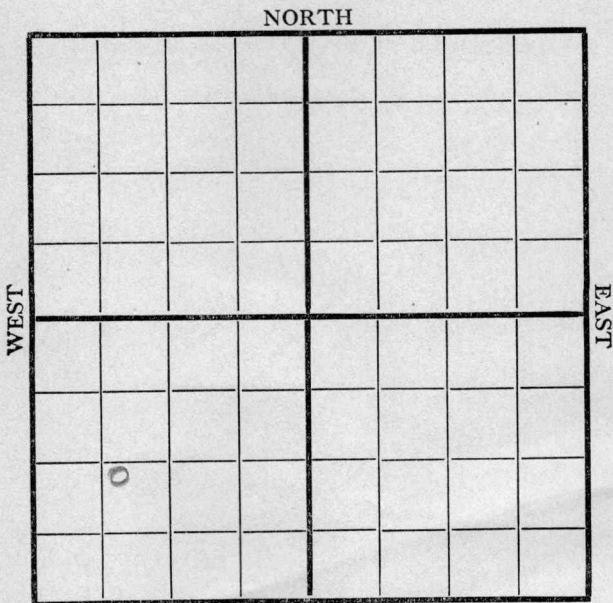

700 W 1120 S

Location _____

Rig up _____

Drilling and Remarks:

Spudding

Elev 1362

RECORD

Cased _____ in., _____ ft.

Sand _____

Gas _____

Oil _____

Total Depth _____

PRODUCTION

1st 24 hrs. Nat. _____

1st 24 hrs. after shot _____

Gas _____ Cu. Ft.

Dry Hole _____

Abandoned _____

Date

6/28 1919

Cyler Scout


Map No. K14 Sec. 8 Twp. 23 R. 4Well No. 2 FumanSinclair O & G Company

Contractor

NORTH

WEST

EAST

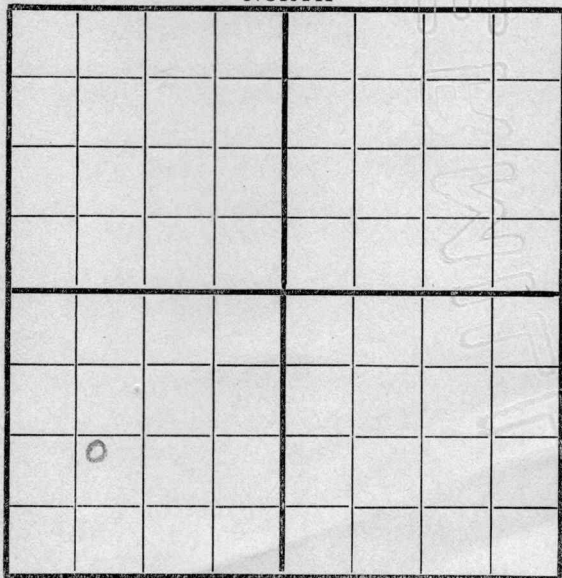

SOUTH

700 W1120 S

Location _____

Rig up _____

Drilling and Remarks:

500'

RECORD

Cased _____ in., _____ ft.

Sand _____

Gas _____

Oil _____

Total Depth _____

PRODUCTION

1st 24 hrs. Nat. _____

1st 24 hrs. after shot _____

Gas _____ Cu. Ft.

Dry Hole _____

Abandoned _____

Date

7/11919Cyph


Scout

Map No. K14 Sec. 8 Twp. 23 R. 4Well No. 2 Furnace Sinclair Oil Co. Company Contractor

NORTH

WEST

EAST

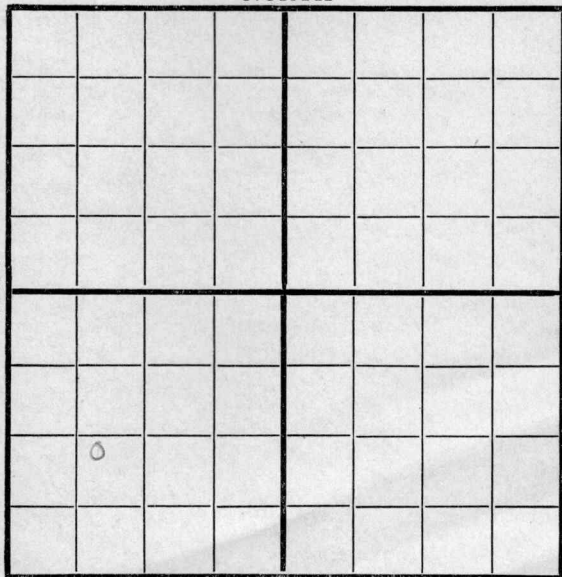

SOUTH

700 W1120 S

Location _____

Rig up _____

Drilling and Remarks:

900'

RECORD

Cased _____ in., _____ ft.

Sand _____

Gas _____

Oil _____

Total Depth _____

PRODUCTION

1st 24 hrs. Nat. _____

1st 24 hrs. after shot _____

Gas _____ Cu. Ft.

Dry Hole _____

Abandoned _____

Date

7/12 1919 Pyle Scout


Map No. K14 Sec. 8 Twp. 23 R. 4Well No. 2 FurmanSinclair O & L Company

Contractor

NORTH

WEST

EAST

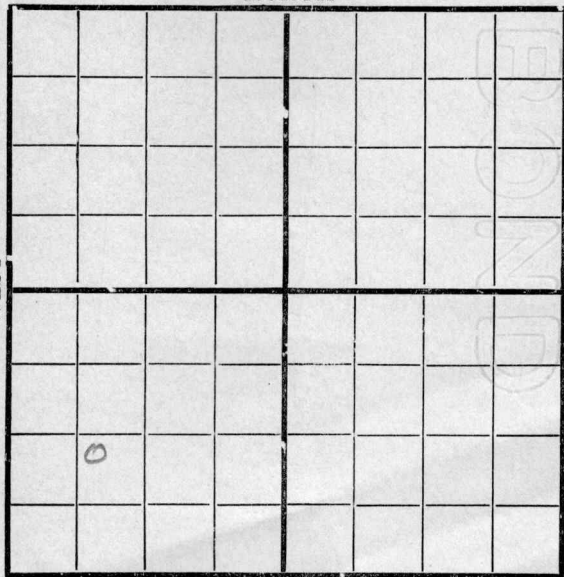

SOUTH

700 W1120 S

Location _____

Rig up _____

Drilling and Remarks:

1890'

RECORD

Cased _____ in., _____ ft.

Sand _____

Gas _____

Oil _____

Total Depth _____

PRODUCTION

1st 24 hrs. Nat. _____

1st 24 hrs. after shot _____

Gas _____ Cu. Ft.

Dry Hole _____

Abandoned _____

Date

7/16 191 9 Pyle Scout

Map No. K14 Sec. 8 Twp. 23 R. 4


Well No. 2 Furman
Shinclair Oil Company

Contractor

NORTH

WEST

EAST

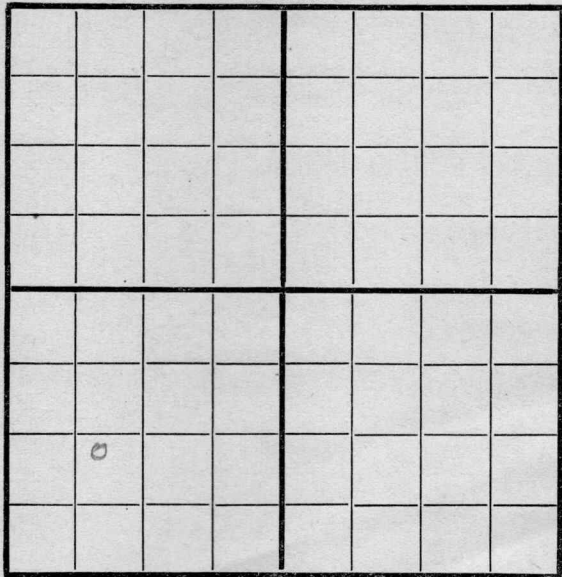

SOUTH

Location 700 W

Rig up

Drilling and Remarks:

2340'

RECORD

Cased _____ in., _____ ft.

Sand _____

Gas _____

Oil _____

Total Depth _____

PRODUCTION

1st 24 hrs. Nat. _____

1st 24 hrs. after shot _____

Gas _____ Cu. Ft.

Dry Hole _____

Abandoned _____

Date

7/25 1919 Pyle Scout


Map No. K 14 Sec. 8 Twp. 23 R. 4Well No. 2 FurnessSniclair Oil Company

Contractor

NORTH

WEST

EAST

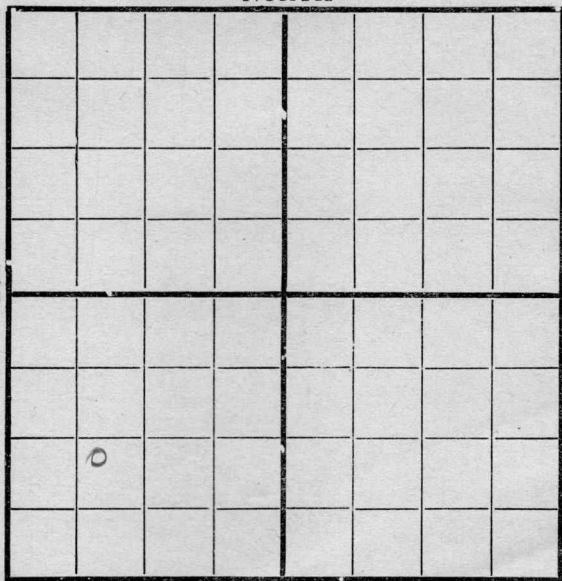

SOUTH

700 W11205

Location _____

Rig up _____

Drilling and Remarks:

flowing
70 bbls
per hour

RECORD

Cased _____ in., _____ ft.

Sand 2405-2415

Gas _____

Oil _____

Total Depth _____

PRODUCTION

1st 24 hrs. Nat. _____

1st 24 hrs. after shot _____

Gas _____ Cu. Ft.

Dry Hole _____

Abandoned _____

Date


7/29 1919 Pyle Scout

Map No. K14 Sec. 8 Twp. 23 R. 4Well No. 2 Furman FarmDinclair Company

NORTH

WEST

EAST

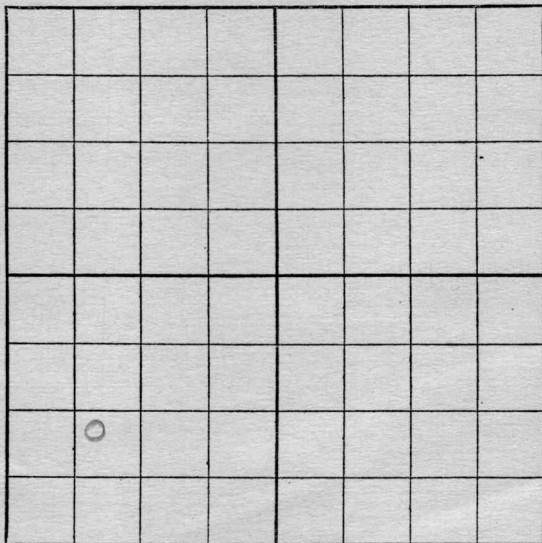

SOUTH

Location

Rig up

Drilling and Remarks:

Starting
making
9% water
4% B. S.
Putting on
pumps

RECORD

Cased in. Ft.

Sand 2405-2415

Gas

Oil

Total Depth

PRODUCTION

1st 24 hrs. Nat.

1st 24 hrs. after shot

Gas Cu. Ft.

Dry Hole

Abandoned

Date

8/4, 1919, Pyke Scout


Map No. K14 Sec. 8 Twp. 23 R. 4Well No. 2 Furman
Sinclair O & G Company

Contractor

NORTH

WEST

EAST

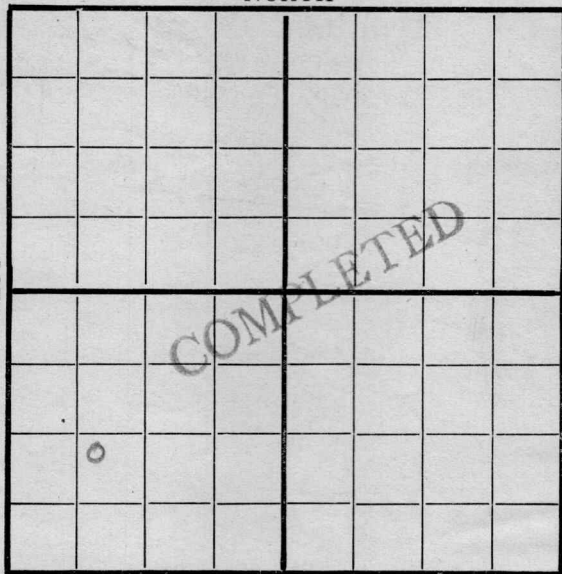

SOUTH

700 W

11205

Location _____

Rig up _____

Drilling and Remarks:

*Pumping
1000 bbls
per day -*

RECORD

Cased _____ in., _____ ft.

Sand 2405-2415

Gas _____

Oil _____

Total Depth _____

PRODUCTION

1st 24 hrs. Nat. _____

1st 24 hrs. after shot _____

Gas _____ Cu. Ft.

Dry Hole _____

Abandoned _____

Date

8/11

191 9

Pyle Scout