Butler KANSAS

SECTION 10 TOWNSHIP 26 RANGE 4E

WELL NO. #6 Ralston

COMPANY White & Ellis

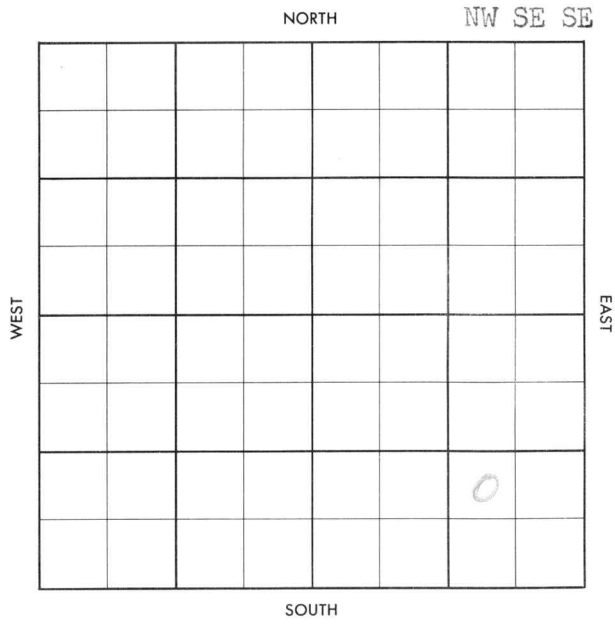

FORM 504-3 SUNRAY

FORM 513 SUNRAY

County Butler Elev.

Sec. 10 Twp. 26 Rge. 4E

Company White & Ellis

Farm Name Ralston No. 6

TOPS	DEPTH	LOG	DATUM
Anh.			
Tp.			
H.			
Tr.			
Dg.			
B.L.			
L.			
K.C.			
B.K.C.			
Ce.			
C.			
M.			
M.			
K.			
Mz.			
Mo.			
V.			
S.			
S.			
A			
R.			
P€.			
G.			
T.D.			

Loc. in Sec. NW SE SE

Geol.

Contr. Co. Tools

Pool El Dorado

COMPLETE

JUN 26 57

FIRST REPORT

Date Comm.

8" @ 206 w/spudder - WORT

29

Co. Lse. No. Sec. T. R.

FORM 513 SUNRAY

County Butler Elev. 1336

Sec. 10 Twp. 26 Rge. 4E

Company White & Ellis

Farm Name Ralston No. 6

TOPS	DEPTH	LOG	DATUM
Anh.			
Tp.			
H.			
Tr.			
Dg.			
Bl.			
L.	1631		
K.C.	1965		
B.K.C.			
Ce.			
C.			
M.			
M.			
K.			
Mz.			
Mo.			
V.			
S.			
S.			
A erro	2354		
R. Arb	2373		
P€.			
G.			
T.D.	2377		

Loc. in Sec. NW SE SE

Geol.

Contr. Co. Tools

Pool ElDorado

COMPLETE

AUG 28 '57

Date Comm.

8" @ 206 w/spudder - WORT JUL 3 '57 WOR

JUL 10 '57 JUL 17 '57 JUL 24 '57 JUL 31 '57 7-28-57

8 5/8 206/150 D 1591 AUG 8 '57

5½ @ 2360 WOCT AUG 14 '57 DD 2378

FU 300' oil no/w 12 hrs Pot

AUG 21 '57 AUG 28 '57 P. 23 Bopd no/w

Co. Lse. No. Sec. T. R.