
FORM 51 25M 8-50 WESTERN Butler KANSAS

Section 10 Township 26 Range 4E

Well No. #4 Ralston

Company White & Ellis

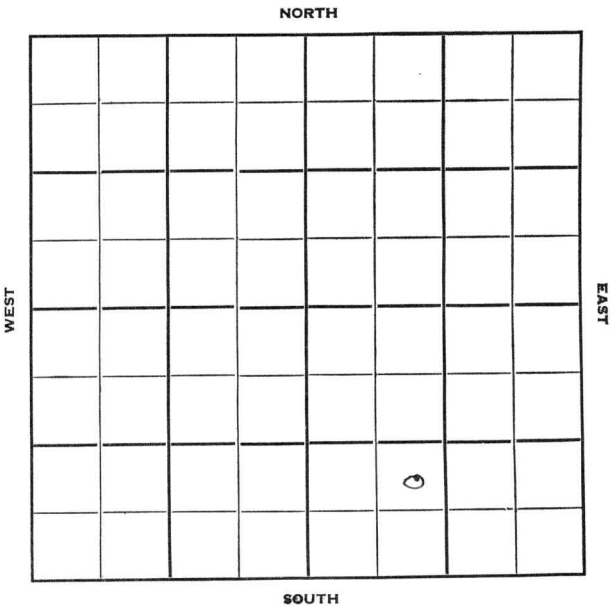

FORM 252-B
10M 10-50 PETROL

Butler KANSAS

Sec. 10 Twp. 26 R. 4E

Well No. #4 Ralston Farm

White-&-Ellis Company

Contractor


_____ Ft. from N. Line

990' Ft. from S. Line

_____ Ft. from E. Line

990' Ft. from W. Line

NE SW SE

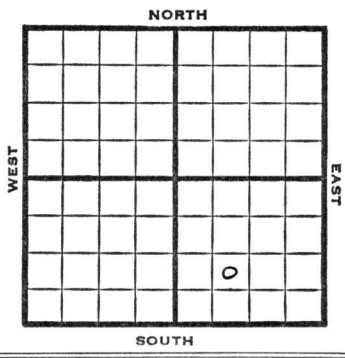

1952	Elev. 1344' REPORT
1/23	Spud 1-18-52 8" @ 75 Drlg. 1195'
2/6	Arb. 2390 TD 2394 5" @ 2392'
2/13	Drlg. 2404' SD
2/20	Spud 1-18-52 Oil Well TD 2412' 8" @ 75 Arb. 2390 TD 2394 5" @ 2392 DD 2412 15 qt. Comp. 20 bopd

COMPLETED

FORM 275 FOR SALE BY KANSAS BLUE PRINT CO.


County Butler State Kansas

Sec. 10 (Blk. Twp.) 26 (Sur. Rge.) 4E Map No.

Operator White & Ellis

Well No. 4 Farm Ralston

Elev. Location NE SW SE

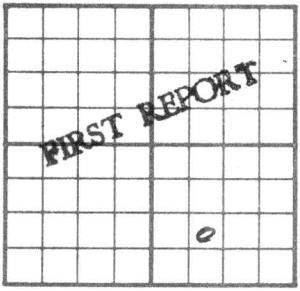

990 Ft. From S Line SE

990 Ft. From W Line Quarter

1st. Report JAN 23 1952

Completion

Remarks

Spudding Date 1-18-52

Drlg. Data

8" @ 75' Drlg. 1195

J. E. TYRA

FORM 275 FOR SALE BY KANSAS BLUE PRINT CO.


County Butler State Kansas

Sec. 10 (Blk. Twp.) 26 (Sur. Rge.) 4E Map No.

Operator White & Ellis

Well No. 4 Farm Ralston

Elev. 1344 Location NE SW SE

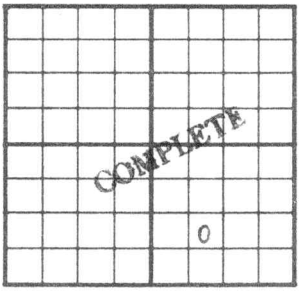

990 Ft. From S Line SE

990 Ft. From W Line Quarter

1st. Report

Completion FEB 20 1952

Remarks

Spudding Date 1-18-52

Drlg. Data Oil well TD 2412

8" @ 75 Arb. 2390 TD 2394 5" @ 2392

DD 2412 15 qt Comp. 20 bopd

J. G. McGEHEE