

KANSAS

Butler

O. W. D. D

Section 8 Township 23 Range 4-E


Well No. #2 Fuman

Company Aladdin Pet.

NORTH

WEST

EAST

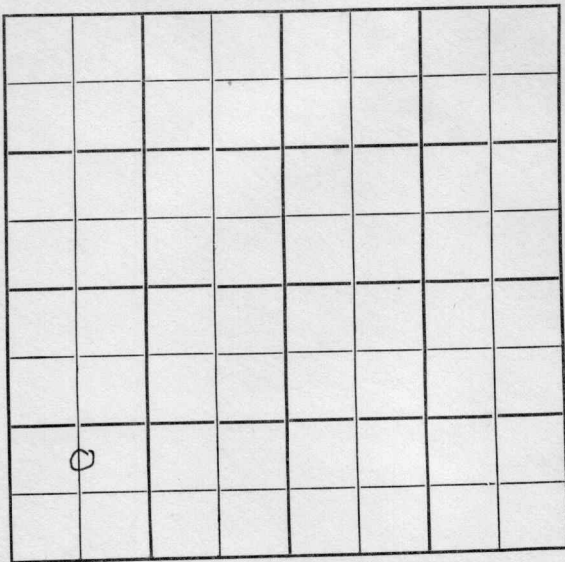

SOUTH

O. W. D. D

NO-RECORD

KANSAS

Butler

Sec. 8 Twp. 23 R. 4-E

Well No. #2 Furman Farm

Aladdin Pet.

Company

B & R. Drlg.

NO-RECORD

Contractor

O. W. D. D

NORTH

Ft. from N. Line

990


Ft. from S. Line

Ft. from E. Line

660

Ft. from W. Line

C N L SW SW

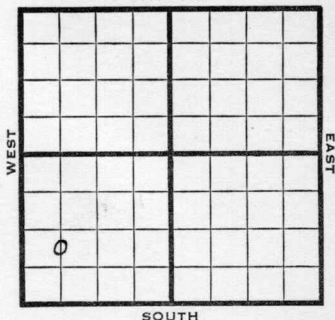

1950

?

REPORT

7/12

Was KC prod.

Hunton 2394

5" @ 2402

TD 2404

Pump 55 bo 24 bw 40 hr

7/19

Was KC prod.

Hunton 2394

5" @ 2402

TD 2404

Comp 55 bo 24 bwpd

Completed

COMPLETED

O. W. D. D

1951

1/31

Hunton 2394 OTD 2404

5" @ 2402 Maq. 2459

Viola 2481 Simp dol. 2498

Simp. Sand 2506 Arb. 2562

Regan 3105 TD 3116 to perf Hunton

3/7

SWD well TD 3118

Hunton 2394 OTD 2404

5" @ 2402

Maq. 2459, Viola 2481, Simp dol 2498

Simp. sand 2506, Arb. 2562, Regan 3105

TD 3116 19/ 2411-17 HFW

DD 3118 4" @ 3118 232/ 2554-31

Comp. for SWD

ABANDONED

NO-RECORD

Map No. _____ Sec. 8 Twp. 23 R. 4EWell No. 2 FurmanAladdin Pet. Company

Contractor

C N L SW SW

SECTION PLAT



_____ Ft. from N. Line

990 Ft. from S. Line

_____ Ft. from E. Line

660 Ft. from W. Line

Butler County

Location _____

Rig up _____

Drilling and Remarks:

Was KC prod.

Hunton 2394

5" @ 2402

TD 2404

Pump 55 bo

24 bw 40 hr.

RECORD

Cased _____ in., _____ ft.

Sand _____

Gas _____

Oil _____

Total Depth _____

PRODUCTION

1st 24 hrs. Nat. _____

1st 24 hrs. after shot _____

Gas _____ Cu. Ft.

Dry Hole _____

Abandoned _____

Date

JUL 12 1950 19J. E. TYRA

Scout

Kansas

Map No. _____ Sec. 8 Twp. 23 R. 4EWell No. 2 FurmanAladdin Pet.

Company _____

Contractor _____

C N L SW SW

SECTION PLAT



_____ Ft. from N. Line

990 Ft. from S. Line

_____ Ft. from E. Line

660 Ft. from W. LineButler County

Location _____

Rig up _____

Drilling and Remarks:

Was KC prod.

Hunton 2394

5" @ 2402

TD 2404

Comp. 55 bo
24 bwpd

RECORD

Cased _____ in., _____ ft.

Sand _____

Gas _____

Oil _____

Total Depth 2404

PRODUCTION

1st 24 hrs. Nat. _____


1st 24 hrs. after shot _____

Gas _____ Cu. Ft.

Dry Hole _____

Abandoned _____

Date JUL 19 1950

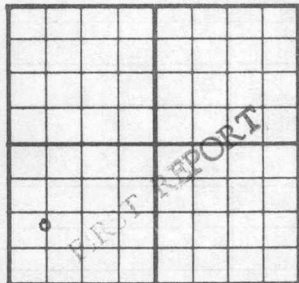County **Butler** State **Kansas**Sec. **8** (Blk. **23** (Sur. **4E** Map No.Operator **Aladdin Petroleum**Well No. **2** Farm **Furman**Elev. Location **C N L SW SW****990** Ft. From **S** Line **SW****660** Ft. From **W** Line Quarter1st. Report **JAN 31 1951**

Completion


Remarks **OWDD**
O. W. D. D

Spudding Date

Drlg. Data

Hunton 2394 OTD 2404 5" @ 2402**Maq. 2459 Viola 2481 Simp. dol. 2498****Simp. sand 2506 Arb. 2562 Regan 3105****T.D. 3116 to perf. Hunton**

J. E. TYRA

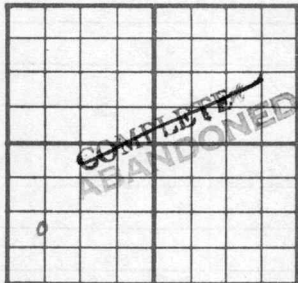County Butler State KansasSec. 8 (Blk.) 23 (Sur.) 4E Map No.Operator Aladdin PetroleumWell No. 2 Farm FurmanElev. Location C N L SW SW990 Ft. From S Line SW660 Ft. From W Line Quarter

1st. Report

Completion MAR 7 1951Remarks OWDDB & R Drlg. - Contr.

Spudding Date

Drlg. Data SWD well TD 3118Hunton 2394 OTD 2404 5" @ 2402Maq. 2459 Viola 2481 Simp. dol. 2498Simp. sand 2506 Arb. 2562 Regan 3105TD 3116 19/ 2411-17 HFW DD 31184" @ 3118 232/ 2554-31 Comp. for SWD

J. E. TYRA