


Map No. _____ Sec. 8 Twp. 23 R. 4

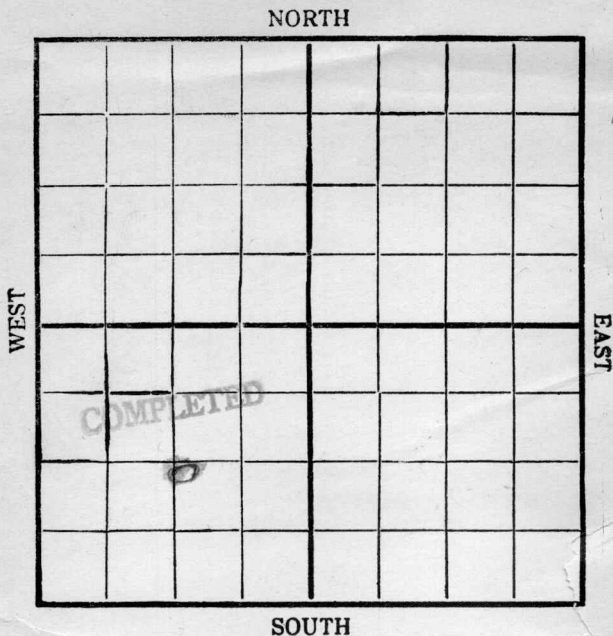

Location _____

Drilling Remarks:

9-5 Sand 2404-19'
1200 bbls.

Rig Up _____

Drilling Remarks:

RECORD

Cased _____ in. _____ ft.
 Sand _____
 Gas _____
 Oil _____
 Total Depth _____

PRODUCTION

1st 24 hrs. Nat. _____
 1st 24 hrs. after shot _____
 Gas _____ cu. ft.
 Dry Hole _____
 Abandoned _____


Map No. K14 Sec. 8 Twp. 23 R. 4Well No. 3 Furman
Sinclair O & L Company

Contractor

NORTH

WEST

EAST

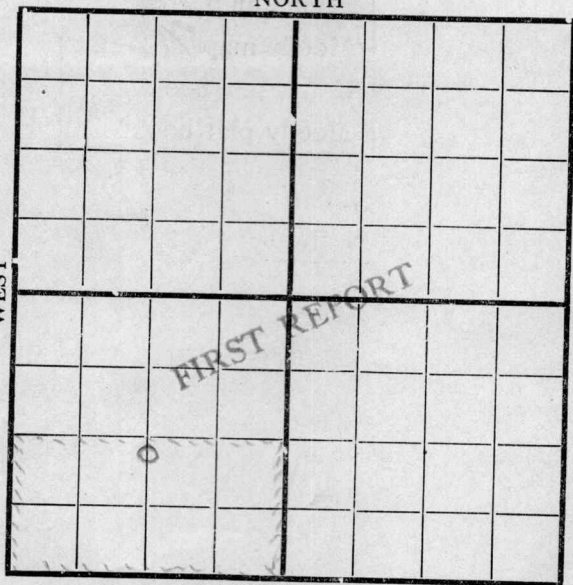

1320 W

SOUTH

1120 S

Location _____

Rig up ☒ _____

Drilling and Remarks:

Timbers

RECORD

Cased _____ in., _____ ft.

Sand _____

Gas _____

Oil _____

Total Depth _____

PRODUCTION

1st 24 hrs. Nat. _____

1st 24 hrs. after shot _____

Gas _____ Cu. Ft.

Dry Hole _____

Abandoned _____

Date

6/17

191

*9**Cyph*

Scout


Map No. K14 Sec. 8 Twp. 23 R. 4Well No. 3 Furman
Sinclair Oil Co. Company

Contractor

NORTH

WEST

EAST

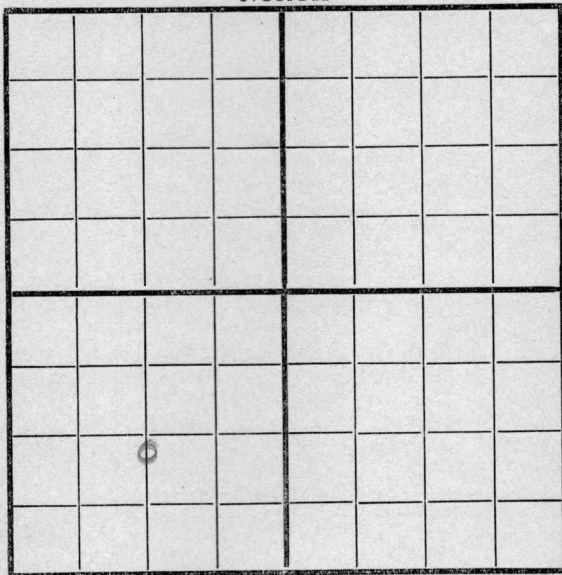1320 W SOUTH1120 S

RECORD

Location _____

Cased _____ in., _____ ft.

Rig up ☒

Sand _____

Drilling and Remarks:

Gas _____

Oil _____

Total Depth _____

PRODUCTION

1st 24 hrs. Nat. _____

1st 24 hrs. after shot _____

Gas _____ Cu. Ft.

Dry Hole _____

Abandoned _____

Elev 1372

Date

6/281919Pyle Scout


Map No. K14 Sec. 8 Twp. 23 R. 4Well No. 3 FurnaceSinclair Oil Co. Company

Contractor

NORTH

WEST

EAST

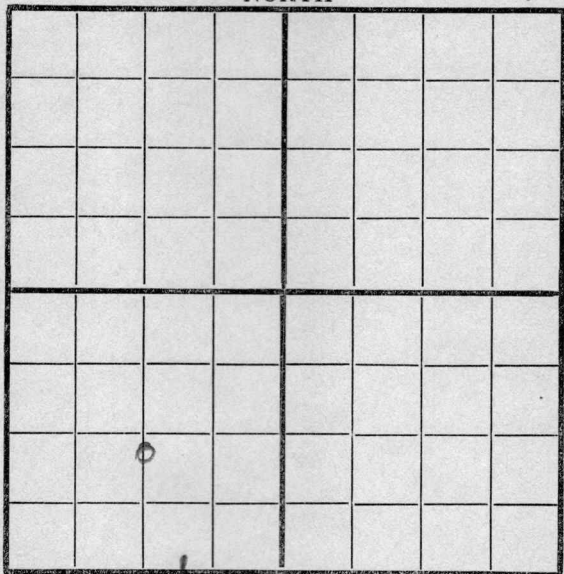

SOUTH

1030 S.1320 W

RECORD

Location _____

Cased _____ in., _____ ft.

Rig up _____

Sand _____

Drilling and Remarks:

Gas _____

Oil _____

Total Depth _____

PRODUCTION

1st 24 hrs. Nat. _____

1st 24 hrs. after shot _____

Gas _____ Cu. Ft.

Dry Hole _____

Abandoned _____

Date

7/1

191

9Pyle

Scout

Map No. K14 Sec. 8 Twp. 23 R. 4


Well No. 3 Furnace
Drillair O & S Company

Contractor

NORTH

WEST

EAST

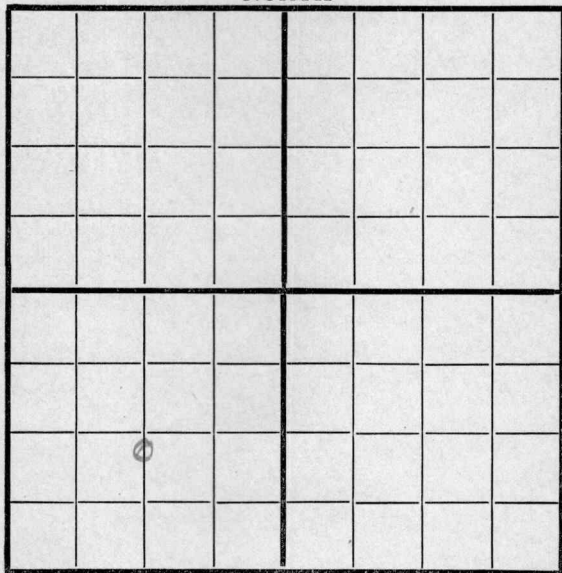

SOUTH

1320 W

1120 S

Location

Rig up

Drilling and Remarks:

Spud

RECORD

Cased _____ in., _____ ft.

Sand _____

Gas _____

Oil _____

Total Depth _____

PRODUCTION

1st 24 hrs. Nat. _____

1st 24 hrs. after shot _____

Gas _____ Cu. Ft.

Dry Hole _____

Abandoned _____

Date

7/12 1919 Pyle Scout


Map No. K14 Sec. 8 Twp. 23 R. 4Well No. 3 FurnessSinclair O & G Company

Contractor

NORTH

WEST

EAST

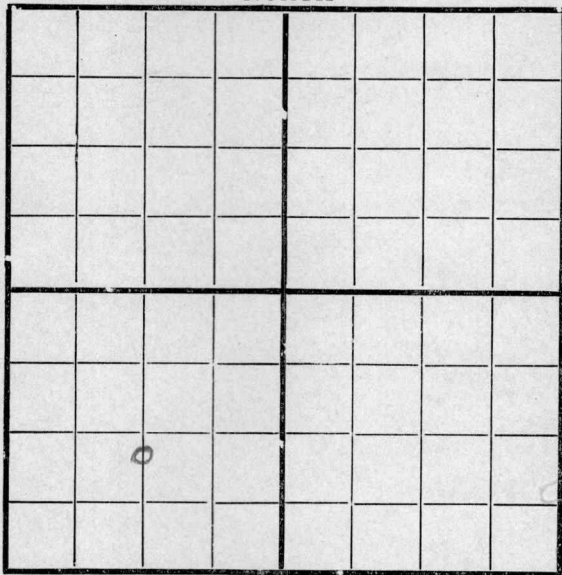

SOUTH

1120 S1320 W

Location _____

Rig up _____

Drilling and Remarks:

560'

RECORD

Cased _____ in., _____ ft.

Sand _____

Gas _____

Oil _____

Total Depth _____

PRODUCTION

1st 24 hrs. Nat. _____

1st 24 hrs. after shot _____

Gas _____ Cu. Ft.

Dry Hole _____

Abandoned _____

Date

7/191916Cyle

Scout


Map No. K14 Sec. 8 Twp. 23 R. 4Well No. 3 Furman
Shinclair O & G Company

Contractor

NORTH

WEST

EAST

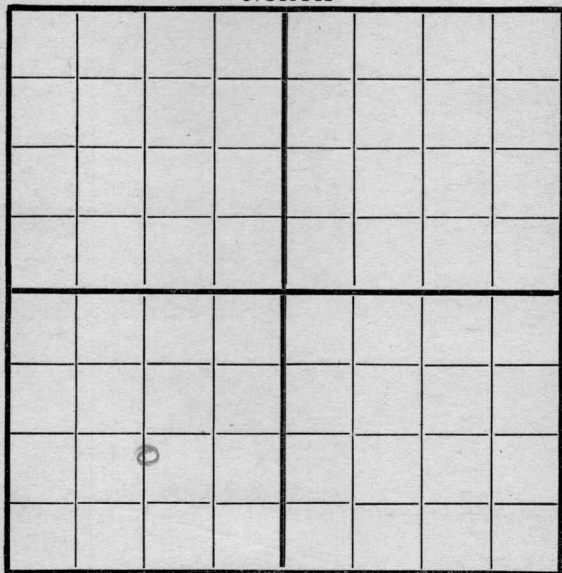

SOUTH

Location _____

Rig up _____

Drilling and Remarks:

1040'

RECORD

Cased _____ in., _____ ft.

Sand _____

Gas _____

Oil _____

Total Depth _____

PRODUCTION

1st 24 hrs. Nat. _____

1st 24 hrs. after shot _____

Gas _____ Cu. Ft.


Dry Hole _____

Abandoned _____

Date

7/25 1919Pyle Scout

Map No. 1514 Sec. 8 Twp. 23 R. 4
 Well No. 3 Furman
Disclair Company
 Contractor

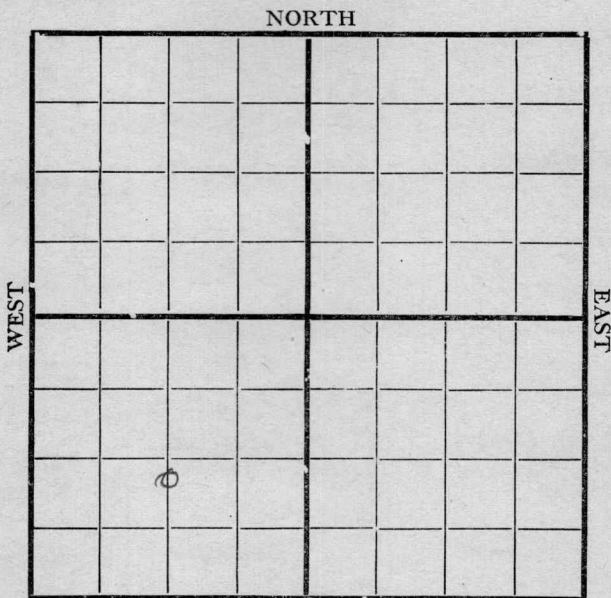

1320 W SOUTH 1120 S

Location _____

Rig up _____

Drilling and Remarks:

1450'

RECORD

Cased _____ in., _____ ft.

Sand _____

Gas _____

Oil _____

Total Depth _____

PRODUCTION

1st 24 hrs. Nat. _____

1st 24 hrs. after shot _____

Gas _____ Cu. Ft.

Dry Hole _____

Abandoned _____

Date


7/29 1919 Pyle Scout

Map No. K14 Sec. 8 Twp. 23 R. 4Well No. 3 Furman FarmDinclair Company

NORTH

WEST

EAST

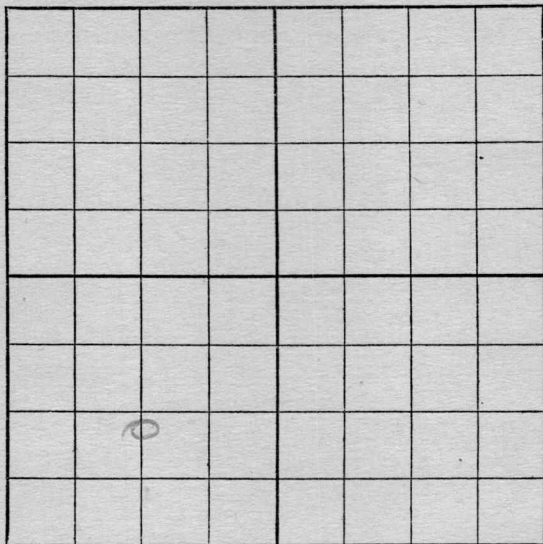1320 W SOUTH 1120 S

Location

Rig up

Drilling and Remarks:

1600'

RECORD

Cased in. Ft.

Sand

Gas

Oil

Total Depth

PRODUCTION

1st 24 hrs. Nat.

1st 24 hrs. after shot

Gas Cu. Ft.

Dry Hole

Abandoned

Date

8/4, 1919, Payle Scout


Map No. K14 Sec. 8 Twp. 23 R. 4Well No. 3 FurmanDisclair O & L Company

Contractor

NORTH

WEST

EAST

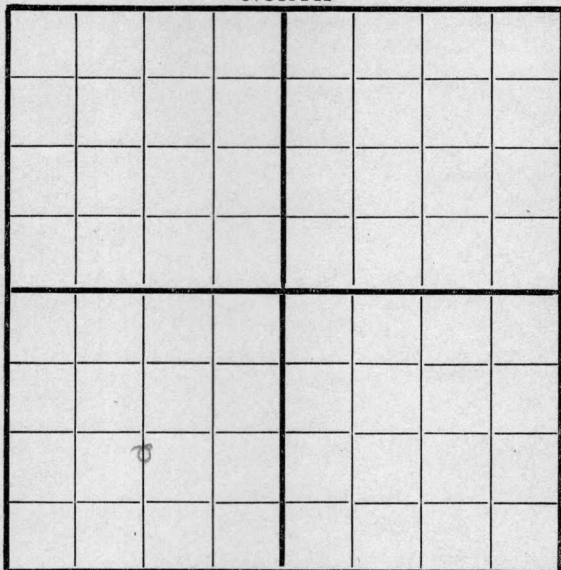

SOUTH

1320 W

1120 S

Location _____

Rig up _____

Drilling and Remarks:

1850'

RECORD

Cased _____ in., _____ ft.

Sand _____

Gas _____

Oil _____

Total Depth _____

PRODUCTION

1st 24 hrs. Nat. _____

1st 24 hrs. after shot _____

Gas _____ Cu. Ft.

Dry Hole _____

Abandoned _____

Date

8/11 1919


Pyle

Scout

Sec. 8 Twp. 23 Rge. 4
Owner Simclair O & L
Farm Furman Well No. 3
Contractor _____

Feet from lines, N. 1 E. _____ S. 120 W. 1320

Casing used _____
15½ _____ ft.
12½ _____ ft.
10 _____ ft.
8¼ _____ ft.
6⅝ _____ ft.
5 3-16 _____ ft.

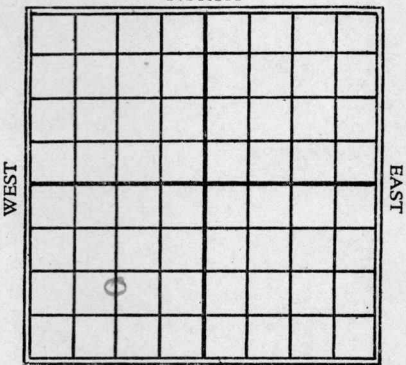

Location _____
Rig _____

Drilling at 2220' ft. Fishing at _____ ft.

Total Depth _____ Completed _____

1st 24 Hrs. Nat. _____ Producing _____

1st 24 Hrs. Shot _____ Dry Hole _____

Gas _____ Cu. ft. Abandoned _____

Sands — give name and depth. Top _____ Bottom _____

Date of Report 2/23
Reported by Pyle

Map No. K14 Sec. 8 Twp. 23 R. 4Well No. 3 FurnaceShinclair Oil Co. Company

Contractor

SECTION PLAT

Ft. from N. Line

112.0 Ft. from S. Line

Ft. from E. Line

1320 Ft. from W. Line

Location

Rig up

Drilling and Remarks:

2400'

RECORD

Cased _____ in., _____ ft.

Sand _____

Gas _____

Oil _____

Total Depth _____

PRODUCTION

1st 24 hrs. Nat. _____

1st 24 hrs. after shot _____

Gas _____ Cu. Ft.

Dry Hole _____

Abandoned _____

Date

8/30 1919Pyle

Scout

Map No. K 14 Sec. 8 Twp. 23 R. 4Well No. 3 FurmanSinclair Oil Company

Contractor

SECTION PLAT

Ft. from N. Line

1120 Ft. from S. Line

Ft. from E. Line

1320 Ft. from W. Line

Location

Rig up

Drilling and Remarks:

RECORD

Cased _____ in., _____ ft.

Sand 2404-2419

Gas _____

Oil _____

Total Depth _____

PRODUCTION

1st 24 hrs. Nat. 1200 bbls

1st 24 hrs. after shot _____

Gas _____ Cu. Ft.

Dry Hole _____

Abandoned _____

Date

Pyle

9/3 1919 Scout

Map No. K 14 Sec. 8 Twp. 23 R. 4Well No. 3 FurmanSinclair Oil Co. Company

Contractor

SECTION PLAT

Ft. from N. Line

1120 Ft. from S. Line

Ft. from E. Line

1320 Ft. from W. Line

Location

Rig up

Drilling and Remarks:

RECORD

Cased _____ in., _____ ft.

Sand 2404 - 2419

Gas _____

Oil _____

Total Depth _____

PRODUCTION

1st 24 hrs. Nat. 1200 bbls

1st 24 hrs. after shot _____

Gas _____ Cu. Ft.

Dry Hole _____

Abandoned _____

Date

9/8 191 9

Pyle

Scout