


Map No. _____ Sec. 10 Twp. 26 R. 4

Well No. #6 Belston Farm _____

Alpine Oil Company _____

NORTH

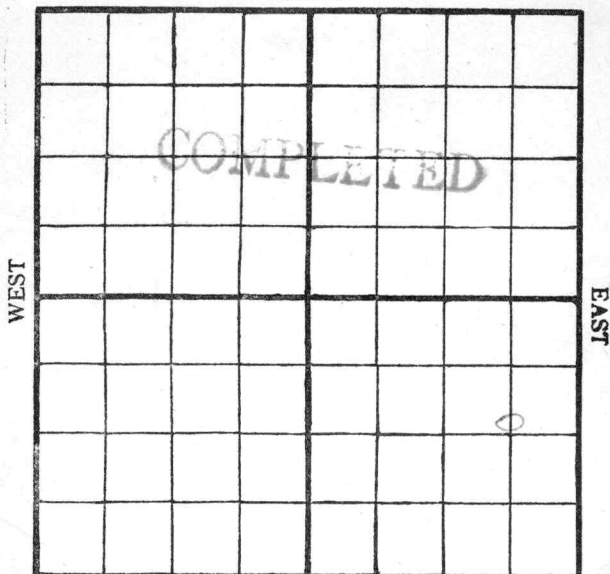

SOUTH

Location _____

Rig Up _____

Drilling Remarks:

Drilling Remarks:

RECORD

PRODUCTION

Cased _____ in. _____ ft.

1st 24 hrs. Nat. _____

Sand _____

1st 24 hrs. after shot _____

Gas _____

Gas _____ cu. ft

Oil _____

Dry Hole _____

Total Depth _____


Abandoned _____

Map No. _____ Sec. 10 Twp. 26 R. 4

Well No. 6 Ralston Farm

Alpine Oil Company

NORTH

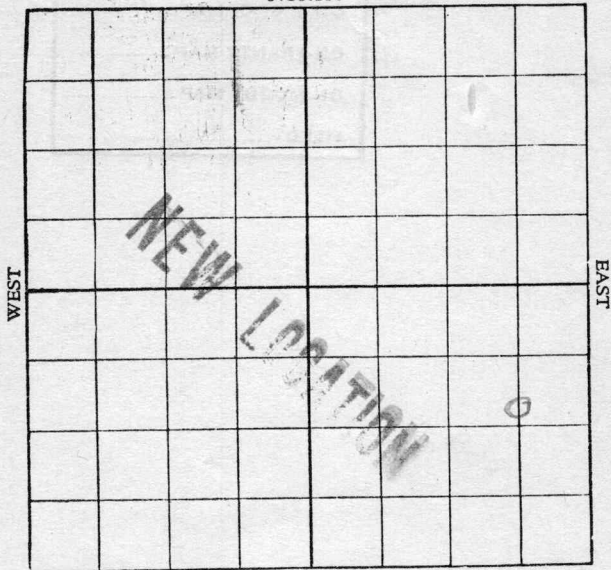

SOUTH

Location _____

Rig up _____

Drilling and remarks:

Rig.

RECORD

Cased _____ in. _____ Ft.

Sand _____

Gas _____

Oil _____

Total Depth _____

PRODUCTION

1st 24 hrs. Nat. _____

1st 24 hrs. after shot _____

Gas _____ Cu. Ft.

Dry Hole _____

Abandoned _____

Date

JUN 9 - 1917

191


E. J. Crocker

Scout

Map No. _____ Sec. 10 Twp. 26 R. 4
 Well No. 6 Ralston Farm
Alpine Oil Company

NORTH

WEST

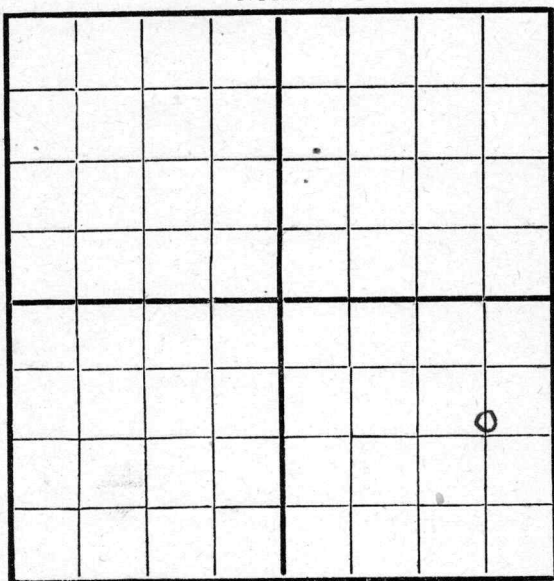

EAST

SOUTH

Location _____

Rig Up _____

Drilling and remarks

Rig

RECORD

Cased _____ in. _____ Ft.

Sand _____

Gas _____

Oil _____

Total Depth _____

PRODUCTION

1st 24 hrs. Nat. _____

1st 24 hrs. after shot _____

Gas _____ Cu. Ft.

Dry Hole _____

Abandoned _____


Date

JUN 16, 1917

C. J. Crocker
Scout

Map No. _____ Sec. 10 Twp. 26 R. 4
 Well No. 6 Ralston Farm _____
Alpine Oil Company _____

NORTH

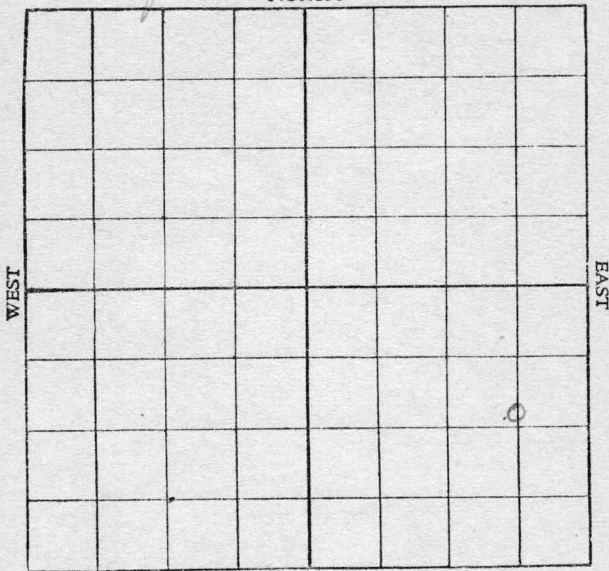

SOUTH

Location _____

Rig up _____

Drilling and remarks:

Rig

RECORD

Cased _____ in. _____ Ft.

Sand _____

Gas _____

Oil _____

Total Depth _____

PRODUCTION

1st 24 hrs. Nat. _____

1st 24 hrs. after shot _____

Gas _____ Cu. Ft.

Dry Hole _____

Abandoned _____

Date

JUN 22 1917


, 191

E. J. Crocker

Scout

Map No. _____ Sec. 10 Twp. 26 R. 4Well No. 6 Ralston FarmAlpine Oil Company

NORTH

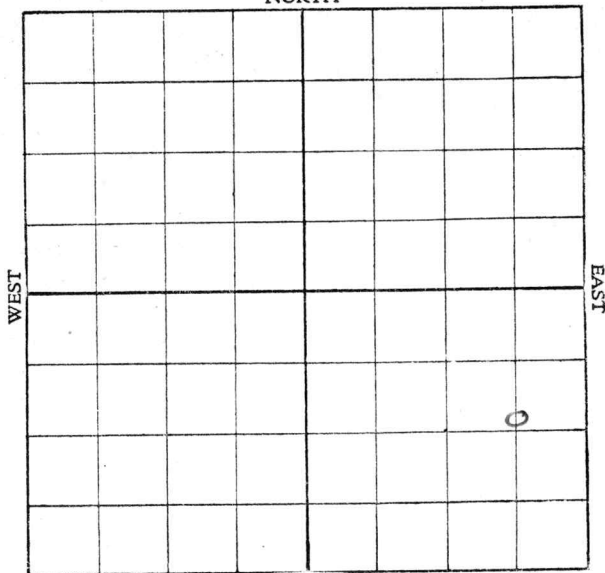

SOUTH

Location _____

Rig up _____

Drilling and remarks:

D-600'

RECORD

Cased _____ in. _____ Ft.

Sand _____

Gas _____

Oil _____

Total Depth _____

PRODUCTION

1st 24 hrs. Nat. _____

1st 24 hrs. after shot _____

Gas _____ Cu. Ft.

Dry Hole _____


Abandoned _____

Date JUN 30 1917

_____, 191____

C. J. Crook Scout

Map No. _____ Sec. 10 Twp. 26 R. 4
 Well No. 6 Ralston Farm
Alpine Company
 NORTH

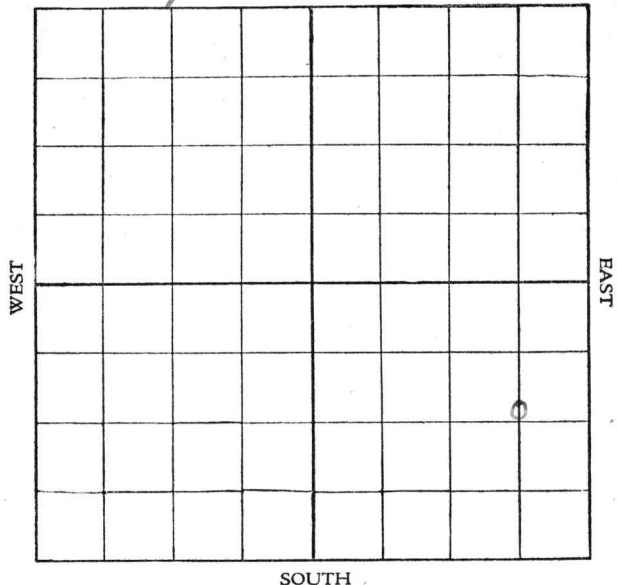

Location _____

Rig up _____

Drilling and remarks:

73-a-850

RECORD

Cased _____ in. _____ Ft.

Sand _____

Gas _____

Oil _____

Total Depth _____

PRODUCTION

1st 24 hrs. Nat. _____

1st 24 hrs. after shot _____

Gas _____ Cu. Ft.

Dry Hole _____

Abandoned _____


Date JUL 7 1917

, 191

C. T. Crocker Scout

Map No. _____ Sec. 10 Twp. 26 R. 4Well No. 6 Ralston Farm _____Alpine Oil Company

NORTH

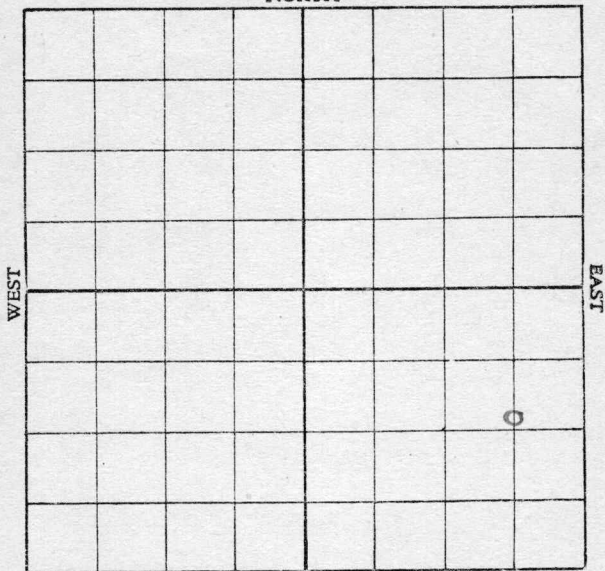

SOUTH

Location _____

Rig up _____

Drilling and remarks:

D-1540'

RECORD

Cased _____ in. _____ Ft.

Sand _____

Gas _____

Oil _____

Total Depth _____

PRODUCTION

1st 24 hrs. Nat. _____

1st 24 hrs. after shot _____

Gas _____ Cu. Ft.

Dry Hole _____

Abandoned _____

Date

JUL 14 1917

G. T. Crocker Scout

Map No. _____ Sec. 10 Twp. 26 R. 4
 Well No. 6 Palestine Farm _____
Alpine Company _____

NORTH

WEST EAST

SOUTH


Location _____ Rig Up _____ Drilling and remarks <u>2354</u>	RECORD
	Cased _____ in. _____ Ft.
	Sand _____
	Gas _____
	Oil _____
	Total Depth _____
	PRODUCTION
	1st 24 hrs. Nat. _____
	1st 24 hrs. after shot _____
	Gas _____ Cu. Ft.
	Dry Hole _____
	Abandoned _____

Date 8/1, 1917 Carroll Scout

Map No. K114 Sec. 10 Twp. 26 R. 4Well No. 6 Ralston Farm
Alpine Company

NORTH

WEST

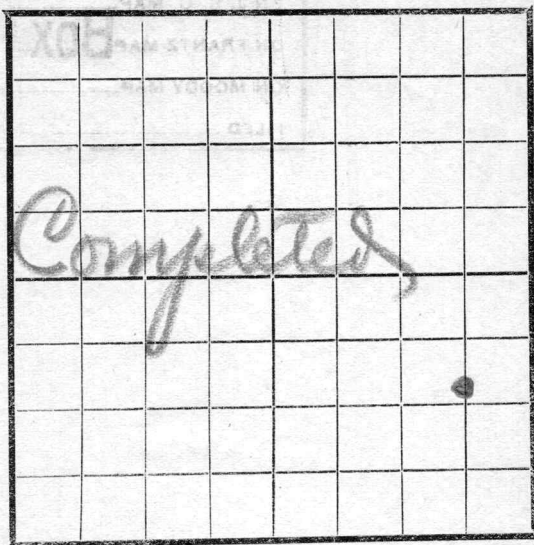

EAST

SOUTH

RECORD

Location -----

Cased ----- in ----- Ft.

Rig Up -----

Sand 2354 - 2368

Drilling and remarks

Gas -----

Oil -----

Total Depth -----

PRODUCTION

1st 24 hrs. Nat. -----

1st 24 hrs. after shot -----

Gas ----- Cu. Ft.

Dry Hole -----

Abandoned -----

Date

8/9, 1917 C. C. C. Scout

MAP No. KANSAS SEC. 10 TWP. 26 S. R. 4 E

WELL No. 6 Rolston

Alpine Oil COMPANY

CONTRACTOR

SECTION PLAT

ABANDONED

_____ FT. FROM N. LINE

_____ FT. FROM S. LINE

_____ FT. FROM E. LINE

_____ FT. FROM W. LINE

LOCATION _____

RIG UP _____

DRILLING AND REMARKS:

RECORD

CASED _____ IN. _____ FT.

SAND _____

GAS _____

OIL _____

TOTAL DEPTH 2406

PRODUCTION

1ST 24 HRS. NAT. _____

1ST 24 HRS. AFTER SHOT _____

GAS _____ CU. FT.

DRY HOLE _____

ABANDONED ☒

DATE

8-15 1917 SCOUT