
26

Form 51—5M—4-27—27423

Map No. KANSAS Sec. 27 Twp. 23 R. 13

Well No. 1 Berry Farm

Empire O + Ref Company

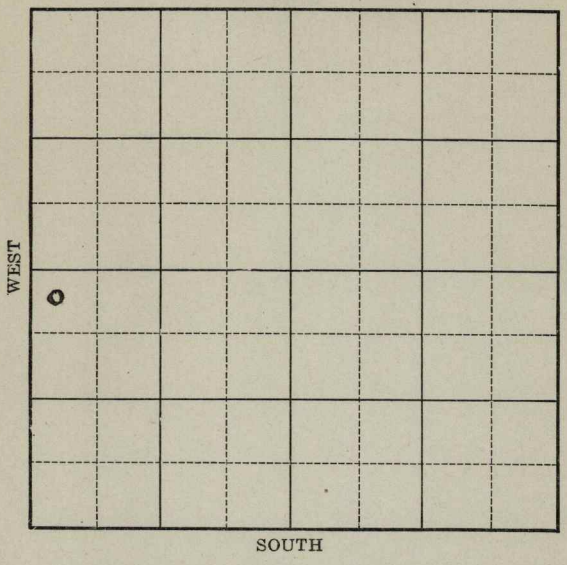

Location

Drilling Remarks

Rig Up

Drilling Remarks

RECORD

Cased in. ft.

Sand

Gas

Oil

Total Depth

PRODUCTION

1st 24 hrs. Nat.

1st 24 hrs. after shot

Gas cu. ft.

Dry Hole

Abandoned

Form 252A—5M—5-28—Mid-West 26

Map No. KANSAS Sec. ~~27~~ Twp. 23 R. 13

Well No. 1 – Berry Farm


Empire O. & R. Company

264 Ft. from N. Line

..... Ft. from S. Line

..... Ft. from E. Line

264 Ft. from W. Line

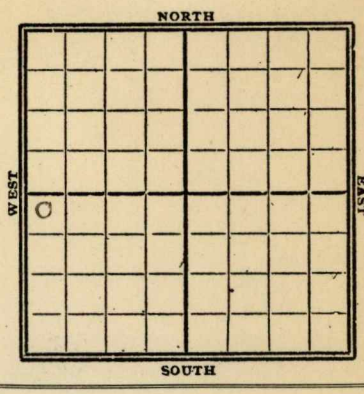

1928

Date	REPORT
7/25	Rigging up
8/2	Spudding
8/9	Drlg 405.
8/16	" 705
8/23	" 1160
8/28	Top lime 1786
	set 6" @ 1791 show oil 1804
	Drlg 1836'
9/5	Top lime 1786
	show @ 1804
	D & A @ 1877
	Aband

FORM 26 250 BKS. 4-28 WESTERN

Woodson

17 KANSAS

MAP NO. _____ SEC. 27 TWP. 23 R. 13

WELL NO. 1 Berry

Empire Dril Co. COMPANY

CONTRACTOR

FIRST REPORTS


764 FT. FROM N. LINE

_____ FT. FROM S. LINE

_____ FT. FROM E. LINE

764 FT. FROM W. LINE

SECTION PLAT

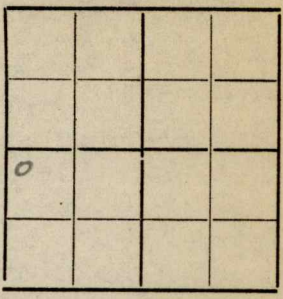

LOCATION _____

RIG UP _____

DRILLING AND REMARKS:

Rigging up

RECORD

CASED _____ IN., _____ FT.

SAND _____

GAS _____

OIL _____

TOTAL DEPTH _____

PRODUCTION

1ST 24 HRS. NAT. _____

1ST 24 HRS. AFTER SHOT _____

GAS _____ CU. FT.

DRY HOLE _____

ABANDONED _____

DATE

JUL 25 1928

CHAS. L. SHERWOOD

192 _____ SCOUT

FORM 26 250 BKS. 4-28 WESTERN

Woodson E

17 KANSAS

MAP NO. SEC. 36 TWP. 23 R. 13

WELL NO. 1 Berry

Empire Oil Co COMPANY

CONTRACTOR

CORRECTION


Not FT. FROM N. LINE

FT. FROM S. LINE

FT. FROM E. LINE

Not FT. FROM W. LINE

SECTION PLAT

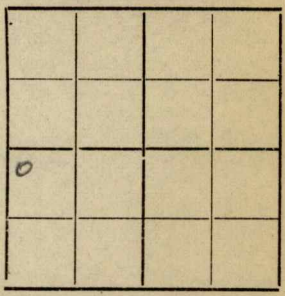

LOCATION

RIG UP Spudding

DRILLING AND REMARKS:

Prev reported in Sec 37. chg to Sec 36.

RECORD

CASED IN., FT.

SAND

GAS

OIL

TOTAL DEPTH

PRODUCTION

1ST 24 HRS. NAT.

1ST 24 HRS. AFTER SHOT

GAS CU. FT.

DRY HOLE

ABANDONED

DATE

AUG 1 1928

192

CHAS. L. SHERWOOD SCOUT

FORM 26 250 BKS. 4-28 WESTERN

Woodson

K17 KANSAS

MAP NO. _____ SEC. 26 TWP. 23 R. 13

WELL NO. 1 Berry


Cooper P&R Co

COMPANY

CONTRACTOR

COMPLETED

SECTION PLAT

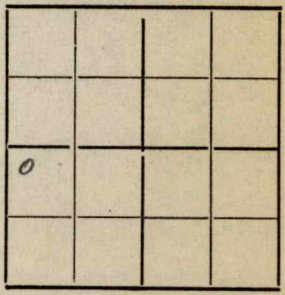

764 FT. FROM N. LINE

FT. FROM S. LINE

FT. FROM E. LINE

764 FT. FROM W. LINE

ABANDONED

LOCATION

RIG UP

DRILLING AND REMARKS:

Top Lime 1786'

Shale 1804'

D&A 1877

RECORD

CASED _____ IN., _____ FT.

SAND

GAS

OIL

TOTAL DEPTH 1877

PRODUCTION

1ST 24 HRS. NAT.

1ST 24 HRS. AFTER SHOT

GAS _____ CU. FT.

DRY HOLE V

ABANDONED

DATE SEP 5 1928

192

CHAS. L. SHERWOOD

SCOUT