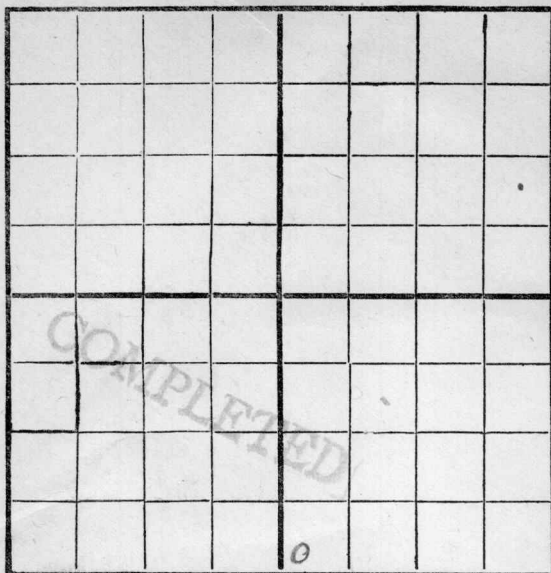


Map No. K 14 Sec. 8 Twp. 23 R. 4Well No. 9 Furman Farm
Sinclair Oil Co. Company

NORTH

WEST



EAST

SOUTH

Location -----

Rig Up -----

Drilling Remarks:

Drilling Remarks:

RECORD

Cased ----- in. ----- ft.

Sand -----

Gas -----

Oil -----

Total Depth -----

PRODUCTION

1st 24 hrs. Nat. -----

1st 24 hrs. after shot -----

Gas ----- cu. ft.

Dry Hole -----

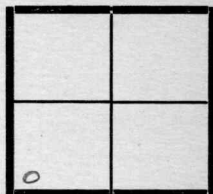
Abandoned -----

Map No. _____ Sec. 8 Twp. 23 R. 4Well No. 9 Turner Farm
Sinclair Oil Co. CompanyContractor
SE Quarter

_____ Ft. from N. Line

200 Ft. from S. Line

_____ Ft. from E. Line

200 Ft. from W. LineDate 1/19/14

REPORT

10/11 Drly. 1725'10/21 Dr. 1825'10/31 Drly. 2100'11/4 Set Boiler Tub. 210012 Set 5" Top Sand 237619 Top sand 2376 pulling 10"26 2412-2419' - 200 Bbl.

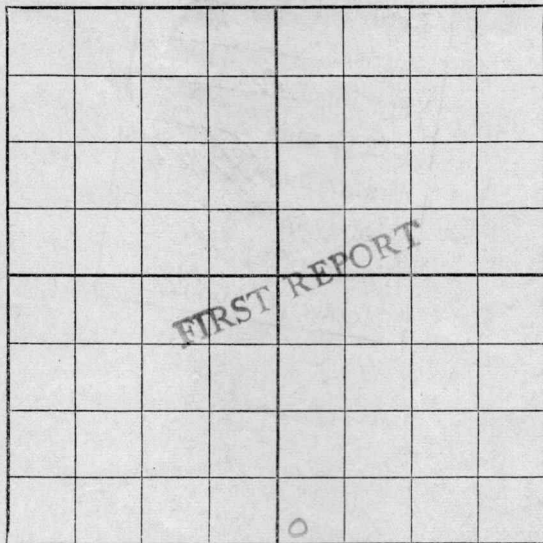
COMPLETED

Map No. K14 Sec. 8 Twp. 23 R. 4Well No. 9 Furman FarmSinclair O & G Company

NORTH

WEST

EAST

2005-W SOUTH

Location

Rig up ☒

Drilling and Remarks:

RECORD

Cased in. Ft.

Sand

Gas

Oil

Total Depth

PRODUCTION

1st 24 hrs. Nat.

1st 24 hrs. after shot

Gas Cu. Ft.

Dry Hole

Abandoned

Date

8/25, 1919, Pyle Scout

Map No. K-14 Sec. 8 Twp. 23 R. 4Well No. 9 FurnaceSmclair Oil Company

Contractor

SECTION PLAT

Ft. from N. Line

200 Ft. from S. Line

Ft. from E. Line

200 Ft. from W. Line

		o	.

Location

Rig up

Drilling and Remarks:

Tools

RECORD

Cased _____ in., _____ ft.

Sand _____

Gas _____

Oil _____

Total Depth _____

PRODUCTION

1st 24 hrs. Nat. _____

1st 24 hrs. after shot _____

Gas _____ Cu. Ft.

Dry Hole _____

Abandoned _____

Date

9/2 1919 Pyle Scout

Map No. 514 Sec. 8 Twp. 23 R. 4Well No. 9 FurnaceShelton Oil Company

Contractor

SECTION PLAT

Ft. from N. Line

200 Ft. from S. Line

Ft. from E. Line

200 Ft. from W. Line

		0	

Location

Rig up

Drilling and Remarks:

RECORD

Cased _____ in., _____ ft.

Sand _____

Gas _____

Oil _____

Total Depth _____

PRODUCTION

1st 24 hrs. Nat. _____

1st 24 hrs. after shot _____

Gas _____ Cu. Ft.

Dry Hole _____

Abandoned _____

Date

9/8 191 9 Scout

Pyle

Map No. K 14 Sec. 8 Twp. 23 R. 4Well No. 9 FurmanSinclair's Company

Contractor

SECTION PLAT

		0	

Ft. from N. Line

200 Ft. from S. Line

Ft. from E. Line

200 Ft. from W. Line

Location

Rig up

Drilling and Remarks:

350'

RECORD

Cased _____ in., _____ ft.

Sand _____

Gas _____

Oil _____

Total Depth _____

PRODUCTION

1st 24 hrs. Nat. _____

1st 24 hrs. after shot _____

Gas _____ Cu. Ft.

Dry Hole _____

Abandoned _____

Date

9/15 1919

Pyle

Scout

Map No. K14 Sec. 8 Twp. 23 R. 4Well No. 9 Freiman Sinclair Company

Contractor

SECTION PLAT

Ft. from N. Line

200 Ft. from S. Line

Ft. from E. Line

200 Ft. from W. Line

RECORD

Location -----

Cased ----- in., ----- ft.

Rig up -----

Sand -----

Drilling and Remarks:

Gas -----

Oil -----

Total Depth -----

PRODUCTION

1st 24 hrs. Nat. -----

1st 24 hrs. after shot -----

Gas ----- Cu. Ft.

Dry Hole -----

Abandoned -----

Date

9/23 1919 Pyle Scout

Map No. K14 Sec. 8 Twp. 23 R. 4Well No. 9 FurmanSinclair Company

Contractor

SECTION PLAT

Ft. from N. Line

200 Ft. from S. Line

Ft. from E. Line

200 Ft. from W. Line

Location

Rig up

Drilling and Remarks:

RECORD

Cased _____ in., _____ ft.

Sand _____

Gas _____

Oil _____

Total Depth _____

PRODUCTION

1st 24 hrs. Nat. _____

1st 24 hrs. after shot _____

Gas _____ Cu. Ft.

Dry Hole _____

Abandoned _____

Date

9/30 1919

Pyle

Scout

Map No. K 14 Sec. 8 Twp. 23 R. 4

Well No. 9 Furman

Sinclair Company

Contractor

SECTION PLAT

----- Ft. from N. Line

200 Ft. from S. Line

----- Ft. from E. Line

200 Ft. from W. Line

Location -----

Rig up -----

Drilling and Remarks:

1725 Dry.

RECORD

Cased ----- in., ----- ft.

Sand -----

Gas -----

Oil -----

Total Depth -----

PRODUCTION

1st 24 hrs. Nat. -----

1st 24 hrs. after shot -----

Gas ----- Cu. Ft.

Dry Hole -----

Abandoned -----

Date

10/14 1919

Pyle

Scout

Map No. K 14 Sec. 8 Twp. 23 R. 4Well No. 9 FurmanSinclair Oil Co. Company

Contractor

SECTION PLAT

		0	

----- Ft. from N. Line

200 ----- Ft. from S. Line

----- Ft. from E. Line

200 ----- Ft. from W. Line

RECORD

Location -----

Cased ----- in., ----- ft.

Rig up -----

Sand -----

Drilling and Remarks:

Gas -----

Oil -----

Total Depth -----

PRODUCTION

1st 24 hrs. Nat. -----

1st 24 hrs. after shot -----

Gas ----- Cu. Ft.

Dry Hole -----

Abandoned -----

Date

Pyle

10/21 1919

Scout

Map No. 1514 Sec. 8 Twp. 23 R. 4Well No. 9 FurmanSinclair Oil Co. Company

Contractor

SECTION PLAT

Ft. from N. Line

200 Ft. from S. Line

Ft. from E. Line

200 Ft. from W. Line

RECORD

Location

Cased _____ in., _____ ft.

Rig up

Sand 2412-2419

Drilling and Remarks:

Gas _____

Oil _____

Total Depth _____

PRODUCTION

1st 24 hrs. Nat. 200 bbls

1st 24 hrs. after shot _____

Gas _____ Cu. Ft.

Dry Hole _____

Abandoned _____

Date

Pyle

11/25 191 9

Scout