
Form 51—5-17—2M

Map No. _____ Sec. 2 Twp. 26 R. 4

Well No. 14-Dawson Farm

Empire Company

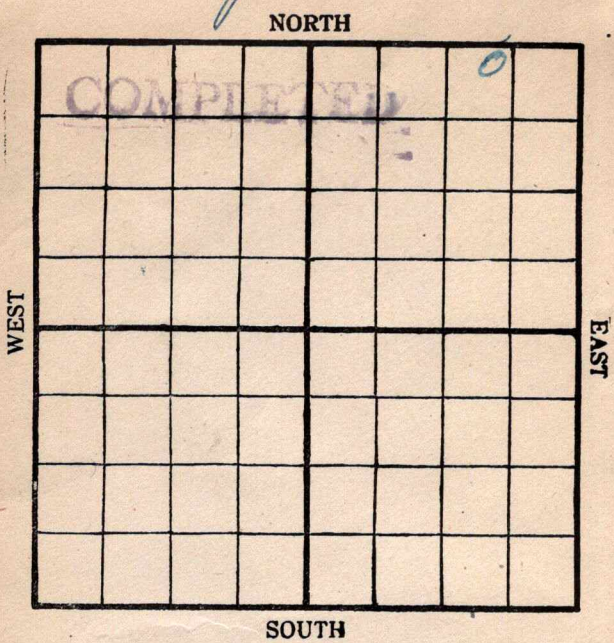

Location _____

Drilling Remarks:

Rig Up _____

Drilling Remarks:

RECORD

Cased _____ in. _____ ft.

Sand _____

Gas _____

Oil _____

Total Depth _____

PRODUCTION

1st 24 hrs. Nat. _____

1st 24 hrs. after shot _____

Gas _____ cu. ft

Dry Hole _____

Abandoned _____


Form 26—1M Books of 100 Sheets Each.

Map No._____ Sec. 2 Twp. 26 R. 4

Well No. 14 Paulson Farm

Empire Company

NORTH

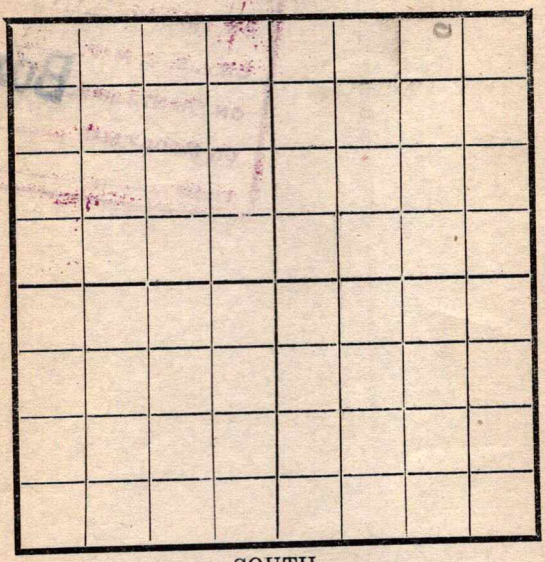

WEST EAST

SOUTH

Location ✓

Rig Up ✓

Drilling and remarks

FIRST REPORT

RECORD

Cased_____ in._____Ft.

Sand _____

Gas _____

Oil _____

Total Depth _____

PRODUCTION

1st 24 hrs. Nat._____

1st 24 hrs. after shot_____

Gas _____ Cu. Ft.

Dry Hole _____

Abandoned _____

Date

8/17, 1912. Randolph Scout


Form 26—1M Books of 100 Sheets Each.

Map No._____ Sec. 2 Twp. 26 R. 4

Well No. 14. Paulsen Farm

Empire Company

NORTH

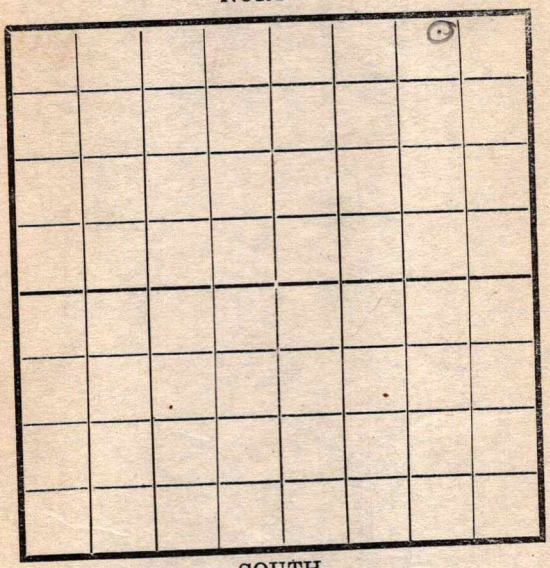

WEST

EAST

SOUTH

Location _____

Rig Up ✓

Drilling and remarks

RECORD

Cased _____ in. _____ Ft.

Sand _____

Gas _____

Oil _____

Total Depth _____

PRODUCTION

1st 24 hrs. Nat. _____

1st 24 hrs. after shot _____

Gas _____ Cu. Ft.

Dry Hole _____

Abandoned _____

Date

8-23, 1917. Lantz Scout


Form T-135-2-14-17-2m. Books, 50 Sets to Book

Map No. _____ Sec. 2 Twp. 26 R. 4

Well No. 14 Paulsen Farm

Engine Company

NORTH

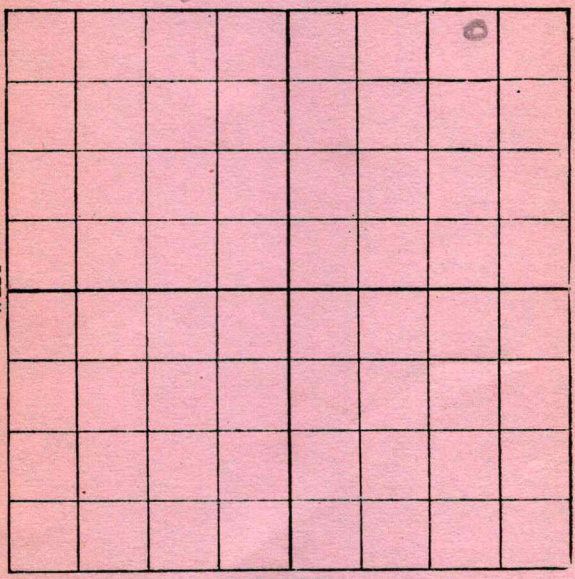

SOUTH

Location _____

Rig up _____

Drilling and remarks:

3280

RECORD

Cased _____ in. _____ Ft.

Sand _____

Gas _____

Oil _____

Total Depth _____

PRODUCTION

1st 24 hrs. Nat. _____

1st 24 hrs. after shot _____

Gas _____ Cu. Ft

Dry Hole _____

Abandoned _____

Date

10/9, 1917, Randy Scout


Form 26—1M Books of 100 Sheets Each.

Map No._____ Sec. 2 Twp. 26 R. 4

Well No. 14 Paulson Farm

Empire Company

NORTH

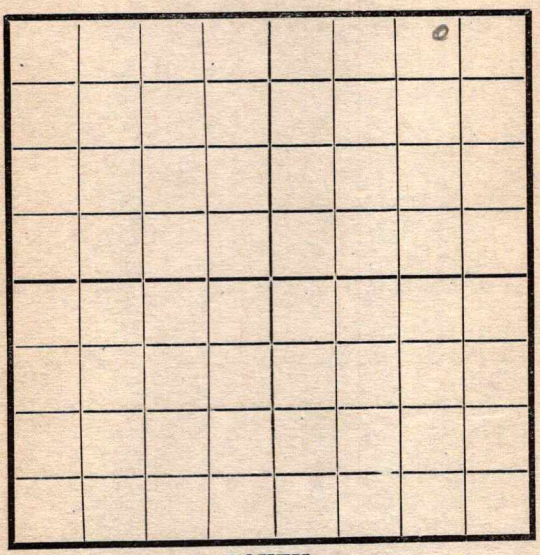

WEST EAST

SOUTH

Location _____

Rig Up _____

Drilling and remarks

Top sand 2355

Shut Down for water

RECORD

Cased _____ in. _____ Ft.

Sand _____

Gas _____

Oil _____

Total Depth _____

PRODUCTION

1st 24 hrs. Nat. _____

1st 24 hrs. after shot _____

Gas _____ Cu. Ft.

Dry Hole _____

Abandoned _____

Date

10/17, 1917 Scout


Form 26—1M Books of 100 Sheets Each.

Map No. K14 Sec. 2 Twp. 26 R. 4

Well No. 14 Paulson Farm

Empire Company

NORTH

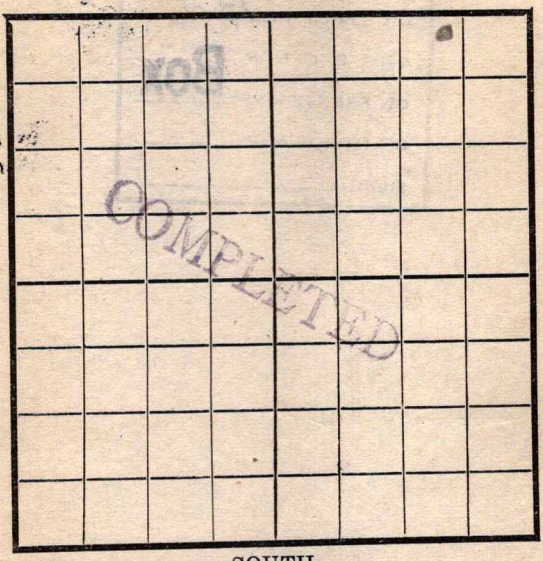

WEST EAST

SOUTH

Location

Rig Up

Drilling and remarks

Est at
400 Bbls

RECORD

Cased in. Ft.

Sand 2360-2431

Gas

Oil

Total Depth

PRODUCTION

1st 24 hrs. Nat.

1st 24 hrs. after shot

Gas Cu. Ft.

Dry Hole

Abandoned

Date

10/24, 1912. Scout