

Company Branine & Goering

NORTH

WEST

EAST

**SOUTH**

Butler

Sec. 29 **KANSAS** Twp. 23 R. 4-E

Well No. #1 Feerier Farm

Branine & Goering Company

Miscellaneous


330' Ft. from N. Line

Ft. from S. Line

330' Ft. from E. Line

Ft. from W. Line

NE NW

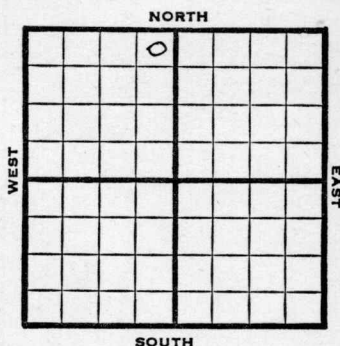

1947

# REPORT

11/12 8" @ 30'  
Drlg. 1340'

11/19 "

11/25 Lansing 1727'  
KC 1958'  
TD 2048'  
5" @ 2048'  
RUST

12/3 "

12/10 TD 2081' - 1000 acid.

12/17 K C 1958'  
5" @ 2048'  
1000 acid  
Pump 250 Pot  
Gravity 38  
TD 2081'

COMPLETED

Map No. \_\_\_\_\_ Sec. 29 Twp. 23 R. 4E

Well No. 1 Feerier

Branine & Goering Company

FIRST REPORT Contractor

NE NW

SECTION PLAT

330 Ft. from N. Line

\_\_\_\_\_ Ft. from S. Line

330 Ft. from E. Line

\_\_\_\_\_ Ft. from W. Line

|  |   |  |  |
|--|---|--|--|
|  | 0 |  |  |
|  |   |  |  |
|  |   |  |  |
|  |   |  |  |
|  |   |  |  |

Butler County

Location \_\_\_\_\_

Rig up \_\_\_\_\_

Drilling and Remarks:

8" @ 30

drlg. 1340

RECORD

Cased \_\_\_\_\_ in., \_\_\_\_\_ ft.

Sand \_\_\_\_\_

Gas \_\_\_\_\_

Oil \_\_\_\_\_

Total Depth \_\_\_\_\_

PRODUCTION

1st 24 hrs. Nat. \_\_\_\_\_

1st 24 hrs. after shot \_\_\_\_\_

Gas \_\_\_\_\_ Cu. Ft.

Dry Hole \_\_\_\_\_

Abandoned \_\_\_\_\_

Date

NOV 1 2 1947 19 \_\_\_\_\_ S. J. LEWIS Scout

Map No. 14 Sec. 29 Twp. 23 R. 4E

Well No. 1 Ferrier

Branine & Goering Company

**COMPLETE**

Contractor

NE NW


**SECTION PLAT**

330 Ft. from N. Line

         Ft. from S. Line

330 Ft. from E. Line

         Ft. from W. Line

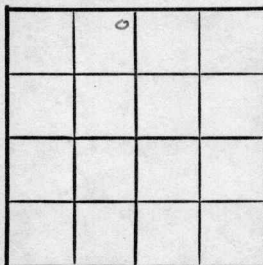

Butler County

Location                                 

Rig up                                 

Drilling and Remarks:

*KC 1958*

*5' @ 2048*

*1000 acid*

*Pump 2500 BT*

*2500 BT*

**RECORD**

Cased          in.,          ft.

Sand                                 

Gas                                 

Oil                                 

Total Depth 2087

**PRODUCTION**

1st 24 hrs. Nat.                                 

1st 24 hrs. after shot                                 

Gas                                  Cu. Ft.

Dry Hole                                 

Abandoned                                 

Date

DEC 17 1947 19

S. J. LEWIS

Scout