


Map No. \_\_\_\_\_ Sec. 8 Twp. 23 R. 4  
 Well No. 4 Furman Farm  
Sinclair Oil Co. Company

NORTH

WEST

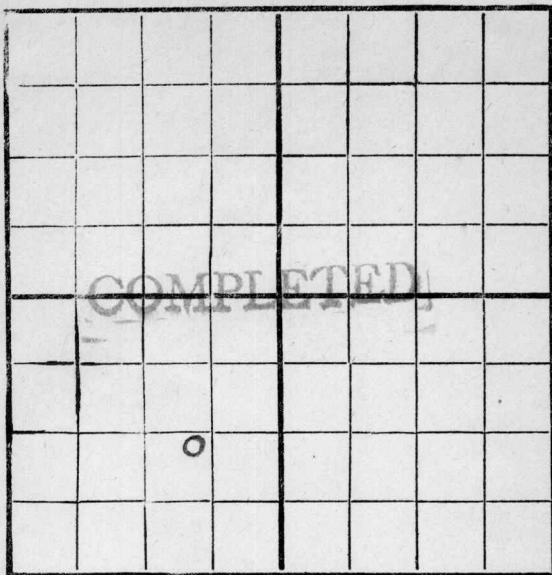

EAST

SOUTH

Location \_\_\_\_\_

Rig Up \_\_\_\_\_

Drilling Remarks:

Drilling Remarks:

## RECORD

Cased \_\_\_\_\_ in. \_\_\_\_\_ ft.

Sand \_\_\_\_\_

Gas \_\_\_\_\_

Oil \_\_\_\_\_

Total Depth \_\_\_\_\_

## PRODUCTION

1st 24 hrs. Nat. \_\_\_\_\_

1st 24 hrs. after shot \_\_\_\_\_

Gas \_\_\_\_\_ cu. ft.

Dry Hole \_\_\_\_\_

Abandoned \_\_\_\_\_


Map No. K14 Sec. 8 Twp. 23 R. 4Well No. 4 Gorman  
Sinclair O & S. Company

Contractor

NORTH

WEST

EAST

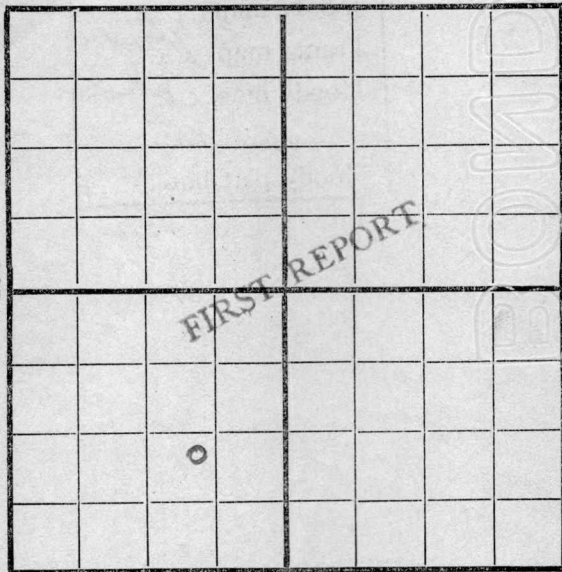

760 E SOUTH 1120 S

Location \_\_\_\_\_

Rig up ☒ \_\_\_\_\_

Drilling and Remarks:

## RECORD

Cased \_\_\_\_\_ in., \_\_\_\_\_ ft.

Sand \_\_\_\_\_

Gas \_\_\_\_\_

Oil \_\_\_\_\_

Total Depth \_\_\_\_\_

## PRODUCTION

1st 24 hrs. Nat. \_\_\_\_\_

1st 24 hrs. after shot \_\_\_\_\_

Gas \_\_\_\_\_ Cu. Ft.

Dry Hole \_\_\_\_\_

Abandoned \_\_\_\_\_

Date

7/1

1919


Scout

Map No. K14 Sec. 8 Twp. 23 R. 1  
 Well No. 4 Furman  
Sinclair Oil Co. Company  
 Contractor

NORTH

WEST

EAST

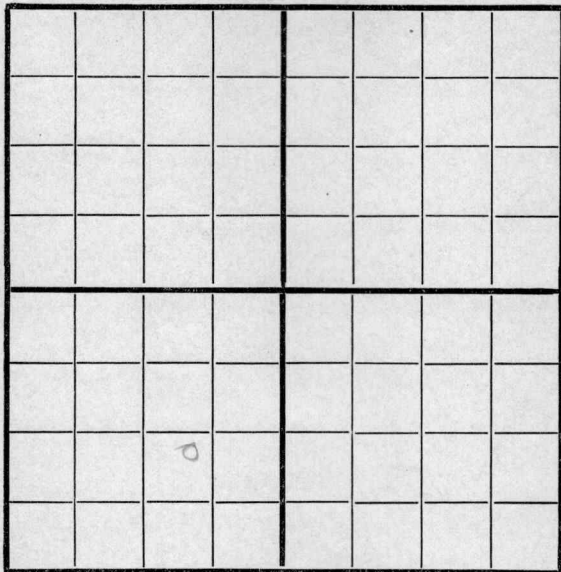

SOUTH

760 E

1120 S

Location \_\_\_\_\_

Rig up. ☒ \_\_\_\_\_

Drilling and Remarks:

**RECORD**

Cased \_\_\_\_\_ in., \_\_\_\_\_ ft.

Sand \_\_\_\_\_

Gas \_\_\_\_\_

Oil \_\_\_\_\_

Total Depth \_\_\_\_\_

**PRODUCTION**

1st 24 hrs. Nat. \_\_\_\_\_

1st 24 hrs. after shot \_\_\_\_\_

Gas \_\_\_\_\_ Cu. Ft.

Dry Hole \_\_\_\_\_

Abandoned \_\_\_\_\_

Date

7/12 1919 Scout


Map No. K14 Sec. 8 Twp. 23 R. 4Well No. 4 Furnace  
Sinclair Oil Co. Company

Contractor

NORTH

WEST

EAST

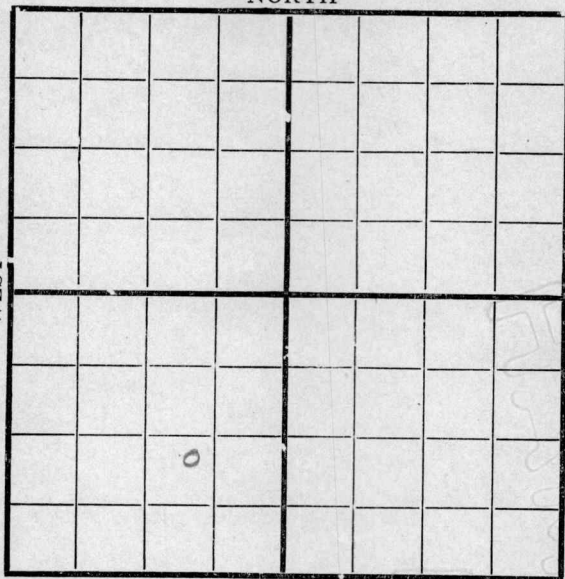

SOUTH

760 E

1120 S

Location \_\_\_\_\_

Rig up ☒

Drilling and Remarks:

## RECORD

Cased \_\_\_\_\_ in., \_\_\_\_\_ ft.

Sand \_\_\_\_\_

Gas \_\_\_\_\_

Oil \_\_\_\_\_

Total Depth \_\_\_\_\_

## PRODUCTION

1st 24 hrs. Nat. \_\_\_\_\_

1st 24 hrs. after shot \_\_\_\_\_

Gas \_\_\_\_\_ Cu. Ft.

Dry Hole \_\_\_\_\_

Abandoned \_\_\_\_\_

Date

7/16 1919

Oyle Scout


Map No. 15/4 Sec. 8 Twp. 23 R. 4Well No. 4 FurmanCompany Shinclair

Contractor \_\_\_\_\_

NORTH

WEST

EAST

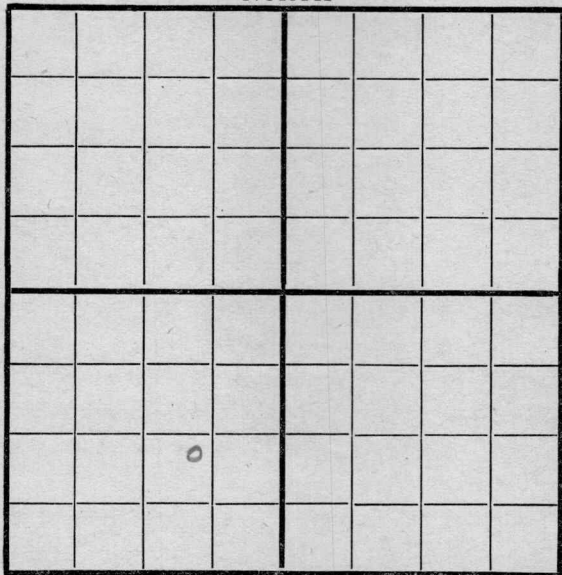

SOUTH

Location \_\_\_\_\_

Rig up ☒

Drilling and Remarks:

## RECORD

Cased \_\_\_\_\_ in., \_\_\_\_\_ ft.

Sand \_\_\_\_\_

Gas \_\_\_\_\_

Oil \_\_\_\_\_

Total Depth \_\_\_\_\_

## PRODUCTION

1st 24 hrs. Nat. \_\_\_\_\_

1st 24 hrs. after shot \_\_\_\_\_

Gas \_\_\_\_\_ Cu. Ft.

Dry Hole \_\_\_\_\_

Abandoned \_\_\_\_\_

Date

191

9

Oyle

Scout


Map No. K14 Sec. 8 Twp. 23 R. 4Well No. 4 FurnaceSinclair Company

Contractor

NORTH

WEST

EAST

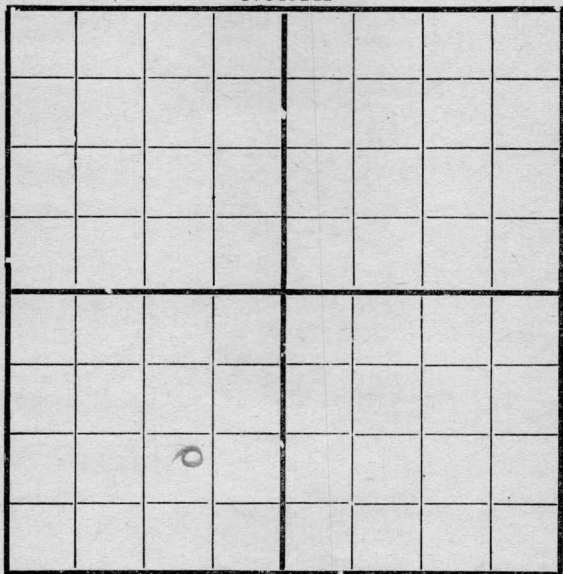

SOUTH

760 E 11205

Location \_\_\_\_\_

Rig up ☒ \_\_\_\_\_

Drilling and Remarks:

## RECORD

Cased \_\_\_\_\_ in., \_\_\_\_\_ ft.

Sand \_\_\_\_\_

Gas \_\_\_\_\_

Oil \_\_\_\_\_

Total Depth \_\_\_\_\_

## PRODUCTION

1st 24 hrs. Nat. \_\_\_\_\_

1st 24 hrs. after shot \_\_\_\_\_

Gas \_\_\_\_\_ Cu. Ft.

Dry Hole \_\_\_\_\_

Abandoned \_\_\_\_\_

Date


7/29 1919 Pyle Scout

Map No. K14 Sec. 8 Twp. 23 R. 4Well No. 4 Furman FarmDimclair Company

NORTH

WEST

EAST

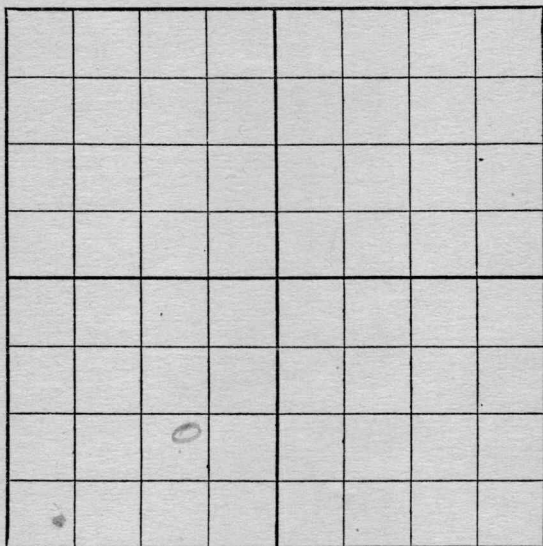

SOUTH

Location 760 ERig up ☒

Drilling and Remarks:

## RECORD

Cased \_\_\_\_\_ in. \_\_\_\_\_ Ft.

Sand \_\_\_\_\_

Gas \_\_\_\_\_

Oil \_\_\_\_\_

Total Depth \_\_\_\_\_

## PRODUCTION

1st 24 hrs. Nat. \_\_\_\_\_

1st 24 hrs. after shot \_\_\_\_\_

Gas \_\_\_\_\_ Cu. Ft.

Dry Hole \_\_\_\_\_

Abandoned \_\_\_\_\_

Date

8/4, 1919, Pyle Scout


Map No. K 14 Sec. 8 Twp. 23 R. 4Well No. 4 FurnaceSinclair Company

Contractor

NORTH

WEST

EAST

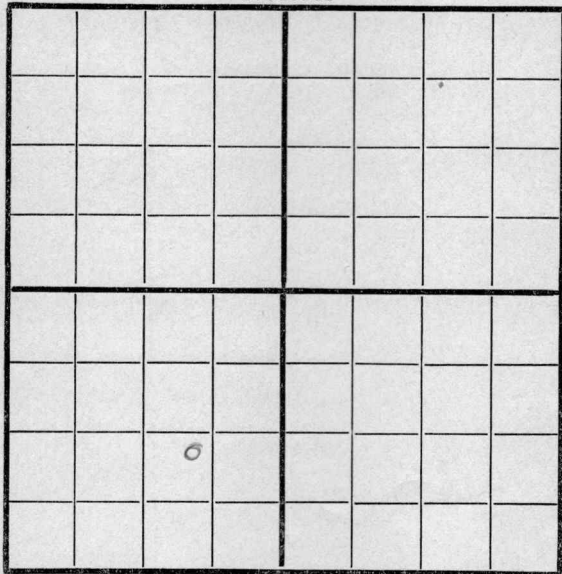

SOUTH

760 E

1120 S

Location \_\_\_\_\_

Rig up ☒

Drilling and Remarks:

## RECORD

Cased \_\_\_\_\_ in., \_\_\_\_\_ ft.

Sand \_\_\_\_\_

Gas \_\_\_\_\_

Oil \_\_\_\_\_

Total Depth \_\_\_\_\_

## PRODUCTION

1st 24 hrs. Nat. \_\_\_\_\_

1st 24 hrs. after shot \_\_\_\_\_

Gas \_\_\_\_\_ Cu. Ft.

Dry Hole \_\_\_\_\_

Abandoned \_\_\_\_\_

Date

8/

191 9


Pyle

Scout

Sec. 8 Twp. 23 Rge. 4  
Owner Dimclair O & L  
Farm Furman Well No. 4  
Contractor \_\_\_\_\_

Feet from lines, N. \_\_\_\_\_ E. 760 S. 1120 W. \_\_\_\_\_

Casing used \_\_\_\_\_  
15½ \_\_\_\_\_ ft.  
12½ \_\_\_\_\_ ft.  
10 \_\_\_\_\_ ft.  
8¼ \_\_\_\_\_ ft.  
6⅝ \_\_\_\_\_ ft.  
5 3-16 \_\_\_\_\_ ft.  
Location \_\_\_\_\_  
Rig \_\_\_\_\_

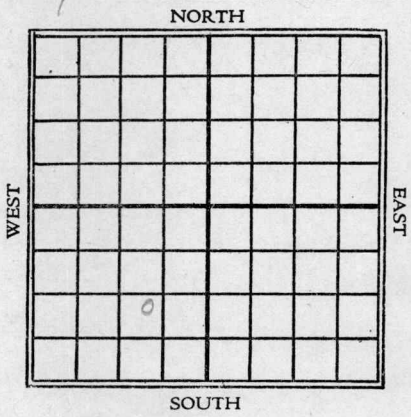

Drilling at \_\_\_\_\_ ft. Fishing at \_\_\_\_\_ ft.  
Total Depth \_\_\_\_\_ Completed \_\_\_\_\_  
1st 24 Hrs. Nat. \_\_\_\_\_ Producing \_\_\_\_\_  
1st 24 Hrs. Shot \_\_\_\_\_ Dry Hole \_\_\_\_\_  
Gas \_\_\_\_\_ Cu. ft. Abandoned \_\_\_\_\_  
Sands — give name and depth. Top \_\_\_\_\_ Bottom \_\_\_\_\_

Spud

Date of Report 8/23  
Reported by Pyle

Map No. \_\_\_\_\_ Sec. 8 Twp. 23 R. 4Well No. 4 FurmanShickel Company

Contractor

## SECTION PLAT

\_\_\_\_\_ Ft. from N. Line

1120 Ft. from S. Line760 Ft. from E. Line

\_\_\_\_\_ Ft. from W. Line

|  |           |  |  |
|--|-----------|--|--|
|  |           |  |  |
|  |           |  |  |
|  |           |  |  |
|  | <u>10</u> |  |  |

Location \_\_\_\_\_

Rig up \_\_\_\_\_

Drilling and Remarks:

8/23  
Spd g

## RECORD

Cased \_\_\_\_\_ in., \_\_\_\_\_ ft.

Sand \_\_\_\_\_

Gas \_\_\_\_\_

Oil \_\_\_\_\_

Total Depth \_\_\_\_\_

## PRODUCTION

1st 24 hrs. Nat. \_\_\_\_\_

1st 24 hrs. after shot \_\_\_\_\_

Gas \_\_\_\_\_ Cu. Ft.

Dry Hole \_\_\_\_\_

Abandoned \_\_\_\_\_

Date

8/23 191 9 offici Scout

Map No. K14 Sec. 8 Twp. 23 R. 4

Well No. 4 Furman  
Sinclair O & L Company

Contractor

SECTION PLAT

-----Ft. from N. Line

1120 Ft. from S. Line

760 Ft. from E. Line

-----Ft. from W. Line

|  |   |  |  |
|--|---|--|--|
|  |   |  |  |
|  |   |  |  |
|  |   |  |  |
|  | o |  |  |

Location -----

Rig up -----

Drilling and Remarks:

*Spud*

RECORD

Cased ----- in., ----- ft.

Sand -----

Gas -----

Oil -----

Total Depth -----

PRODUCTION

1st 24 hrs. Nat. -----

1st 24 hrs. after shot -----

Gas ----- Cu. Ft.

Dry Hole -----

Abandoned -----

Date 8/30 1919

Pyle Scout

Map No. K14 Sec. 8 Twp. 23 R. 4Well No. 4 FurnaceSinclair Oil Co. Company

Contractor

## SECTION PLAT

Ft. from N. Line

1120 Ft. from S. Line760 Ft. from E. Line

Ft. from W. Line

|  |   |  |  |
|--|---|--|--|
|  |   |  |  |
|  |   |  |  |
|  |   |  |  |
|  | 0 |  |  |

Location

Rig up

Drilling and Remarks:

*Spud*

## RECORD

Cased \_\_\_\_\_ in., \_\_\_\_\_ ft.

Sand \_\_\_\_\_

Gas \_\_\_\_\_

Oil \_\_\_\_\_

Total Depth \_\_\_\_\_

## PRODUCTION

1st 24 hrs. Nat. \_\_\_\_\_

1st 24 hrs. after shot \_\_\_\_\_

Gas \_\_\_\_\_ Cu. Ft.

Dry Hole \_\_\_\_\_

Abandoned \_\_\_\_\_

Date

9/2 1919

Pyle

Scout

Map No. K 14 Sec. 8 Twp. 23 R. 4

Well No. 4 Furman  
Sinclair Oil Company

Contractor

SECTION PLAT

|  |   |  |  |
|--|---|--|--|
|  |   |  |  |
|  |   |  |  |
|  |   |  |  |
|  | o |  |  |

-----Ft. from N. Line

1120 Ft. from S. Line

760 Ft. from E. Line

-----Ft. from W. Line

Location -----

Rig up -----

Drilling and Remarks:

12 1/2 @ 820'

RECORD

Cased ----- in., ----- ft.

Sand -----

Gas -----

Oil -----

Total Depth -----

PRODUCTION

1st 24 hrs. Nat. -----

1st 24 hrs. after shot -----

Gas ----- Cu. Ft.

Dry Hole -----

Abandoned -----

Date 9/9 1919 Pyle Scout

Map No. K14 Sec. 8 Twp. 23 R. 4Well No. 4 FurnmanShelton Company

Contractor

## SECTION PLAT

Ft. from N. Line

1120 Ft. from S. Line760 Ft. from E. Line

Ft. from W. Line

|  |   |  |  |
|--|---|--|--|
|  |   |  |  |
|  |   |  |  |
|  |   |  |  |
|  | 0 |  |  |

Location

Rig up

Drilling and Remarks:

1260'

## RECORD

Cased \_\_\_\_\_ in., \_\_\_\_\_ ft.

Sand \_\_\_\_\_

Gas \_\_\_\_\_

Oil \_\_\_\_\_

Total Depth \_\_\_\_\_

## PRODUCTION

1st 24 hrs. Nat. \_\_\_\_\_

1st 24 hrs. after shot \_\_\_\_\_

Gas \_\_\_\_\_ Cu. Ft.

Dry Hole \_\_\_\_\_

Abandoned \_\_\_\_\_

Date

9/15 1919

Pyle Scout

Map No. K 14 Sec. 8 Twp. 23 R. 4Well No. 4 FairmanSinclair Company

Contractor

## SECTION PLAT

-----Ft. from N. Line

1120 Ft. from S. Line760 Ft. from E. Line

-----Ft. from W. Line

|  |   |  |  |
|--|---|--|--|
|  |   |  |  |
|  |   |  |  |
|  |   |  |  |
|  | 0 |  |  |

Location -----

Rig up -----

Drilling and Remarks:

1850'

## RECORD

Cased ----- in., ----- ft.

Sand -----

Gas -----

Oil -----

Total Depth -----

## PRODUCTION

1st 24 hrs. Nat. -----

1st 24 hrs. after shot -----

Gas ----- Cu. Ft.

Dry Hole -----

Abandoned -----

Date

Pyle

9/23 1919

Scout

Map No. K14 Sec. 8 Twp. 23 R. 4Well No. 4 FurnmanSinclair Company

Contractor

## SECTION PLAT

-----Ft. from N. Line

1120 Ft. from S. Line760 Ft. from E. Line

-----Ft. from W. Line

|  |   |  |  |
|--|---|--|--|
|  |   |  |  |
|  |   |  |  |
|  |   |  |  |
|  | 0 |  |  |

Location -----

Rig up -----

Drilling and Remarks:

## RECORD

Cased ----- in., ----- ft.

Sand -----

Gas -----

Oil -----

Total Depth -----

## PRODUCTION

1st 24 hrs. Nat. -----

1st 24 hrs. after shot -----

Gas ----- Cu. Ft.

Dry Hole -----

Abandoned -----

Date

9/30 1919

Scout

Pyle

Map No. K14 Sec. 8 Twp. 23 R. 4Well No. 4 FurmanSinclair Company

Contractor

## SECTION PLAT

Ft. from N. Line

1120 Ft. from S. Line760 Ft. from E. Line

Ft. from W. Line

|  |  |  |  |
|--|--|--|--|
|  |  |  |  |
|  |  |  |  |
|  |  |  |  |
|  |  |  |  |

Location

Rig up

Drilling and Remarks:

Top 2409  
I.D. 2419  
42 Bbls per  
hour natural

## RECORD

Cased \_\_\_\_\_ in., \_\_\_\_\_ ft.

Sand \_\_\_\_\_

Gas \_\_\_\_\_

Oil \_\_\_\_\_

Total Depth \_\_\_\_\_

## PRODUCTION

1st 24 hrs. Nat. \_\_\_\_\_

1st 24 hrs. after shot \_\_\_\_\_

Gas \_\_\_\_\_ Cu. Ft.

Dry Hole \_\_\_\_\_

Abandoned \_\_\_\_\_

Date

10/14 1919 Pyle Scout