

Section 8 Township 23 Range 4-E

Well No. #5 Furman

Company Aladdin Petroleum

NORTH

WEST

EAST

SOUTH

14

KANSAS

Butler

Sec. 8 Twp. 23 R. 4-E ☒

Well No. #5 Furman Farm

Aladdin Petroleum

Company

Contractor

Miscellaneous

Ft. from N. Line

330


Ft. from S. Line

990

Ft. from E. Line

Ft. from W. Line

SW SE SW

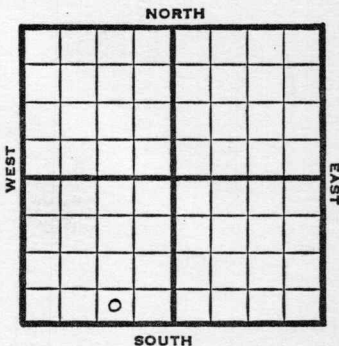

1950

Elev 1376

REPORT

9/20

Cellar & Pits

12/6

10" @ 81

Lans 1676

KC 1964

B KC 2115

Hunton 2376

Maq 2434

Viola 2451

TD 2508

7" @ 2508

3/2450-52 HFW PB 2425

18/2387-90

Comp 45 bopd 500 bw

Completed

COMPLETED

County Butler State KansasSec. 8 (Blk.
Twp.) 23 (Sur.
Rge.) 4E Map No.Operator Aladdin PetroleumWell No. 5 Farm FurmanElev. 1376 Location SW SE SW330 Ft. From S Line SW990 Ft. From E Line Quarter

1st. Report

Completion DEC 6 1950Remarks Elbing Pool

Spudding Date

Drlg. Data Oil well. TD 250810" @ 81 Lans. 1676 KC 1964B KC 2115 Hunton 2376 Maq. 2434Viola 2451 TD 2508 7" @ 25083/ 2450-52 HFW PB 2425 18/ 2387-90Comp. 45 bopd 500 bw

J. E. TYRA