

Map No. K 14 Sec. 8 Twp. 23 R. 4
 Well No. 7 Furman Farm
Sinclair Oil Company

NORTH

WEST

EAST



13

2008
765H

SOUTH

Location -----

Rig Up 8/18/17 -----

Drilling Remarks:

Drilling Remarks:

RECORD

PRODUCTION

Cased ----- in. ----- ft.

1st 24 hrs. Nat. -----

Sand -----

1st 24 hrs. after shot -----

Gas -----


Gas ----- cu. ft.

Oil -----

Dry Hole -----

Total Depth -----

Abandoned -----

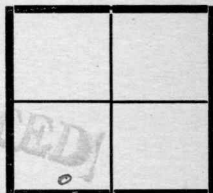Map No. _____ Sec. 8 Twp. 22 R. 4Well No. 7 Furman Farm _____ Sinclair Oil Co. Company __________
Contractor __________
Quarter Sw._____
Ft. from N. Line700 _____
Ft. from S. Line_____
Ft. from E. Line765 _____
Ft. from W. LinePage 9

REPORT

17/11 Dely 2100'

19/21 Dely 2215'

10/31 Dely 2380'

14/4 Sand 2380 - 2389 show oil

11/11 Sand 2380 - 2389 - 30 Bbl.

COMPLETED

Map No. K14 Sec. 8 Twp. 23 R. 4
Well No. 7 Furman
Disinclair O & S Company
Contractor


NORTH							
WEST							
							EAST
SOUTH							

<u>765 W</u>	<u>2005</u>
Location _____	RECORD
Rig up ☒ _____	Cased _____ in., _____ ft.
Drilling and Remarks:	Sand _____
	Gas _____
	Oil _____
	Total Depth _____
	PRODUCTION
	1st 24 hrs. Nat. _____
	1st 24 hrs. after shot _____
	Gas _____ Cu. Ft.
	Dry Hole _____
	Abandoned _____

Sec. 8 Twp. 23 Rge. 4
Owner Dinclair
Farm Furman Well No. 7
Contractor _____

Feet from lines, N. _____ E. _____ S. 200 W. 765

Casing used _____
15 1/2 _____ ft.
12 1/2 _____ ft.
10 _____ ft.
8 1/4 _____ ft.
6 5/8 _____ ft.
5 3/16 _____ ft.
Location _____
Rig ☒

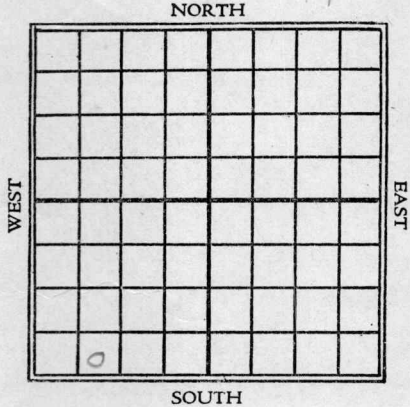

Drilling at _____ ft. Fishing at _____ ft.
Total Depth _____ Completed _____
1st 24 Hrs. Nat. _____ Producing _____
1st 24 Hrs. Shot _____ Dry Hole _____
Gas _____ Cu. ft. Abandoned _____
Sands — give name and depth. Top _____ Bottom _____

Date of Report 7-23
Reported by Pyle

Map No. K14 Sec. 8 Twp. 23 R. 4Well No. 7 FurmanDinclair Company

Contractor

SECTION PLAT

Ft. from N. Line

200 Ft. from S. Line

Ft. from E. Line

765 Ft. from W. Line

Location

Rig up ☒

Drilling and Remarks:

RECORD

Cased _____ in., _____ ft.

Sand _____

Gas _____

Oil _____

Total Depth _____

PRODUCTION

1st 24 hrs. Nat. _____

1st 24 hrs. after shot _____

Gas _____ Cu. Ft.

Dry Hole _____

Abandoned _____

Date

8/30 1919

Pyle

Scout

Map No. K14 Sec. 8 Twp. 23 R. 4Well No. 7 FurmanSimclair Oil Co. Company

Contractor

SECTION PLAT

0			

-----Ft. from N. Line

200-----Ft. from S. Line

-----Ft. from E. Line

765-----Ft. from W. Line

Location -----

Rig up -----

Drilling and Remarks:

Tools

RECORD

Cased ----- in., ----- ft.

Sand -----

Gas -----

Oil -----

Total Depth -----

PRODUCTION

1st 24 hrs. Nat. -----

1st 24 hrs. after shot -----

Gas ----- Cu. Ft.

Dry Hole -----

Abandoned -----

Date

9/2 1919 Pyle Scout

Map No. K14 Sec. 8 Twp. 23 R. 4Well No. 7 FurnaceSimclair Oil Co. Company

Contractor

SECTION PLAT

Ft. from N. Line

100 Ft. from S. Line

Ft. from E. Line

765 Ft. from W. Line

0			

Location

Rig up

Drilling and Remarks:

Rig in up

RECORD

Cased _____ in., _____ ft.

Sand _____

Gas _____

Oil _____

Total Depth _____

PRODUCTION

1st 24 hrs. Nat. _____

1st 24 hrs. after shot _____

Gas _____ Cu. Ft.

Dry Hole _____

Abandoned _____

Date

9/9 1919

Pyle

Scout

Map No. K14 Sec. 8 Twp. 23 R. 4Well No. 7 FurmanSinclair's Company

Contractor

SECTION PLAT

Ft. from N. Line

200 Ft. from S. Line

Ft. from E. Line

765 Ft. from W. Line

0			

Location

Rig up

Drilling and Remarks:

RECORD

Cased _____ in., _____ ft.

Sand _____

Gas _____

Oil _____

Total Depth _____

PRODUCTION

1st 24 hrs. Nat. _____

1st 24 hrs. after shot _____

Gas _____ Cu. Ft.

Dry Hole _____

Abandoned _____

Date

9/15 191 9

Scout

Pyle

Map No. 1514 Sec. 8 Twp. 23 R. 4Well No. 7 FurmanShelclair Company

Contractor

SECTION PLAT

Ft. from N. Line

200 Ft. from S. Line

Ft. from E. Line

765 Ft. from W. Line

RECORD

Location -----

Cased ----- in., ----- ft.

Rig up -----

Sand -----

Drilling and Remarks:

Gas -----

Oil -----

Total Depth -----

PRODUCTION

1st 24 hrs. Nat. -----

1st 24 hrs. after shot -----

Gas ----- Cu. Ft.

Dry Hole -----

Abandoned -----

Date

9/23 1919

Pyle

Scout

Map No. K14 Sec. 8 Twp. 33 R. 4

Well No. 7 Furman

Smclair Company
Contractor

SECTION PLAT

Ft. from N. Line

200 Ft. from S. Line

Ft. from E. Line

765 Ft. from W. Line

Location

Rig up

Drilling and Remarks:

10" @
1230'

RECORD

Cased in, ft.

Sand

Gas

Oil

Total Depth

PRODUCTION

1st 24 hrs. Nat.

1st 24 hrs. after shot

Gas Cu. Ft.

Dry Hole

Abandoned

Date

9/30 1919

Pyle

Scout

Map No. K14 Sec. 8 Twp. 23 R. 4Well No. 7 FurmanSinclair Company

Contractor

SECTION PLAT

Ft. from N. Line

200 Ft. from S. Line

Ft. from E. Line

765 Ft. from W. Line

Location

Rig up

Drilling and Remarks:

2100 Dry.

RECORD

Cased _____ in., _____ ft.

Sand _____

Gas _____

Oil _____

Total Depth _____

PRODUCTION

1st 24 hrs. Nat. _____

1st 24 hrs. after shot _____

Gas _____ Cu. Ft.

Dry Hole _____

Abandoned _____

Date

10/14 1919PyleScout

Map No. K 14 Sec. 8 Twp. 23 R. 4Well No. 7 Furman
Sinclair Company

Contractor

SECTION PLAT

-----Ft. from N. Line

200-----Ft. from S. Line

-----Ft. from E. Line

765-----Ft. from W. Line

0			

Location -----

Rig up -----

Drilling and Remarks:

2215'

RECORD

Cased ----- in., ----- ft.

Sand -----

Gas -----

Oil -----

Total Depth -----

PRODUCTION

1st 24 hrs. Nat. -----

1st 24 hrs. after shot -----

Gas ----- Cu. Ft.

Dry Hole -----

Abandoned -----

Date

10/21 1919

Pyle

Scout

Map No. 1514 Sec. 8 Twp. 23 R. 4Well No. 7 FurmanSinclair O & G Company

Contractor

SECTION PLAT

Ft. from N. Line

200 Ft. from S. Line

Ft. from E. Line

765 Ft. from W. Line

Location

Rig up

Drilling and Remarks:

RECORD

Cased _____ in., _____ ft.

Sand 2380 - 2389

Gas _____

Oil _____

Total Depth _____

PRODUCTION

1st 24 hrs. Nat. 30 bbls

1st 24 hrs. after shot _____

Gas _____ Cu. Ft.

Dry Hole _____

Abandoned _____

Date

11/11 1919

Pyle

Scout