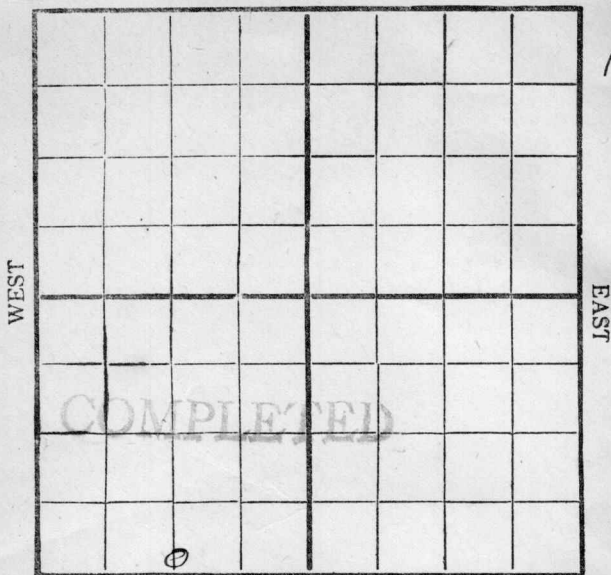


Map No. _____ Sec. Y Twp. 23 R. 4

Well No. 7 Furness Farm
Sinclair Oil Co. Company

NORTH



SOUTH

Location _____

Rig Up _____

Drilling Remarks:

Drilling Remarks:

RECORD

PRODUCTION

Cased _____ in. _____ ft.

1st 24 hrs. Nat. _____

Sand _____

1st 24 hrs. after shot _____

Gas _____

Gas _____ cu. ft.

Oil _____

Dry Hole _____

Total Depth _____

Abandoned _____

Map No. K14 Sec. 8 Twp. 23 R. 4Well No. 8 FurmanSinclair Oil Company

Contractor

SECTION PLAT

Ft. from N. Line

200 Ft. from S. Line

Ft. from E. Line

1320 Ft. from W. Line

Location

Rig up

Drilling and Remarks:

Tools

RECORD

Cased _____ in., _____ ft.

Sand _____

Gas _____

Oil _____

Total Depth _____

PRODUCTION

1st 24 hrs. Nat. _____

1st 24 hrs. after shot _____

Gas _____ Cu. Ft.

Dry Hole _____

Abandoned _____

Date

9/2 1919 Pyle Scout

Map No. 114 Sec. 8 Twp. 23 R. 4Well No. 8 FurmanSinclair Oil Company

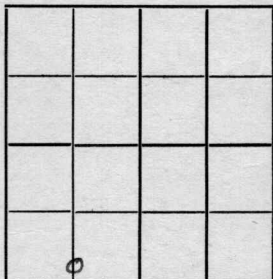
Contractor

SECTION PLAT

Ft. from N. Line

200 Ft. from S. Line

Ft. from E. Line

1320 Ft. from W. Line

Location

Rig up

Drilling and Remarks:

Rig up

RECORD

Cased _____ in., _____ ft.

Sand _____

Gas _____

Oil _____

Total Depth _____

PRODUCTION

1st 24 hrs. Nat. _____

1st 24 hrs. after shot _____

Gas _____ Cu. Ft.

Dry Hole _____

Abandoned _____

Date

9/9 1919

Pyle

Scout

Map No. K14 Sec. 8 Twp. 23 R. 4Well No. 8 FurmanSinclair Company

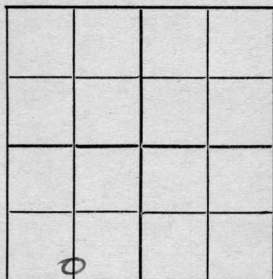
Contractor

SECTION PLAT

Ft. from N. Line

200 Ft. from S. Line

Ft. from E. Line

1320 Ft. from W. Line

Location

Rig up

Drilling and Remarks:

RECORD

Cased _____ in., _____ ft.

Sand _____

Gas _____

Oil _____

Total Depth _____

PRODUCTION

1st 24 hrs. Nat. _____

1st 24 hrs. after shot _____

Gas _____ Cu. Ft.

Dry Hole _____

Abandoned _____

Date

9/15 1919 Pyle Scout

Map No. K14 Sec. 8 Twp. 23 R. 4Well No. 8 FurmanSinclair Company

Contractor

SECTION PLAT

Ft. from N. Line

200 Ft. from S. Line

Ft. from E. Line

1320 Ft. from W. Line

RECORD

Location -----

Cased ----- in., ----- ft.

Rig up -----

Sand -----

Drilling and Remarks:

Gas -----

Oil -----

Total Depth -----

PRODUCTION

1st 24 hrs. Nat. -----

1st 24 hrs. after shot -----

Gas ----- Cu. Ft.

Dry Hole -----

Abandoned -----

Date

9/23 1919

Pyle

Scout

Map No. K14 Sec. 8 Twp. 23 R. 4Well No. 8Smclair Company

Contractor

SECTION PLAT

Ft. from N. Line

200 Ft. from S. Line

Ft. from E. Line

1320 Ft. from W. Line

Location

Rig up

Drilling and Remarks:

RECORD

Cased _____ in., _____ ft.

Sand _____

Gas _____

Oil _____

Total Depth _____

PRODUCTION

1st 24 hrs. Nat. _____

1st 24 hrs. after shot _____

Gas _____ Cu. Ft.

Dry Hole _____

Abandoned _____

Date

9/ 1919

Pyle

Scout

Map No. K14 Sec. 8 Twp. 23 R. 4

Well No. 8 Furman
Sinclair Company

Contractor

SECTION PLAT

-----Ft. from N. Line

200 Ft. from S. Line

-----Ft. from E. Line

1320 Ft. from W. Line

Location -----

Rig up -----

Drilling and Remarks:

2175 Dry.

RECORD

Cased ----- in., ----- ft.

Sand -----

Gas -----

Oil -----

Total Depth -----

PRODUCTION

1st 24 hrs. Nat. -----

1st 24 hrs. after shot -----

Gas ----- Cu. Ft.

Dry Hole -----

Abandoned -----

Date 10/14 1919 Scout

Pyle

Map No. 1514 Sec. 8 Twp. 23 R. 4Well No. 8 FurmanSinclair Company

Contractor

SECTION PLAT

Ft. from N. Line

200 Ft. from S. Line

Ft. from E. Line

1320 Ft. from W. Line

RECORD

Location

Rig up

Drilling and Remarks:

Cased in., ft.

Sand

Gas

Oil

Total Depth

PRODUCTION

1st 24 hrs. Nat.

1st 24 hrs. after shot

Gas Cu. Ft.

Dry Hole

Abandoned

Date

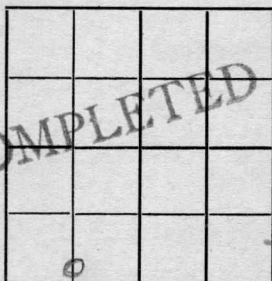
10/21 1919

Pyle

Scout

Map No. _____ Sec. 8 Twp. 23 R. 4Well No. 8 FurmanSinclair O & L Company_____
Contractor

SECTION PLAT

Ft. from N. Line200 Ft. from S. Line_____
Ft. from E. Line1320 Ft. from W. Line

Location _____

Rig up _____

Drilling and Remarks:

RECORD

Cased _____ in., _____ ft.

Sand 2380-2396

Gas _____

Oil _____

Total Depth _____

PRÓDUCTION

1st 24 hrs. Nat. 500 bbls

1st 24 hrs. after shot _____

Gas _____ Cu. Ft.

Dry Hole _____

Abandoned _____

Date

10/31 1919

Pyle

Scout