


Map No. _____ Sec. 3 Twp. 26 R. 4
 Well No. 15 Paulson Farm _____
Empire Company _____

NORTH

WEST

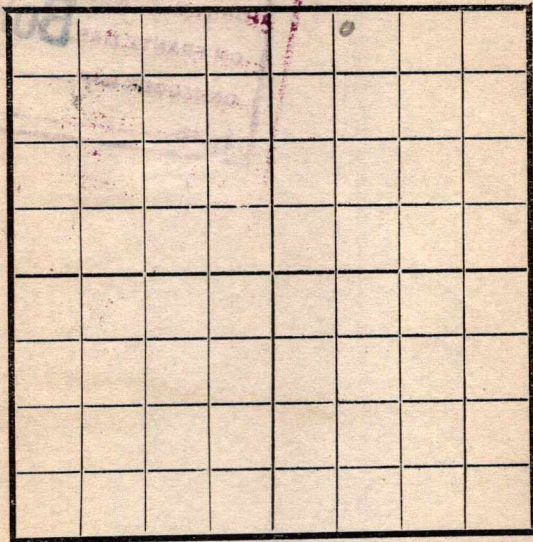

EAST

SOUTH

Location _____
 Rig Up ☒ _____
 Drilling and remarks _____

RECORD

Cased _____ in. _____ Ft.
 Sand _____
 Gas _____
 Oil _____
 Total Depth _____

PRODUCTION

1st 24 hrs. Nat. _____
 1st 24 hrs. after shot _____
 Gas _____ Cu. Ft.
 Dry Hole _____
 Abandoned _____

FIRST REPORT

Date

8/17, 1917 J. C. Cawley Scout _____

Map No. K-14 Sec. 7 Twp. N6 R. 4
 Well No. 15- Paulson Farm
Empire Company

NORTH

WEST

EAST

SOUTH

Location _____

Rig Up ☒ _____

Drilling and remarks _____

RECORD

Cased _____ in. _____ Ft.

Sand _____

Gas _____

Oil _____

Total Depth _____

PRODUCTION

1st 24 hrs. Nat. _____

1st 24 hrs. after shot _____

Gas _____ Cu. Ft.

Dry Hole _____

Abandoned _____

Date


8-23, 1917Lang Scout

Map No. _____ Sec. 2 Twp. 26 R. 4

Well No. 15 Paulson Farm

Empire Company

NORTH

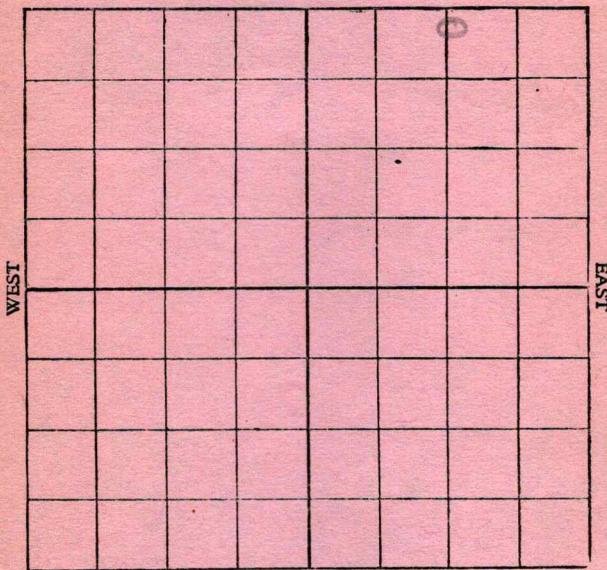

SOUTH


Location _____ Rig up _____ Drilling and remarks: <u>1550</u>	RECORD Cased _____ in. _____ Ft. Sand _____ Gas _____ Oil _____ Total Depth _____
	PRODUCTION 1st 24 hrs. Nat. _____ 1st 24 hrs. after shot _____ Gas _____ Cu. Ft. Dry Hole _____ Abandoned _____

Date 10/9, 1917, Candiff Scout

Map No. _____ Sec. 2 Twp. 26 R. 4
 Well No. 15 Paulson Farm _____
Engine Company _____

NORTH

WEST

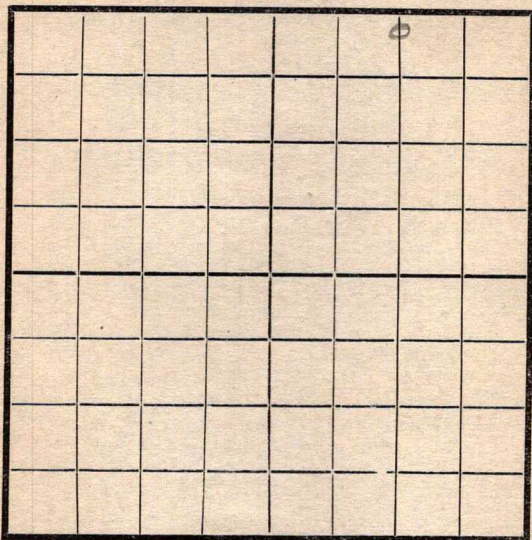

EAST

SOUTH

Location _____
 Rig Up _____
 Drilling and remarks

1675

RECORD

Cased _____ in. _____ Ft.
 Sand _____
 Gas _____
 Oil _____
 Total Depth _____

PRODUCTION

1st 24 hrs. Nat. _____
 1st 24 hrs. after shot _____
 Gas _____ Cu. Ft.
 Dry Hole _____
 Abandoned _____

Date

10/17, 1917 Carroll Scout

Map No. _____ Sec. 2 Twp. 26 R. 4


Well No. 15 Paulson Farm _____

Empire Company _____

NORTH

WEST

EAST

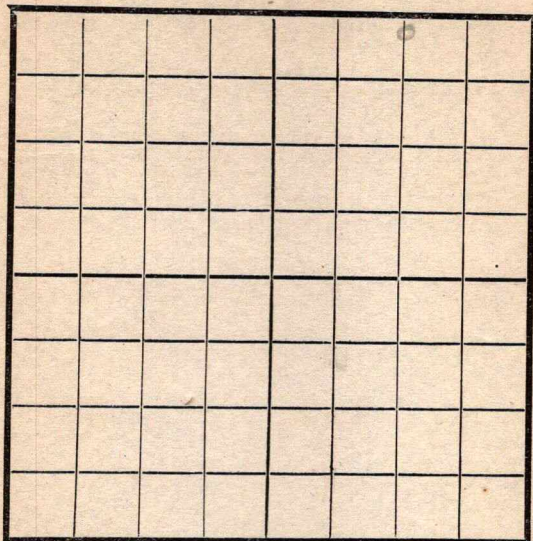

SOUTH

Location _____

Rig Up _____

Drilling and remarks

RECORD

Cased _____ in. _____ Ft.

Sand _____

Gas _____

Oil _____

Total Depth _____

PRODUCTION

1st 24 hrs. Nat. _____

1st 24 hrs. after shot _____

Gas _____ Cu. Ft.

Dry Hole _____

Abandoned _____

Date

10/24, 1917 Cardiff Scout

Map No. _____ Sec. 2 Twp. 26 R. 4Well No. 15 Paulson Farm_____
Engine Company

NORTH

WEST

EAST

SOUTH

Location _____

Rig Up _____

Drilling and remarks

22
1750

RECORD

Cased _____ in. _____ Ft.

Sand _____

Gas _____

Oil _____

Total Depth _____

PRODUCTION

1st 24 hrs. Nat. _____

1st 24 hrs. after shot _____

Gas _____ Cu. Ft.

Dry Hole _____

Abandoned _____

Date


11-7, 1917 Carley Scout

Map No. _____ Sec. 2 Twp. 26 R. 4

Well No. 15 Paulson Farm
Empire Company

NORTH

WEST

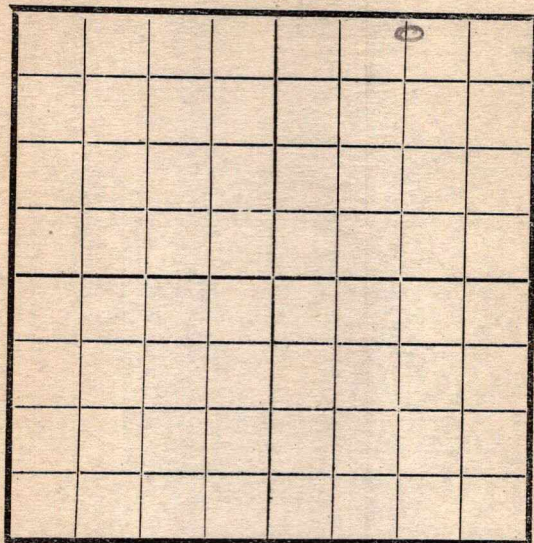

EAST

SOUTH

Location _____
 Rig Up _____
 Drilling and remarks _____

RECORD

Cased _____ in. _____ Ft.
 Sand _____
 Gas _____
 Oil _____
 Total Depth _____

PRODUCTION

1st 24 hrs. Nat. _____
 1st 24 hrs. after shot _____
 Gas _____ Cu. Ft.
 Dry Hole _____
 Abandoned _____

Date

11/14, 1917 Candys Scout

Map No. _____ Sec. 2 Twp. 26 R. 4
 Well No. 15 Pauls Farm
Engine Company

NORTH

WEST

EAST

SOUTH

Location _____
 Rig Up _____
 Drilling and remarks

2075

RECORD

Cased _____ in. _____ Ft.
 Sand _____
 Gas _____
 Oil _____
 Total Depth _____

PRODUCTION

1st 24 hrs. Nat. _____
 1st 24 hrs. after shot _____
 Gas _____ Cu. Ft.
 Dry Hole _____
 Abandoned _____

Date


11/21, 1917 Pauls Scout

Map No. K14 Sec. 2 Twp. 26 R. 4
 Well No. 15 Paulson Farm
Empire Company

NORTH

WEST

EAST

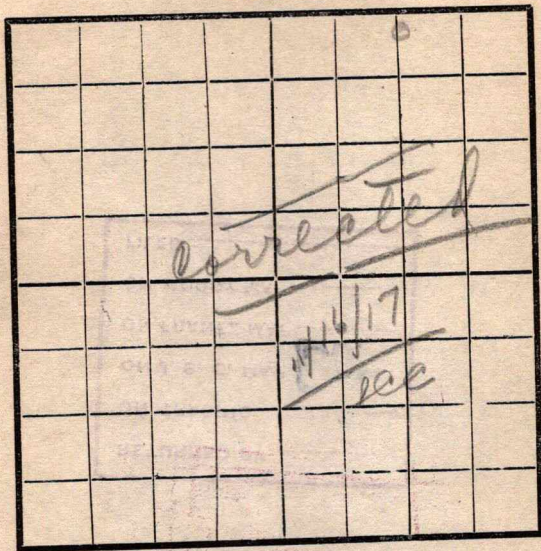

SOUTH

Location -----

Rig Up -----

Drilling and remarks

DD
1758

RECORD

Cased ----- in. ----- Ft.

Sand -----

Gas -----

Oil -----

Total Depth -----

PRODUCTION

1st 24 hrs. Nat. -----

1st 24 hrs. after shot -----

Gas ----- Cu. Ft.

Dry Hole -----

Abandoned -----

Date

10/31, 1917 Cardiff Scout

Map No. _____ Sec. 2 Twp 26 R. 8


Well No. _____ Farm _____

_____ Company _____

NORTH

WEST

EAST

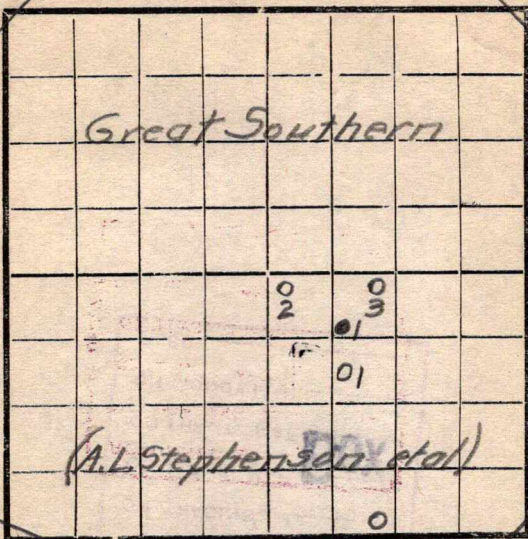

SOUTH

RECORD

Location _____

Cased _____ in. _____ Ft.

Rig Up _____

Sand _____

Drilling and remarks _____

Gas _____

Oil _____

Total Depth _____

PRODUCTION

1st 24 hrs. Nat. _____

1st 24 hrs. after shot _____

Gas _____ Cu. Ft.

Dry Hole _____

Abandoned _____

Date _____


_____, 191____. _____ Scout _____

Map No. _____ Sec. 2 Twp. 26 R. 4
 Well No. 15 Paulson Farm _____
Engine Company _____

NORTH

WEST

EAST

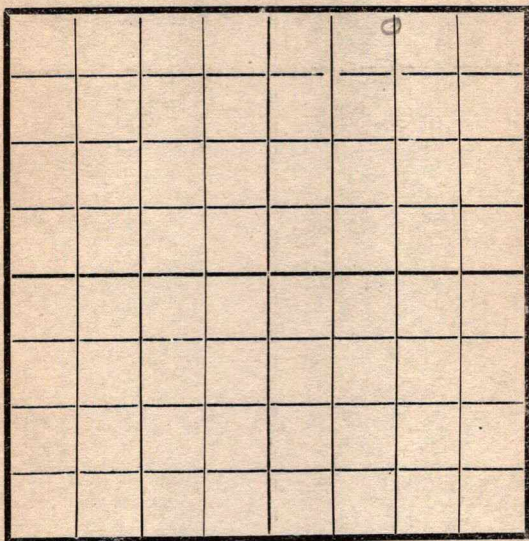

SOUTH

Location _____
 Rig Up _____
 Drilling and remarks _____

2165

RECORD

Cased _____ in. _____ Ft.
 Sand _____
 Gas _____
 Oil _____
 Total Depth _____

PRODUCTION

1st 24 hrs. Nat. _____
 1st 24 hrs. after shot _____
 Gas _____ Cu. Ft.
 Dry Hole _____
 Abandoned _____

Date

11/28, 1917 Paulson Scout

Map No. _____ Sec. 2 Twp. 26 R. 4
 Well No. 15 Paulson Farm _____
Engine Company _____

NORTH

WEST

EAST

SOUTH

Location _____

Rig Up _____

Drilling and remarks

2350

RECORD

Cased _____ in. _____ Ft.

Sand _____

Gas _____

Oil _____

Total Depth _____

PRODUCTION

1st 24 hrs. Nat. _____

1st 24 hrs. after shot _____

Gas _____ Cu. Ft.

Dry Hole _____

Abandoned _____


Date

12/5, 1917 Paulson Scout _____

Map No. _____ Sec. 2 Twp. 26 R. 4
 Well No. 15 Paulsboro Farm _____
Engine Company _____

NORTH

WEST

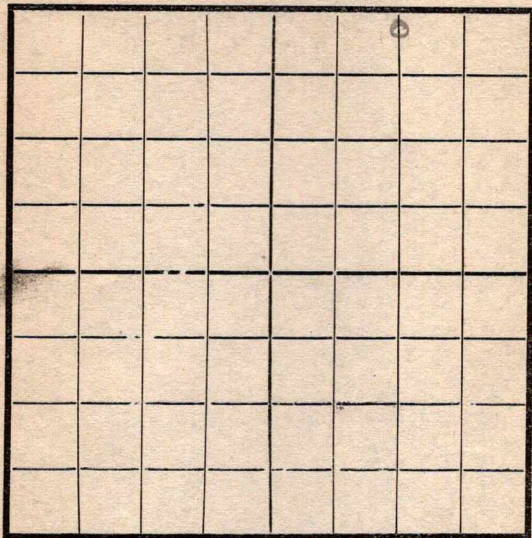

EAST

SOUTH

RECORD

Location _____
 Rig Up _____
 Drilling and remarks _____

Cased _____ in. _____ Ft.
 Sand _____
 Gas _____
 Oil _____
 Total Depth _____

PRODUCTION

1st 24 hrs. Nat. _____
 1st 24 hrs. after shot _____
 Gas _____ Cu. Ft.
 Dry Hole _____
 Abandoned _____

Top sand
2315
Drilling 2335

Date 1/2, 1918 S. Carney Scout _____

Map No. _____ Sec. 2 Twp. 26 R. 4Well No. 15 Pauline FarmEngine Company

NORTH

WEST

EAST

SOUTH

Location _____

Rig Up _____

Drilling and remarks

RECORD

Cased _____ in. _____ Ft.

Sand _____

Gas _____

Oil _____

Total Depth _____

PRODUCTION

1st 24 hrs. Nat. _____

1st 24 hrs. after shot _____

Gas _____ Cu. Ft.


Dry Hole _____

Abandoned _____

Date

1/16, 1918 S. Conley Scout

Map No. _____ Sec. 2 Twp. 26 R. 4
 Well No. 15 Paulson Farm _____
Empire Company
 NORTH

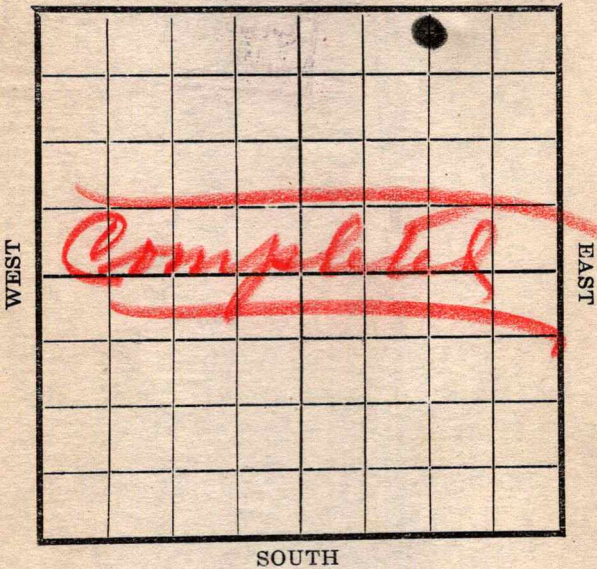

Location _____ Rig Up _____ Drilling and remarks <u>Estimated</u> <u>at 300</u> <u>feet</u>	RECORD Cased _____ in. _____ Ft. Sand <u>2353-2405</u> Gas _____ Oil _____ Total Depth _____ PRODUCTION 1st 24 hrs. Nat. _____ 1st 24 hrs. after shot _____ Gas _____ Cu. Ft. Dry Hole _____ Abandoned _____
Date <u>1/28</u> , 191 <u>8</u> <u>C. Condy</u> Scout	