

		O					

S COMPLETED

COMPLETED

[illegible]

Total Depth-----

[illegible]

Abandoned -----

Map No. _____ Sec. 26 Twp. 23 R. 13


Well No. 1 Address Hunkler Chas. Farm _____ Company _____

200 Ft. from N. Line

Ft. from S. Line

1120 Ft. from E. Line

_____Ft. from W. Line

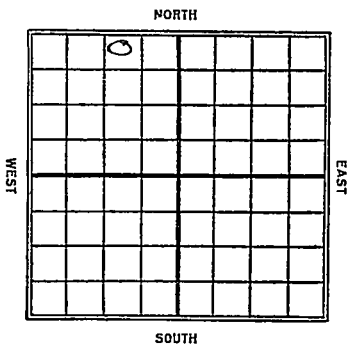

Date 12/12/12

REPORT

1/15	Alg 800'
2/4	1300'
3/30	S.D. 1700'
4/9	Ld 1796-1840 Shot 140 gts Pumping 30 bbls

Map No. K17 Sec. 26 Twp. 23' R. 13
 Well No. 1 Anderson
Hinkler et al Company.
1120 from E. NORTH 200 from N.

		0					

WEST EAST

SOUTH

First Report

Location_____

Rig up_____

Drilling and Remarks:

20 yds 800'

RECORD

Cased_____ in., _____ ft.

Sand_____

Gas_____

Oil_____

Total Depth_____

PRODUCTION

1st 24 hrs. Nat. _____

1st 24 hrs. after shot _____

Gas_____ Cu. Ft.

Dry Hole_____

Abandoned_____

State KansasDate 1/151922Scout W. J. B.

Map No. 17 Sec. 26 Twp. 23 R. 13Well No. 1 Andrews
Husker et al. Company

Contractor

COMPLETED

SECTION PLAT

200 Ft. from N. Line

Ft. from S. Line

1120 Ft. from E. Line

Ft. from W. Line

	0		

Location

Rig up

Drilling and Remarks:

Rand. 1796. - 1840
shot. 140. gk
pumping
30 lbs.

RECORD

Cased _____ in., _____ ft.

Sand _____

Gas _____

Oil _____

Total Depth _____

PRODUCTION

1st 24 hrs. Nat. _____

1st 24 hrs. after shot _____

Gas _____ Cu. Ft.

Dry Hole _____

Abandoned _____

Date

APR 19 1922

M. A. BENEAR

Scout