


Map No. 1 Kan Sec. 26 Twp. 23 R. 12

Well No. 1 Lang Farm
Fisher Larch + Reed Company

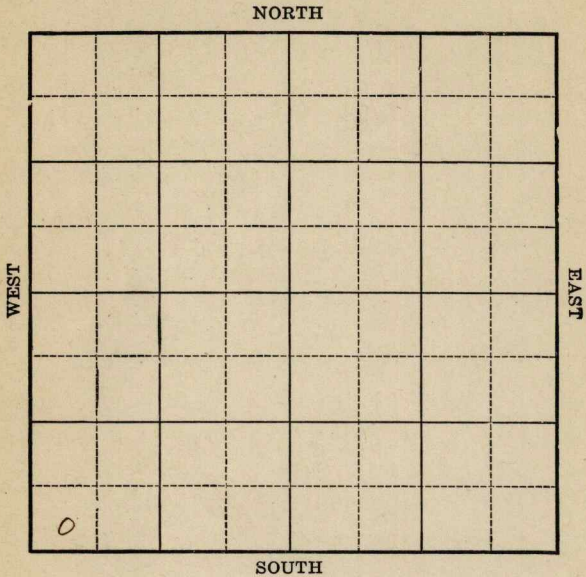

Location _____
Drilling Remarks _____

RECORD

Cased _____ in. _____ ft.
Sand _____
Gas _____
Oil _____
Total Depth _____

Rig Up _____
Drilling Remarks _____

PRODUCTION

1st 24 hrs. Nat. _____
1st. 24 hrs. after shot _____
Gas _____ cu. ft.
Dry Hole _____
Abandoned _____

Map No. Kansas Sec. 26 Twp. 23 R. 12Well No. 1 Long Farm
Fisher Lanch & Red Company


Ft. from N. Line

250 Ft. from S. Line

Ft. from E. Line

250 Ft. from W. Line

NORTH

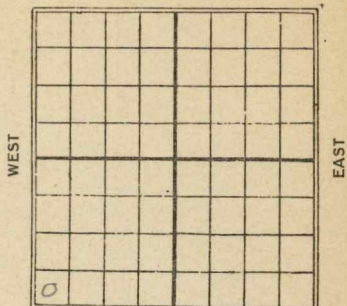

SOUTH

C.

Date	REPORT
1925	
3/24	Location
5/29	_____
6/5	Machine
6/12	Dry 450
6/19	_____
6/26	S.D. 450
7/3	450
7/10	700
7/17	1108
7/24	fish tools 1100'
7/31	1235'
8/7	Top Brill 1655-66' Dry
	Top Burgess 1798-1810' Water
	Top M. I. 1810' Z.D. 1816'
	U.R. 6" from 1735-1810'
8/14	_____
8/20	Abandoned 1855

Map No. 16 **KANSAS** Sec. 26 Twp. 23 R. 12

Well No. 1 Lang
Fisher Lang & Reed Company

Contractor

FIRST REPORT

SECTION PLAT

_____Ft. from N. Line

250 _____Ft. from S. Line

_____Ft. from E. Line

250 _____Ft. from W. Line

0			

Location ✓✓

Rig up _____

Drilling and Remarks:

RECORD

Cased _____ in., _____ ft.

Sand _____

Gas _____

Oil _____

Total Depth _____

PRODUCTION

1st 24 hrs. Nat. _____

1st 24 hrs. after shot _____

Gas _____ Cu. Ft.

Dry Hole _____

Abandoned _____

Date

3/24 1925

M. A. BENEAR

Scout

Sherwood Co

Map No. 16 KANSAS Sec. 26 Twp. 23 R. 12Well No. 1 Hong

Fisher-Harris & Reed Company

Contractor

COMPLETED

SECTION PLAT

Ft. from N. Line

Ft. from S. Line

Ft. from E. Line

Ft. from W. Line

ABANDONED

Location

Rig up

Drilling and Remarks:

Bollers 1655-66' Dry

Bulgers 1798-1810' Dry

Top line 1810'

Dry & hot

2.0. 1855' 1st Bif

Show oil 1810-45'

Date

AUG 20 1925

192

RECORD

Cased _____ in., _____ ft.

Sand _____

Gas _____

Oil _____

Total Depth 1855'

PRODUCTION

1st 24 hrs. Nat. _____

1st 24 hrs. after shot _____

Gas _____ Cu. Ft.

Dry Hole _____

Abandoned _____

CHAS. L. SHERWOOD

Scout