


Map No. _____ Sec. 8 Twp. 23 R. 4Well No. 1 Holden Farm
Sinclair Oil Co. Company

NORTH

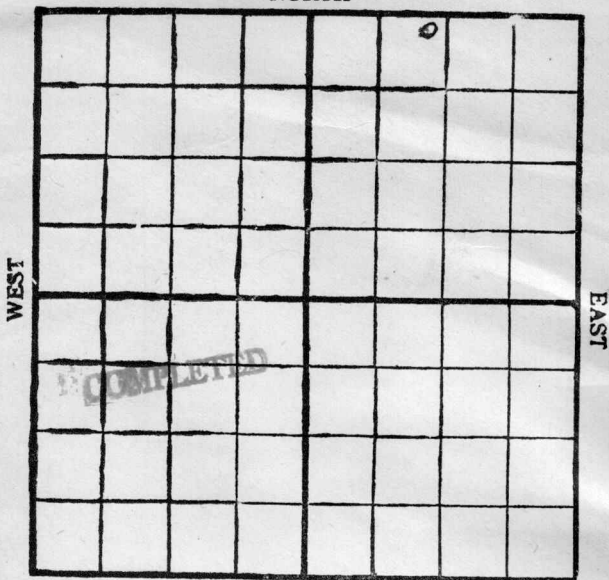

SOUTH

Location _____

Drilling Remarks:

9-5 sand 2474-76'
250 bbls

Rig Up _____

Drilling Remarks:

RECORD

Cased _____ in. _____ ft.

Sand _____

Gas _____

Oil _____

Total Depth _____

PRODUCTION

1st 24 hrs. Nat. _____

1st 24 hrs. after shot _____

Gas _____ cu. ft.

Dry Hole _____

Abandoned _____

Map No. K 14 Sec. 8 Twp. 23 R. 4Well No. 1 Halden
Sinclair O & G. Company

Contractor

NORTH

WEST

EAST

FIRST REPORT

SOUTH

200 N

1120 W

Location _____

Rig up _____

Drilling and Remarks:

Timber

RECORD

Cased _____ in., _____ ft.

Sand _____

Gas _____

Oil _____

Total Depth _____

PRODUCTION

1st 24 hrs. Nat. _____

1st 24 hrs. after shot _____

Gas _____ Cu. Ft.

Dry Hole _____

Abandoned _____

Date

191

9

Pyb

Scout


Map No. K14 Sec. 8 Twp. 23 R. 4Well No. 1 HoldenSinclair O & G Company

Contractor

NORTH

WEST

EAST

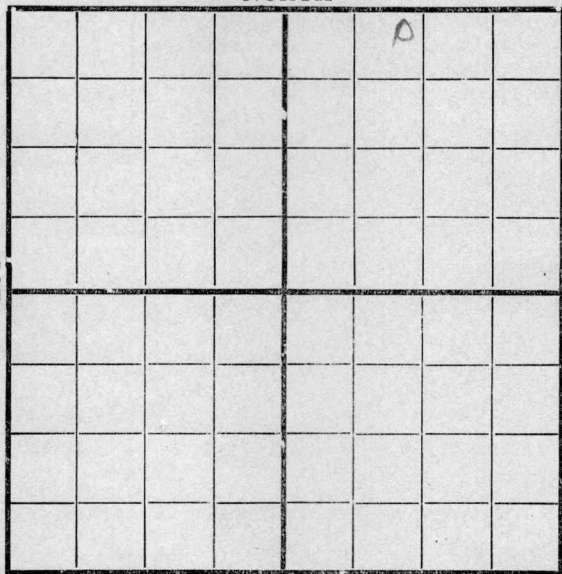

200 N

SOUTH

1120 W

Location _____

Rig up _____

Drilling and Remarks:

Timbers

RECORD

Cased _____ in., _____ ft.

Sand _____

Gas _____

Oil _____

Total Depth _____

PRODUCTION

1st 24 hrs. Nat. _____

1st 24 hrs. after shot _____

Gas _____ Cu. Ft.

Dry Hole _____

Abandoned _____

Date

5/17

1919

Gyle

Scout

Map No. K14 Sec. 8 Twp. 23 R. 4Well No. HolderSinclair Oil Co. Company

Contractor

NORTH

WEST

EAST

SOUTH

200 N

1120 W

Location _____

Rig up _____

Drilling and Remarks:

RECORD

Cased _____ in., _____ ft.

Sand _____

Gas _____

Oil _____

Total Depth _____

PRODUCTION

1st 24 hrs. Nat. _____

1st 24 hrs. after shot _____

Gas _____ Cu. Ft.

Dry Hole _____

Abandoned _____

Date

5/25 1919Pyle

Scout


Map No. K 14 Sec. 8 Twp. 23 R. 4Well No. 1 HoldenSinclair Oil Company

Contractor

NORTH

WEST

EAST

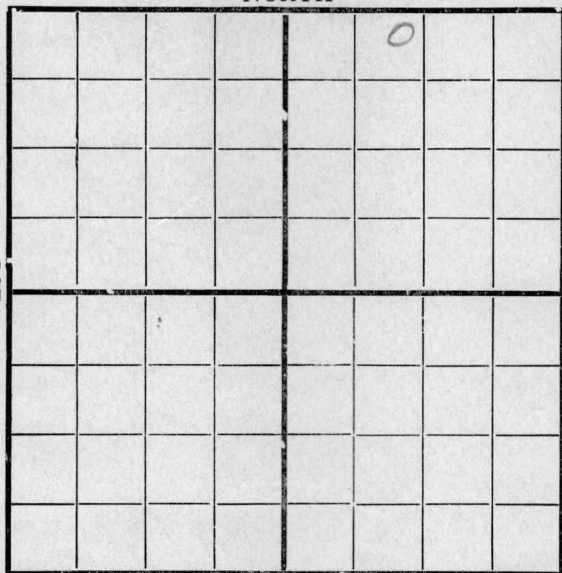

SOUTH

Location _____

Rig up ☒

Drilling and Remarks:

RECORD

Cased _____ in., _____ ft.

Sand _____

Gas _____

Oil _____

Total Depth _____

PRODUCTION

1st 24 hrs. Nat. _____

1st 24 hrs. after shot _____

Gas _____ Cu. Ft.

Dry Hole _____

Abandoned _____


Date

5/311919

Pyle

Scout

Map No. K 14 Sec. 18 Twp. 23 R. 4
Well No. 1 Holden
Sinclair 0 42 Company _____
Contractor _____

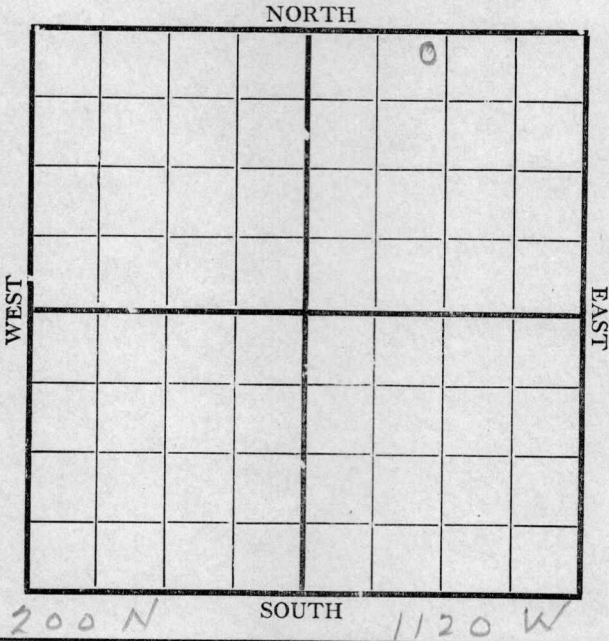

Location _____
Rig up ☒ _____
Drilling and Remarks: _____

RECORD

Cased _____ in., _____ ft.
Sand _____
Gas _____
Oil _____
Total Depth _____

PRODUCTION

1st 24 hrs. Nat. _____
1st 24 hrs. after shot _____
Gas _____ Cu. Ft.
Dry Hole _____
Abandoned _____

Date 6/7 1919 Pyle Scout


Map No. K 14 Sec. 8 Twp. 23 R. 4Well No. 1 HoldingShelclair 0 12 Company

Contractor

NORTH

WEST

EAST

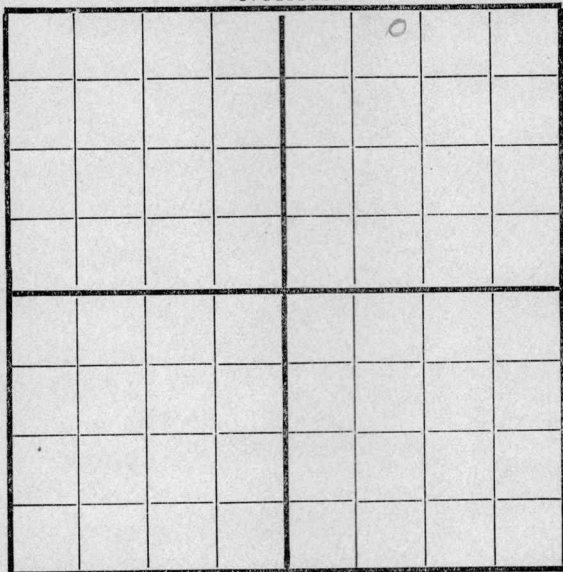

SOUTH

200 N

1120 W

Location _____

Rig up ☒ _____

Drilling and Remarks:

RECORD

Cased _____ in., _____ ft.

Sand _____

Gas _____

Oil _____

Total Depth _____

PRODUCTION

1st 24 hrs. Nat. _____

1st 24 hrs. after shot _____

Gas _____ Cu. Ft.

Dry Hole _____

Abandoned _____

Date

Pyle

191 9


Scout

6/14

Map No. K14 Sec. 8 Twp. 23 R. 4Well No. 1 Holden
Simclair O & S Company

Contractor

NORTH

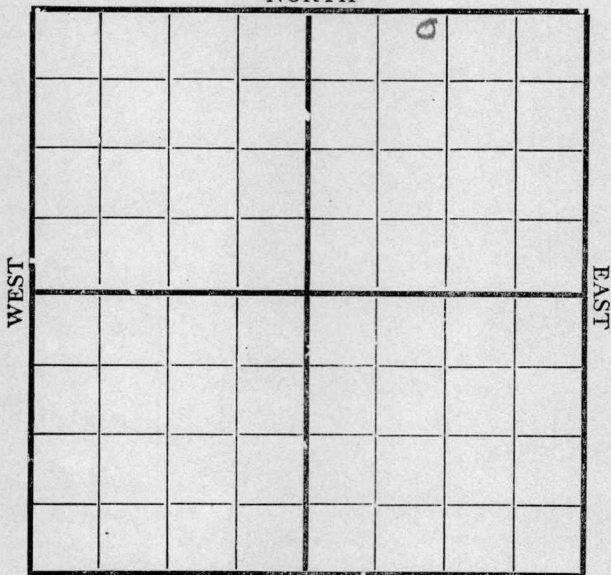

200 N

SOUTH

1120 W

Location _____

Rig up. ☒

Drilling and Remarks:

RECORD

Cased _____ in., _____ ft.

Sand _____

Gas _____

Oil _____

Total Depth _____

PRODUCTION

1st 24 hrs. Nat. _____

1st 24 hrs. after shot _____

Gas _____ Cu. Ft.

Dry Hole _____

Abandoned _____

Date

6/18

1919

Pyle

Scout


Map No. K14 Sec. 8 Twp. 23 R. 4Well No. 1 GoldenSinclair Oil Co. Company

Contractor

NORTH

WEST

EAST

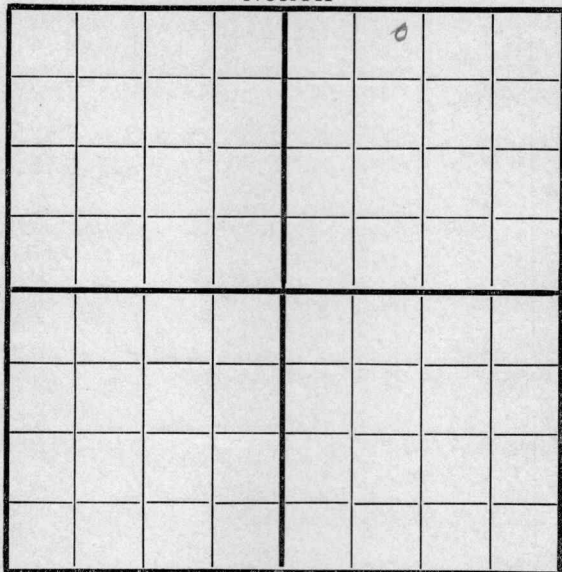

SOUTH

200 N

1120 W

Location _____

Rig up ☒

Drilling and Remarks:

RECORD

Cased _____ in., _____ ft.

Sand _____

Gas _____

Oil _____

Total Depth _____

PRODUCTION

1st 24 hrs. Nat. _____

1st 24 hrs. after shot _____

Gas _____ Cu. Ft.

Dry Hole _____

Abandoned _____

Date

6/28

1919

Pyle

Scout


Map No. K14 Sec. 8 Twp. 23 R. 4Well No. 1 HolderClair Company

Contractor

NORTH

WEST

EAST

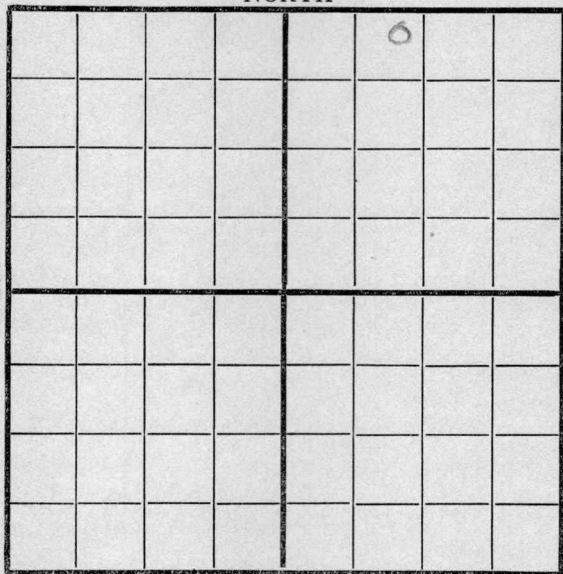

SOUTH

200 N

1120 W

Location _____

Rig up ☒

Drilling and Remarks:

RECORD

Cased _____ in., _____ ft.

Sand _____

Gas _____

Oil _____

Total Depth _____

PRODUCTION

1st 24 hrs. Nat. _____

1st 24 hrs. after shot _____

Gas _____ Cu. Ft.

Dry Hole _____

Abandoned _____

Date

7/1

191

9

Pyle

Scout


Map No. K 14 Sec. 8 Twp. 23 R. 4Well No. 1 HoldenSniclair O & S Company

Contractor

NORTH

WEST

EAST

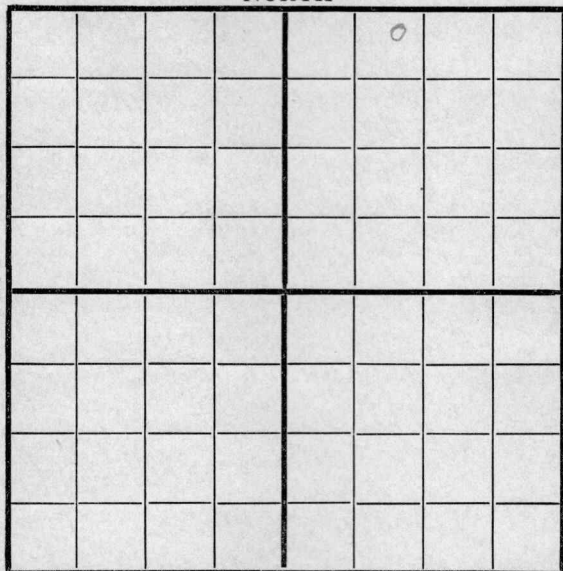

SOUTH

200 N

1120 W

Location

Rig up

Drilling and Remarks:

Spud

RECORD

Cased _____ in., _____ ft.

Sand _____

Gas _____

Oil _____

Total Depth _____

PRODUCTION

1st 24 hrs. Nat. _____

1st 24 hrs. after shot _____

Gas _____ Cu. Ft.


Dry Hole _____

Abandoned _____

Date

7/12 1919 Pyle Scout

Map No. K14 Sec. 8 Twp. 23 R. 4
Well No. 1 Holden
Sinclair 042 Company
Contractor

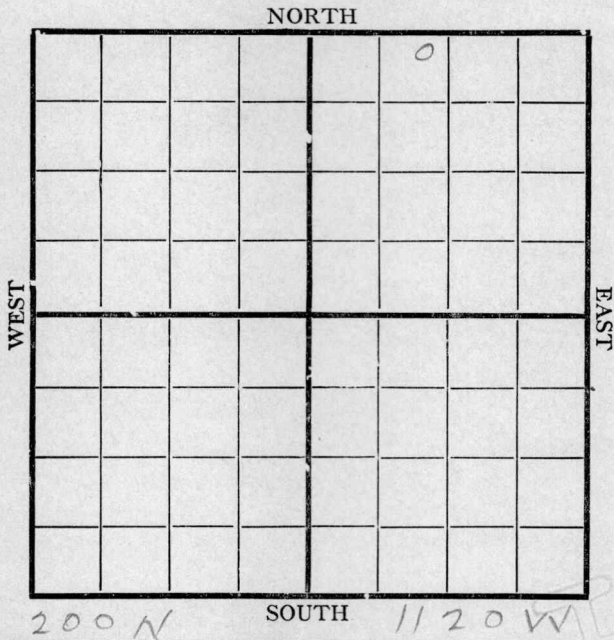

Location _____
Rig up _____
Drilling and Remarks:

350'

RECORD

Cased _____ in., _____ ft.
Sand _____
Gas _____
Oil _____
Total Depth _____

PRODUCTION


1st 24 hrs. Nat. _____
1st 24 hrs. after shot _____
Gas _____ Cu. Ft.
Dry Hole _____
Abandoned _____

Date 7/16 1919 Pyle Scout

Map No. K 14 Sec. 8 Twp. 23 R. 4Well No. 1 Holden
Sinclair O. & G. Company

Contractor

NORTH

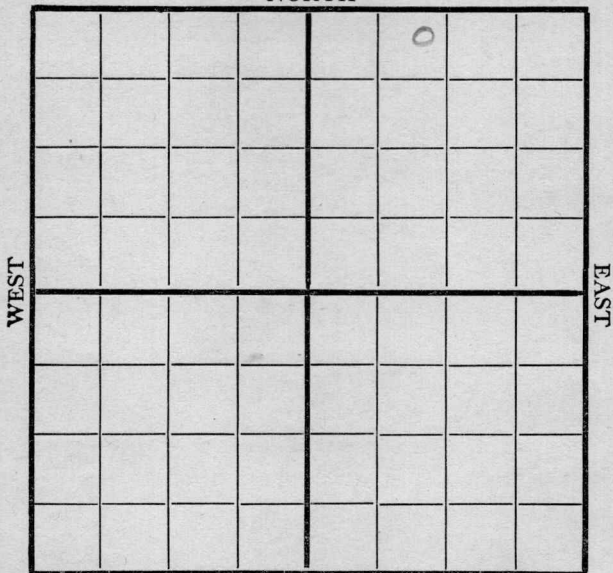200 N

SOUTH

1120 W

Location _____

Rig up _____

Drilling and Remarks:

9.65

RECORD

Cased _____ in., _____ ft.

Sand _____

Gas _____

Oil _____

Total Depth _____

PRODUCTION

1st 24 hrs. Nat. _____

1st 24 hrs. after shot _____

Gas _____ Cu. Ft.

Dry Hole _____

Abandoned _____


Date

7/25 1919 Pyle Scout

Map No. K14 Sec. 8 Twp. 23 R. 4Well No. 1 GoldenSinclair O & G Company

Contractor

NORTH

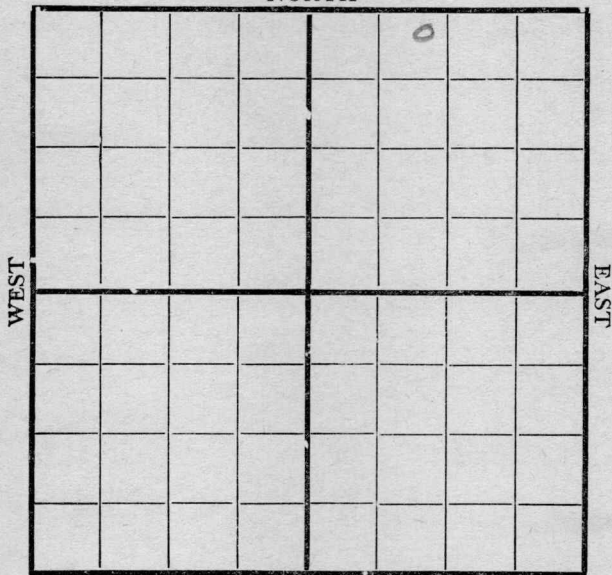

SOUTH

Location _____

Rig up _____

Drilling and Remarks:

1190'

RECORD

Cased _____ in., _____ ft.

Sand _____

Gas _____

Oil _____

Total Depth _____

PRODUCTION

1st 24 hrs. Nat. _____

1st 24 hrs. after shot _____

Gas _____ Cu. Ft.

Dry Hole _____

Abandoned _____

Date


7/29 1919 Pyle Scout

Map No. K14 Sec. 8 Twp. 23 R. 4Well No. 1 Golden FarmSinclair O & G Company

NORTH

WEST

EAST

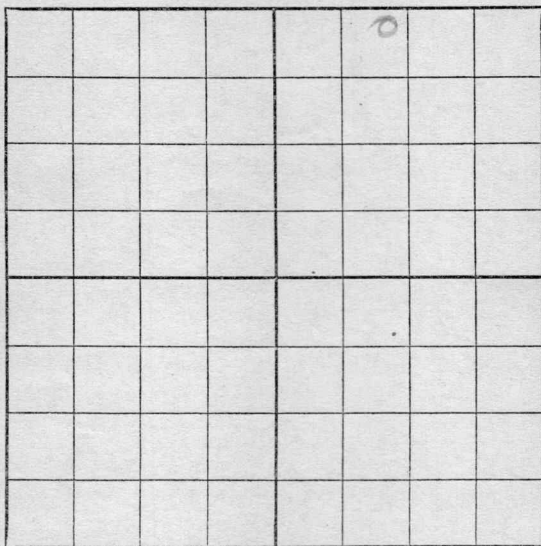

200 N SOUTH 1120 W

Location

Rig up

Drilling and Remarks:

RECORD

Cased in. Ft.

Sand

Gas

Oil

Total Depth

PRODUCTION

1st 24 hrs. Nat.

1st 24 hrs. after shot

Gas Cu. Ft.

Dry Hole

Abandoned

Date


8/4, 1919,Pyle Scout

Map No. K 14 Sec. 8 Twp. 23 R. 4Well No. 1 GoldenSinclair O & G Company

Contractor

NORTH

WEST

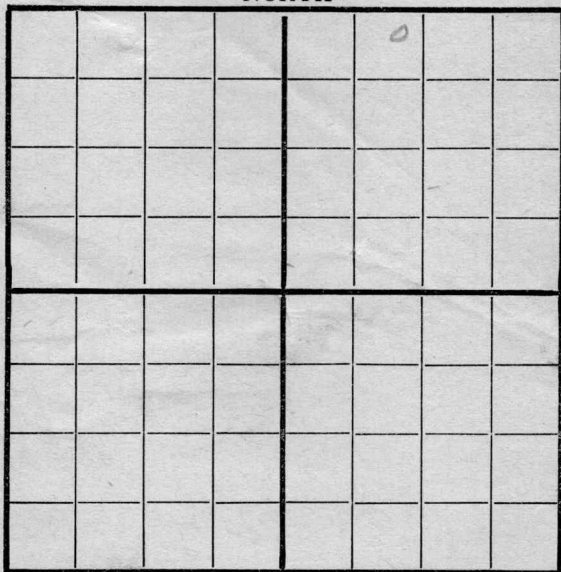

EAST

SOUTH

200 N

1120 W

RECORD

Location _____

Cased _____ in., _____ ft.

Rig up _____

Sand _____

Drilling and Remarks:

Gas _____

Oil _____

Total Depth _____

PRODUCTION

1st 24 hrs. Nat. _____

1st 24 hrs. after shot _____

Gas _____ Cu. Ft.

Dry Hole _____

Abandoned _____

Date

191 9

Scout

Pyle

Sec. 8 Twp. 23 Rge. 4
 Owner Quinclair O & G
 Farm Holden Well No. 1
 Contractor _____

Feet from lines, N. 200 E. _____ S. _____ W. 1120

Casing used _____

15½ _____ ft.

12½ _____ ft.

10 _____ ft.


8¼ _____ ft.

6⅝ _____ ft.

5 3-16 _____ ft.

Location _____

Rig _____

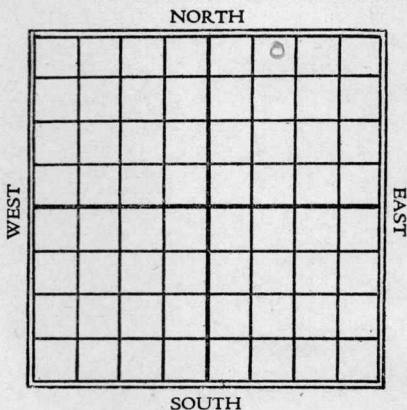

Drilling at 2200 ft. Fishing at _____ ft.

Total Depth _____ Completed _____

1st 24 Hrs. Nat. _____ Producing _____

1st 24 Hrs. Shot _____ Dry Hole _____

Gas _____ Cu. ft. Abandoned _____

Sands — give name and depth. Top _____ Bottom _____

Date of Report 7/23

Pyle

Reported by _____

Map No. 514 Sec. 8 Twp. 23 R. 4Well No. 1 HoldingSinclair Oil Co. Company

Contractor

SECTION PLAT

		0	

200 Ft. from N. Line

Ft. from S. Line

Ft. from E. Line

1120 Ft. from W. Line

Location

Rig up

Drilling and Remarks:

RECORD

Cased _____ in., _____ ft.

Sand _____

Gas _____

Oil _____

Total Depth _____

PRODUCTION

1st 24 hrs. Nat. _____

1st 24 hrs. after shot _____

Gas _____ Cu. Ft.

Dry Hole _____

Abandoned _____

Date

8/25 1919

Pyle

Scout

Map No. _____ Sec. 8 Twp. 23 R. 4Well No. 1 HodenLincoln O & G Company

Contractor _____

SECTION PLAT

		0	

200 Ft. from N. Line

_____ Ft. from S. Line

_____ Ft. from E. Line

1170 Ft. from W. Line

RECORD

Location _____

Rig up _____

Drilling and Remarks:

Cased _____ in., _____ ft.

Sand _____

Gas _____

Oil' _____

Total Depth _____

PRODUCTION

1st 24 hrs. Nat. _____

1st 24 hrs. after shot _____

Gas _____ Cu. Ft.

Dry Hole _____

Abandoned _____


Date

9-13 1919 officer Scout

Map No. K14 Sec. 8 Twp. 23 R. 4Well No. 1 HoldenSinclair Company

Contractor

SECTION PLAT

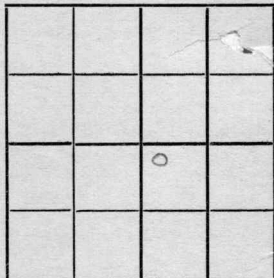200 Ft. from N. Line

Ft. from S. Line

Ft. from E. Line

200 Ft. from W. Line

Location

Rig up

Drilling and Remarks:

Rig.

RECORD

Cased _____ in., _____ ft.

Sand _____

Gas _____

Oil _____

Total Depth _____

PRODUCTION

1st 24 hrs. Nat. _____

1st 24 hrs. after shot _____

Gas _____ Cu. Ft.

Dry Hole _____

Abandoned _____

Date

10/14 1919Pyle

Scout

Map No. K 14 Sec. 8 Twp. 23 R. 4
 Well No. 1 Holden
Sinclair Oil Co. Company
 _____ Contractor

SECTION PLAT

200 Ft. from N. Line
 _____ Ft. from S. Line
11 Ft. from E. Line
1120 Ft. from W. Line

		<u>6</u>	

Location _____
 Rig up _____
 Drilling and Remarks:

RECORD

Cased _____ in., _____ ft.
 Sand 2474 - 2476
 Gas _____
 Oil _____
 Total Depth _____

PRODUCTION

1st 24 hrs. Nat. 250 bbls
 1st 24 hrs. after shot _____
 Gas _____ Cu. Ft.
 Dry Hole _____
 Abandoned _____

Date

9/5 1919

Pyle

Scout

K14

MAP NO. KANSAS SEC. 8 TWP. 23S R. ✓E

WELL NO. 1 Halden

Senclan COMPANY

CONTRACTOR

SECTION PLAT

ABANDONED

_____ FT. FROM N. LINE

_____ FT. FROM S. LINE

_____ FT. FROM E. LINE

_____ FT. FROM W. LINE

RECORD

LOCATION _____

CASED _____ IN. _____ FT.

RIG UP _____

SAND _____

DRILLING AND REMARKS:

GAS _____

OIL _____

TOTAL DEPTH 2477

PRODUCTION

1ST 24 HRS. NAT. _____

1ST 24 HRS. AFTER SHOT _____

GAS _____ Cu. Ft.

DRY HOLE _____

ABANDONED ✓

DATE

9/22 1919

SCOUT