


Map No. K14 Sec. 8 Twp. 23 R. 4
 Well No. 1 Holden Farm

NORTH

WEST

EAST

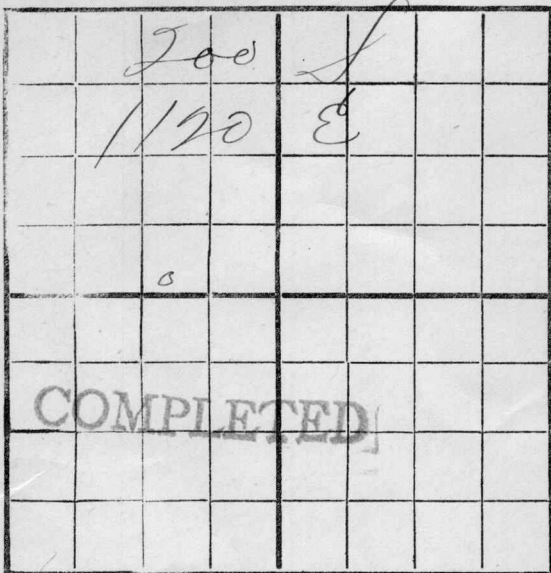

SOUTH

Location -----

Rig Up -----

Drilling Remarks:

Drilling Remarks:

RECORD

Cased ----- in. ----- ft.

Sand -----

Gas -----

Oil -----

Total Depth -----

PRODUCTION

1st 24 hrs. Nat. -----

1st 24 hrs. after shot -----

Gas ----- cu. ft.

Dry Hole -----

Abandoned -----

Map No. 514 Sec. 8 Twp. 23 R. 4Well No. 1 HoldenJim Davis et al Company

Contractor

SECTION PLAT

Ft. from N. Line

200 Ft. from S. Line1120 Ft. from E. Line

Ft. from W. Line



(26 Acres in this strip)

Location

Rig up

Drilling and Remarks:

Timbers

RECORD

Cased _____ in., _____ ft.

Sand _____

Gas _____

Oil _____

Total Depth _____

PRODUCTION

1st 24 hrs. Nat. _____

1st 24 hrs. after shot _____

Gas _____ Cu. Ft.

Dry Hole _____

Abandoned _____

Date

9/15 1919

Pyle

Scout

Map No. K14 Sec. 8 Twp. 23 R. 4Well No. 1 HolderDavis et al Company

Contractor

SECTION PLAT

	0		

Ft. from N. Line

200 Ft. from S. Line1120 Ft. from E. Line

Ft. from W. Line

RECORD

Location

Rig up

Drilling and Remarks:

Cased in, ft.

Sand

Gas

Oil

Total Depth

PRODUCTION

1st 24 hrs. Nat.

1st 24 hrs. after shot

Gas Cu. Ft.

Dry Hole

Abandoned

Date

9/15 1919

Pyle

Scout

Map No. K14 Sec. 8 Twp. 23 R. 4Well No. 1 HolderJim Davis et al Company

Contractor

SECTION PLAT

Ft. from N. Line

200 Ft. from S. Line

Ft. from E. Line

1120 Ft. from W. Line

RECORD

Location

Cased _____ in., _____ ft.

Rig up

Sand _____

Drilling and Remarks:

Gas _____

Oil _____

Total Depth _____

PRODUCTION

1st 24 hrs. Nat. _____

1st 24 hrs. after shot _____

Gas _____ Cu. Ft.

Dry Hole _____

Abandoned _____

Date

9/
23 1919

Pyle

Scout

Map No. K14 Sec. 8 Twp. 23 R. 4Well No. 1 HoldenJim Davis et al Company1 Contractor

SECTION PLAT

-----Ft. from N. Line

200 Ft. from S. Line1120 Ft. from E. Line

-----Ft. from W. Line

Location -----

Rig up -----

Drilling and Remarks:

RECORD

Cased ----- in., ----- ft.

Sand -----

Gas -----

Oil -----

Total Depth -----

PRODUCTION

1st 24 hrs. Nat. -----

1st 24 hrs. after shot -----

Gas ----- Cu. Ft.

Dry Hole -----

Abandoned -----

Date

9/30 1919

Pyle

Scout

Map No. K 14 Sec. 8 Twp. 23 R. 4

Well No. 1 Holder
Jim Davis et al Company

Contractor

SECTION PLAT

_____ Ft. from N. Line
200 Ft. from S. Line
1120 Ft. from E. Line
_____ Ft. from W. Line

Location _____

Rig up _____

Drilling and Remarks:

2453 T.W.
Dry and
abandoned
Had small
show of oil
at 2450

RECORD

Cased _____ in., _____ ft.
Sand _____
Gas _____
Oil _____
Total Depth _____

PRODUCTION

1st 24 hrs. Nat. _____
1st 24 hrs. after shot _____
Gas _____ Cu. Ft.
Dry Hole _____
Abandoned _____

Date 10/14 1919 Pyle Scout

Butler
 K14 MAP NO. KANSAS SEC. 8 TWP. 23S R. ✓E

WELL NO. 1 Halden

Blount et al COMPANY

CONTRACTOR

SECTION PLAT

_____ FT. FROM N. LINE

_____ FT. FROM S. LINE

_____ FT. FROM E. LINE

_____ FT. FROM W. LINE

ABANDONED

LOCATION _____

RIG UP _____

DRILLING AND REMARKS:

RECORD

CASED _____ IN. _____ FT.

SAND _____

GAS _____

OIL _____

TOTAL DEPTH 2453

PRODUCTION

1ST 24 HRS. NAT. _____

1ST 24 HRS. AFTER SHOT _____

GAS _____ CU. FT.

DRY HOLE ✓

ABANDONED ✓

DATE

10/14 1919 SCOUT