


Map No. _____ Sec. 2 Twp. 26 R. 4

Well No. 33 Paulson Farm
Empire Company

NORTH

WEST

EAST

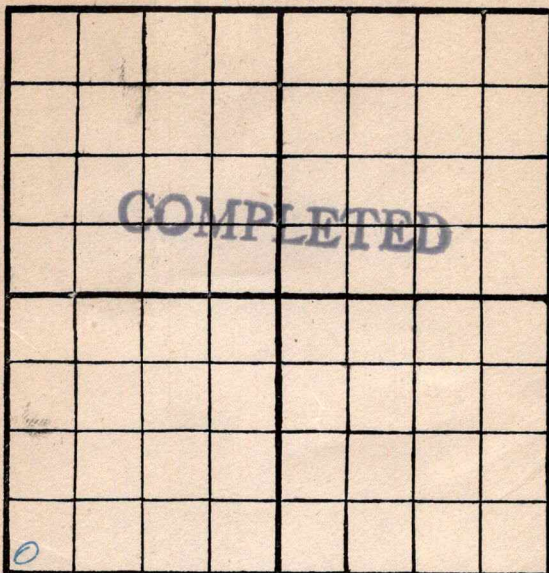

SOUTH

Location _____

Rig Up _____

Drilling Remarks:

Drilling Remarks:

RECORD

Cased _____ in. _____ ft.

Sand _____

Gas _____

Oil _____

Total Depth _____

PRODUCTION

1st 24 hrs. Nat. _____

1st 24 hrs. after shot _____

Gas _____ cu. ft

Dry Hole _____

Abandoned _____

Map No. K14 Sec. 2 Twp. 26 R. 4Well No. 33 Paulson FarmEmpire Company

NORTH

WEST

EAST

SOUTH

Location ✓Rig Up ✓

Drilling and remarks

RECORD

Cased _____ in. _____ Ft.

Sand _____

Gas _____

Oil _____

Total Depth _____

PRODUCTION

1st 24 hrs. Nat. _____

1st 24 hrs. after shot _____

Gas _____ Cu. Ft.

Dry Hole _____

Abandoned _____

FIRST REPORT

Date

9/26, 1917 Condy Scout

Map No. _____ Sec. 2 Twp. 26 R. 4

Well No. 33 Paulson Farm

Engine Company

NORTH

WEST

EAST

SOUTH

Location _____

Rig up ☒ _____

Drilling and remarks:

RECORD

Cased _____ in. _____ Ft.

Sand _____

Gas _____

Oil _____

Total Depth _____

PRODUCTION

1st 24 hrs. Nat. _____

1st 24 hrs. after shot _____

Gas _____ Cu. Ft.

Dry Hole _____

Abandoned _____


Date

10/9, 191, 2 Paulson Scout

Map No. _____ Sec. 2 Twp. 26 R. 4Well No. 33 Paulson Farm _____
Engine Company _____

NORTH

WEST

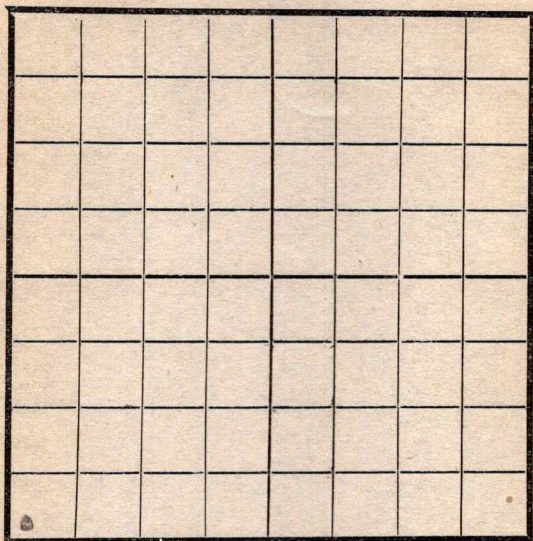

EAST

SOUTH

Location _____

Rig Up ☒ _____

Drilling and remarks _____

RECORD

Cased _____ in. _____ Ft.

Sand _____

Gas _____

Oil _____

Total Depth _____

PRODUCTION

1st 24 hrs. Nat. _____

1st 24 hrs. after shot _____

Gas _____ Cu. Ft.

Dry Hole _____

Abandoned _____

Date

11-7, 1917 Paulson Scout _____

Map No. _____ Sec. 2 Twp. 26 R. 4
 Well No. 33 Paulson Farm _____
Engine Company _____

NORTH

WEST

EAST

SOUTH

Location _____
 Rig Up _____
 Drilling and remarks

400

RECORD

Cased _____ in. _____ Ft.
 Sand _____
 Gas _____
 Oil _____
 Total Depth _____

PRODUCTION

1st 24 hrs. Nat. _____
 1st 24 hrs. after shot _____
 Gas _____ Cu. Ft.
 Dry Hole _____
 Abandoned _____

Date

11/14, 1917 Condyff Scout _____

Map No. _____ Sec. 2 Twp. 26 R. 4Well No. 33 Paulson Farm _____

Company _____

NORTH

WEST

EAST

SOUTH

Location _____

Rig Up _____

Drilling and remarks

RECORD

Cased _____ in. _____ Ft.

Sand _____

Gas _____

Oil _____

Total Depth _____

PRODUCTION

1st 24 hrs. Nat. _____

1st 24 hrs. after shot _____

Gas _____ Cu. Ft.


Dry Hole _____

Abandoned _____

Date

11/21, 1917 Candey Scout

Map No. _____ Sec. 2 Twp. 26 R. 4
Well No. 33 Paulson Farm _____
Empire Company _____
NORTH

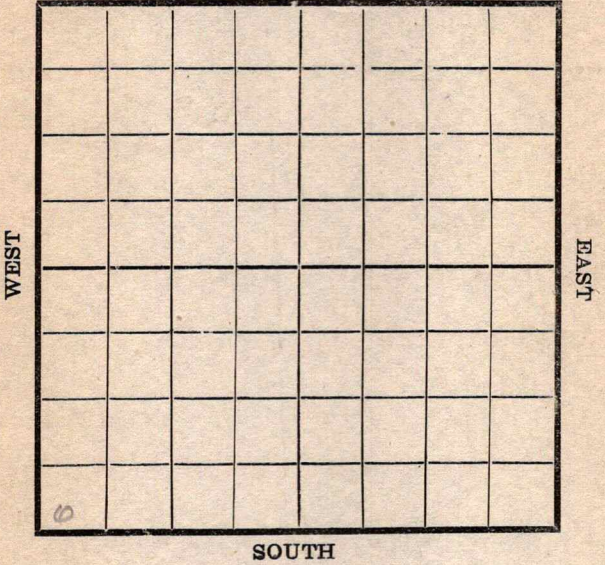

	RECORD
Location _____	Cased _____ in. _____ Ft.
Rig Up _____	Sand _____
Drilling and remarks	Gas _____
<u>1100</u>	Oil _____
	Total Depth _____
	PRODUCTION
	1st 24 hrs. Nat. _____
	1st 24 hrs. after shot _____
	Gas _____ Cu. Ft.
	Dry Hole _____
	Abandoned _____

Date 11/28, 1917 Paulson Scout

Map No. _____ Sec. 2 Twp. 26 R. 4Well No. 33 Paulson Farm _____Empire Company _____

NORTH

WEST

EAST

SOUTH

Location _____

Rig Up _____

Drilling and remarks

1350

RECORD

Cased _____ in. _____ Ft.

Sand _____

Gas _____

Oil _____

Total Depth _____

PRODUCTION

1st 24 hrs. Nat. _____

1st 24 hrs. after shot _____

Gas _____ Cu. Ft.

Dry Hole _____

Abandoned _____


Date

12/5, 1917 Condy Scout _____

Map No. _____ Sec. 2 Twp. 26 R. 4
 Well No. 33 Paulson Farm _____
Carpine Company _____

NORTH

WEST

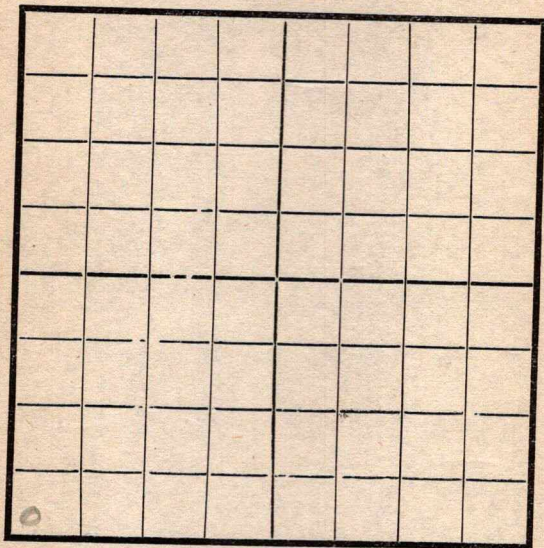

EAST

SOUTH

Location _____
 Rig Up _____
 Drilling and remarks _____

LD 1350

RECORD

Cased _____ in. _____ Ft.
 Sand _____
 Gas _____
 Oil _____
 Total Depth _____

PRODUCTION

1st 24 hrs. Nat. _____
 1st 24 hrs. after shot _____
 Gas _____ Cu. Ft.
 Dry Hole _____
 Abandoned _____

Date

1/2, 1918 J. Carney Scout

Map No. _____ Sec. 2 Twp. 26 R. 4Well No. 33 Paulson FarmEngine Company

NORTH

WEST

EAST

SOUTH

Location _____

Rig Up _____

Drilling and remarks

2170

RECORD

Cased _____ in. _____ Ft.

Sand _____

Gas _____

Oil _____

Total Depth _____

PRODUCTION

1st 24 hrs. Nat. _____

1st 24 hrs. after shot _____

Gas _____ Cu. Ft.

Dry Hole _____

Abandoned _____

Date


1/16, 1911 S. Paulson Scout

Map No. _____ Sec. 2 Twp. 26 R. 4
Well No. 33 Paulson Farm _____
Empire Company _____

NORTH

WEST

EAST

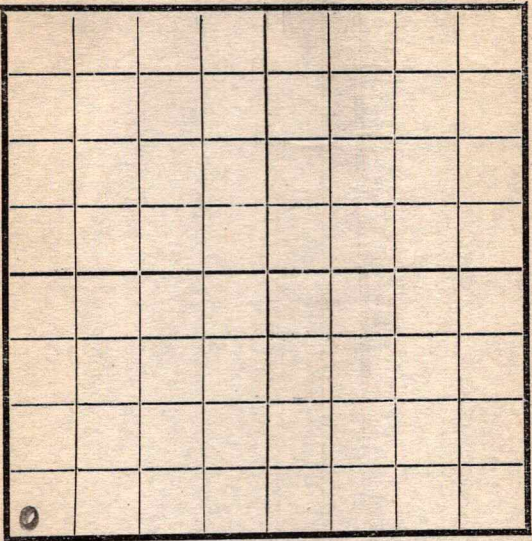

SOUTH

Location _____
Rig Up _____
Drilling and remarks

2200

RECORD

Cased _____ in. _____ Ft.
Sand _____
Gas _____
Oil _____
Total Depth _____

PRODUCTION


1st 24 hrs. Nat. _____
1st 24 hrs. after shot _____
Gas _____ Cu. Ft.
Dry Hole _____
Abandoned _____

Date 1/23 1918 C. Cardiff Scout _____

Map No. _____ Sec. 2 Twp. 26 R. 4Well No. 33 Paulson Farm __________Empire Company _____

NORTH

WEST

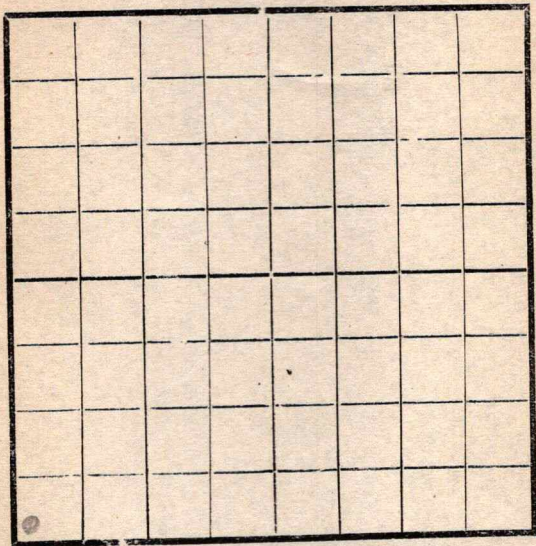

EAST

SOUTH

Location _____

Rig Up _____

Drilling and remarks

*Shut Down
on top sand
2385*

RECORD

Cased _____ in. _____ Ft.

Sand _____

Gas _____

Oil _____

Total Depth _____

PRODUCTION

1st 24 hrs. Nat. _____

1st 24 hrs. after shot _____

Gas _____ Cu. Ft.

Dry Hole _____

Abandoned _____

Date

1/30, 1918 S. Conroy Scout

WEST

EAST

SOUTH

RECORD

Location -----

Rig Up -----

Drilling and remarks

Cased----- in-----Ft.

Sand -----

Gas _____

Oil _____

Total Depth -----

PRODUCTION

1st 24 hrs. Nat.-----

1st 24 hrs. after shot-----

Gas ----- Cu. Ft

Dry Hole -----

Abandoned -----

Date _____

256 191 J. C. C. Scout

Map No. _____ Sec. 2 Twp. 36 R. 4Well No. 33 Paulson FarmEngine Company

NORTH

WEST

EAST

SOUTH

Location _____

Rig Up _____

Drilling and remarks

Estimated
at 900
Bbls

RECORD

Cased _____ in. _____ Ft.

Sand 2391-2471

Gas _____

Oil _____

Total Depth _____

PRODUCTION

1st 24 hrs. Nat. _____

1st 24 hrs. after shot _____

Gas _____ Cu. Ft.

Dry Hole _____

Abandoned _____

Date

2/13, 1918 Conroy Scout