


Map No. _____ Sec. 2 Twp. 26 R. 4
 Well No. 36 Paulson Farm _____
Empire Company
 NORTH

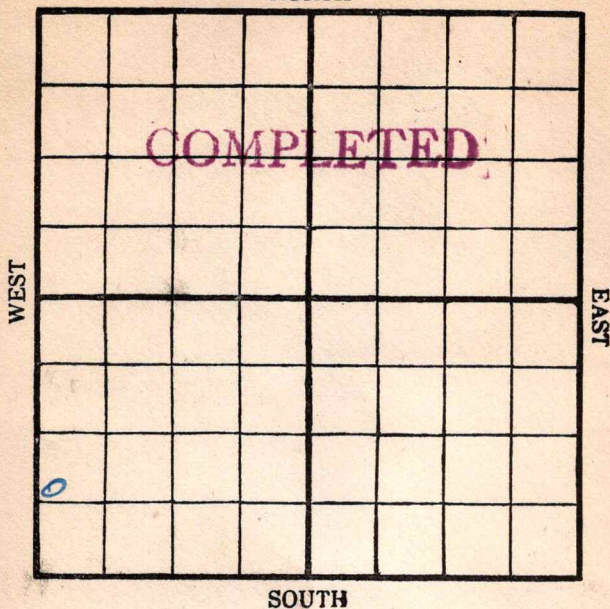

Location _____

Rig Up _____

Drilling Remarks:

Drilling Remarks:

Dry & Abandoned 2465 ft
6 1/2 ft

RECORD

Cased _____ in. _____ ft.

Sand _____

Gas _____

Oil _____

Total Depth _____

PRODUCTION

1st 24 hrs. Nat. _____

1st 24 hrs. after shot _____

Gas _____ cu. ft

Dry Hole _____

Abandoned _____

Map No. _____ Sec. 2 Twp. 26 R. 4

Well No. 36 Paulson Farm _____

Engine Company _____

NORTH

SOUTH

Location _____

Rig up _____

Drilling and remarks:

RECORD

Cased _____ in. _____ Ft.

Sand _____

Gas _____

Oil _____

Total Depth _____

PRODUCTION

1st 24 hrs. Nat. _____

1st 24 hrs. after shot _____

Gas _____ Cu. Ft.

Dry Hole _____

Abandoned _____

FIRST REPORT

Date

11-7, 1917, Paulson Scout

Map No. _____ Sec. 2 Twp. 26 R. 4
 Well No. 36 Paulson Farm _____
Empire Company _____

NORTH

WEST

EAST

SOUTH

Location ✓Rig Up ✓

Drilling and remarks

RECORD

Cased _____ in. _____ Ft.

Sand _____

Gas _____

Oil _____

Total Depth _____

PRODUCTION

1st 24 hrs. Nat. _____

1st 24 hrs. after shot _____

Gas _____ Cu. Ft.

Dry Hole _____

Abandoned _____


Date

11/14, 1917 Cardiff Scout _____

Map No. _____ Sec. 2 Twp. 26 R. 4Well No. 36 Paulson Farm _____Empire Company _____

NORTH

WEST

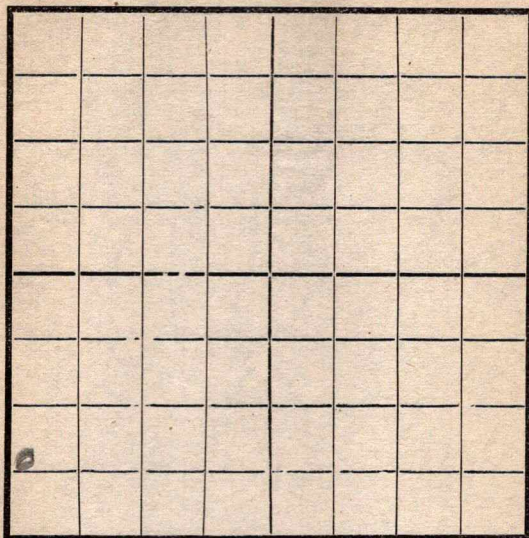

EAST

SOUTH

Location _____

Rig Up ☒ _____

Drilling and remarks _____

RECORD

Cased _____ in. _____ Ft.

Sand _____

Gas _____

Oil _____

Total Depth _____

PRODUCTION

1st 24 hrs. Nat. _____

1st 24 hrs. after shot _____

Gas _____ Cu. Ft.

Dry Hole _____

Abandoned _____

Date


11/21, 1917 Paulson Scout _____

Map No. _____ Sec. 2 Twp. 26 R. 4
Well No. 36 Paulson Farm _____
Englund Company

NORTH

WEST

EAST

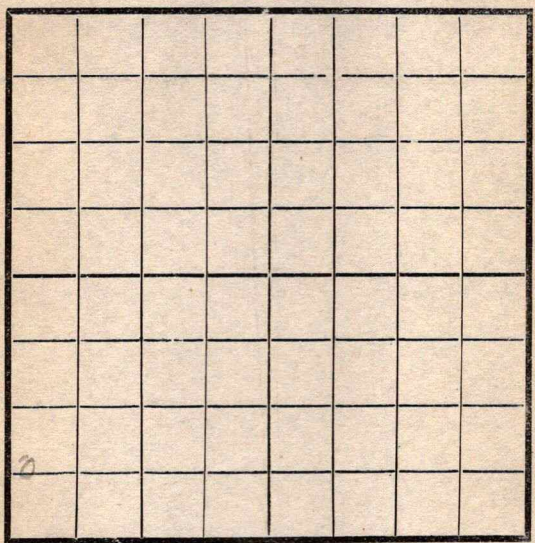

SOUTH

Location _____
Rig Up ☒ _____
Drilling and remarks _____

RECORD

Cased _____ in. _____ Ft.
Sand _____
Gas _____
Oil _____
Total Depth _____

PRODUCTION

1st 24 hrs. Nat. _____
1st 24 hrs. after shot _____
Gas _____ Cu. Ft.
Dry Hole _____
Abandoned _____

Date

11/28, 1917 Condy Scout

Map No. K14 Sec. 2 Twp. 26 R. 4Well No. 36 Paulson FarrEmpire Company

NORTH

WEST

EAST

SOUTH

Location ✓Rig Up ✓

Drilling and remarks

RECORD

Cased in FSand Gas Oil Total Depth

PRODUCTION

1st 24 hrs. Nat. 1st 24 hrs. after shot Gas Cu. FDry Hole Abandoned

Date

7/20, 1918 Carly ScoutFirst Report

Map No. _____ Sec. 2 Twp. 26 R. 4
 Well No. 36 Paulson Farm _____
Chippewa Company _____

NORTH

WEST

EAST

SOUTH

Location _____
 Rig Up _____
 Drilling and remarks

Spudding
Howard Dilling
Co
E. P. Dredge

RECORD

Cased _____ in. _____ Ft.
 Sand _____
 Gas _____
 Oil _____
 Total Depth _____

PRODUCTION

1st 24 hrs. Nat. _____
 1st 24 hrs. after shot _____
 Gas _____ Cu. Ft.
 Dry Hole _____
 Abandoned _____

Date

4/17, 1911 S. Cardy Scout

Map No. _____ Sec. 2 Twp. 26 R. 4Well No. 36 Paulson Farm

Company

NORTH

WEST

EAST

SOUTH

Location _____

Rig Up _____

Drilling and remarks

510

RECORD

Cased _____ in. _____ Ft.

Sand _____

Gas _____

Oil _____

Total Depth _____

PRODUCTION

1st 24 hrs. Nat. _____

1st 24 hrs. after shot _____

Gas _____ Cu. Ft.

Dry Hole _____

Abandoned _____

Date

4/24, 1918 S. Paulson

Scout

Map No. _____ Sec. 2 Twp. 26 R. 4Well No. 36 Paulson Farm _____Company Cummins

NORTH

WEST

EAST

SOUTH

Location _____

Rig Up _____

Drilling and remarks

1070

RECORD

Cased _____ in _____ Ft.

Sand _____

Gas _____

Oil _____

Total Depth _____

PRODUCTION

1st 24 hrs. Nat. _____

1st 24 hrs. after shot _____

Gas _____ Cu. Ft.

Dry Hole _____

Abandoned _____

Date

5/1, 191


Scout J. C. Cady

Map No. _____ Sec. 2 Twp. 26 R. 4
 Well No. 36 Paulson Farm _____
Empire Company _____

NORTH

WEST

EAST

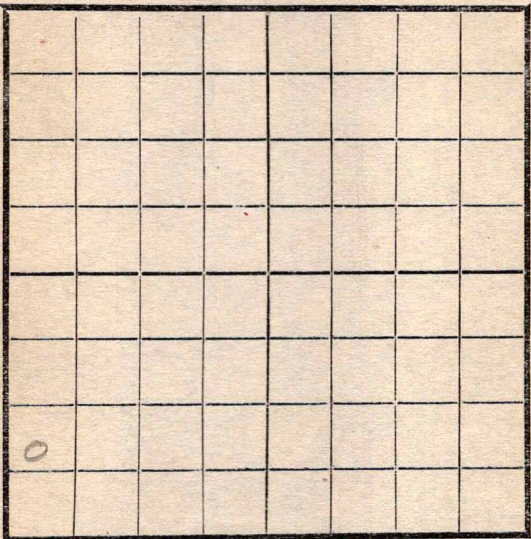


SOUTH

RECORD	
Location _____	Cased _____ in. _____ Ft.
Rig Up _____	Sand _____
Drilling and remarks	Gas _____
	Oil _____
	Total Depth _____
	PRODUCTION 1st 24 hrs. Nat. _____ 1st 24 hrs. after shot _____ Gas _____ Cu. Ft. Dry Hole _____ Abandoned _____

1380

Date _____
5/8, 1918 J. Conder Scout

Map No. _____ Sec. 7 Twp. 26 R. 4
 Well No. 36 Poulson Farm _____
Engine Company _____
 NORTH

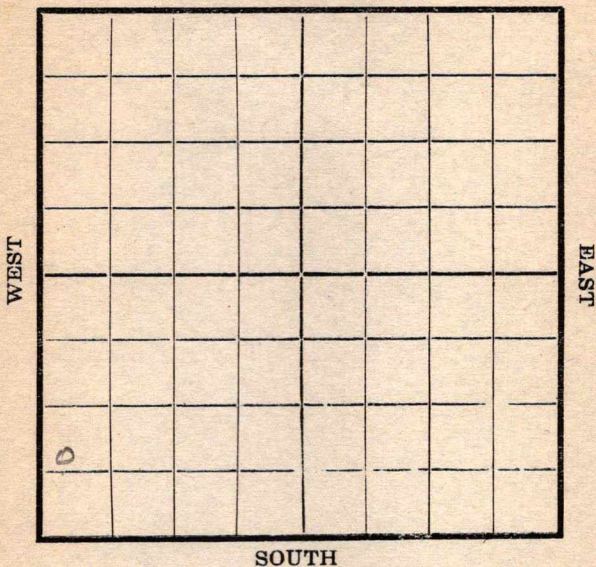

Location _____
 Rig Up _____
 Drilling and remarks

1850

RECORD

Cased _____ in _____ Ft.
 Sand _____
 Gas _____
 Oil _____
 Total Depth _____


PRODUCTION

1st 24 hrs. Nat. _____
 1st 24 hrs. after shot _____
 Gas _____ Cu. Ft.
 Dry Hole _____
 Abandoned _____

Date

5/15, 1918 S. C. C. C. Scout _____

Map No. _____ Sec. 2 Twp. 26 R. 4
 Well No. 36 Paulson Farm
Empire Company
 NORTH

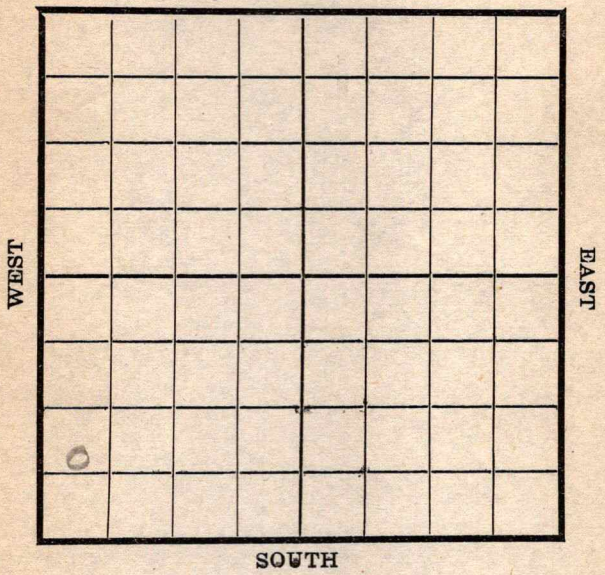

Location _____ Rig Up _____ Drilling and remarks <u>2110</u>	RECORD
	Cased _____ in. _____ Ft.
	Sand _____
	Gas _____
	Oil _____
	Total Depth _____
	PRODUCTION
	1st 24 hrs. Nat. _____
	1st 24 hrs. after shot _____
	Gas _____ Cu. Ft.
	Dry Hole _____
	Abandoned _____

Date 5/22/1918 S. Cardy Scout

Map No. _____ Sec. 2 Twp. 26 R. 4Well No. 36 Paulson Farm __________
Company _____

NORTH

WEST

EAST

SOUTH

Location _____

Rig Up _____

Drilling and remarks

RECORD

Cased _____ in. _____ Ft.

Sand _____

Gas _____

Oil _____

Total Depth _____

PRODUCTION

1st 24 hrs. Nat. _____

1st 24 hrs. after shot _____

Gas _____ Cu. Ft.

Dry Hole _____

Abandoned _____

Date

3/29, 1918 L. Conley Scout _____

Map No. K14 Sec. 2 Twp. 26 R. 4Well No. 36 Paulson Farm
Empire Company

NORTH

WEST

EAST

COMPLETED

SOUTH

RECORD

Location -----

Cased ----- in ----- Ft.

Rig Up -----

Sand 2381-2465

Drilling and remarks

Gas -----

Oil -----

Total Depth -----

PRODUCTION

1st 24 hrs. Nat. -----

1st 24 hrs. after shot -----

Gas ----- Cu. Ft.

Dry Hole -----

Abandoned -----

Date

6/5, 1918 S. Cardy Scout

K14

MAP No. KANSAS SEC. 7 TWP. 26 S. R. 4 E

WELL No. 36 Paulson

Empire COMPANY

CONTRACTOR

ABANDONED

SECTION PLAT

0			

_____ FT. FROM N. LINE

_____ FT. FROM S. LINE

_____ FT. FROM E. LINE

_____ FT. FROM W. LINE

LOCATION _____

RIG UP _____

DRILLING AND REMARKS:

RECORD

CASED _____ IN. _____ FT.

SAND _____

GAS _____

OIL _____

TOTAL DEPTH 2465

PRODUCTION

1ST 24 HRS. NAT. _____

1ST 24 HRS. AFTER SHOT _____

GAS _____ CU. FT.

DRY HOLE ☒

ABANDONED ☒

DATE

6-5 1918

SCOUT