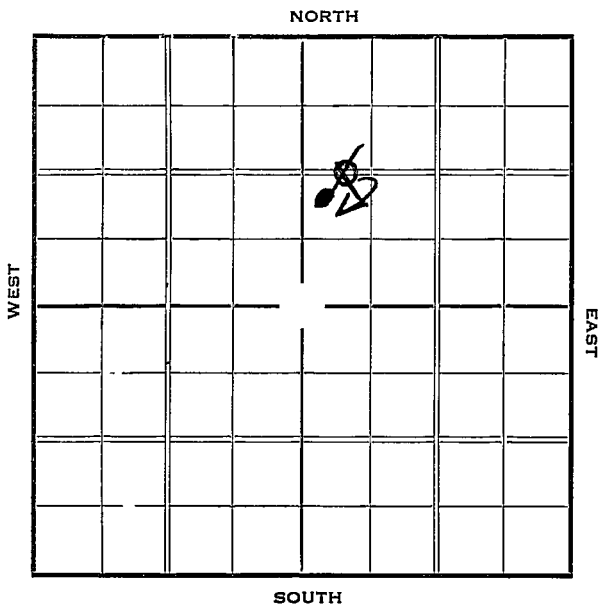
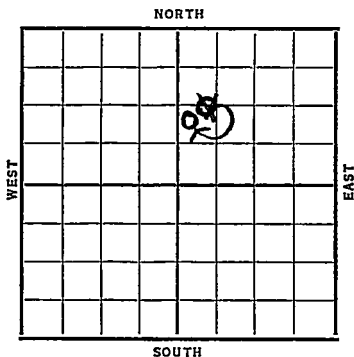


Section 27 Township 23 Range 13-EWell Number 1 - PinonCompany Kansas City Producing
N. N. Hubbard

Sec. 27 Twp. 23 R. 13-EWell No. #1 Pinon Farm
Kansas City Producing
S. S. Hubbard Company~~1580~~ Ft. from N. Line1120 Ft. from S. Line

Ft. from E. Line

200
~~440~~ Ft. from W. Line

Date	REPORT
1937	
5/12	Mach. on ground.
5/21	Rig'n.
5/28	"
6/4	12" @ 100'. Drlg. 800'.
6/11	SD @ 900'.
6/19	" "
6/25	Drlg. 1050'.
7/2	8" @ 1290'. Drlg. 1615'.
7/9	" " " " "
7/16	" " " " "
7/23	" " " " "
7/30	SD @ 1750'.
8/6	" "
8/13	T.D. 1800'. 400' oil. S.D.O.
8/20	" " " "
8/28	" " " "
9/3	" " " "
9/10	" " " "
9/17	" " " "
9/24	" " " "
10/2	" " " "

OVER

1937

10/6 7" @ 1773'.

Miss. 1780'.

T.D. 1810'.

2000 acid.

Pot. 12 oil & 10 water.

COMPLETED

KANSAS*Greenwood*Map No. *17M* Sec. *27* Twp. *23R13E*Well No. *1 - Pinon**C. C. Hubbard* Company

Contractor

FIRST REPORT**SECTION PLAT**

		o	

1320 Ft. from N. Line

_____ Ft. from S. Line

_____ Ft. from E. Line

440 Ft. from W. Line

Location _____

Rig up _____

Drilling and Remarks:

*mach. on
ground***RECORD**

Cased _____ in., _____ ft.

Sand _____

Gas _____

Oil _____

Total Depth _____

PRODUCTION

1st 24 hrs. Nat. _____

1st 24 hrs. after shot _____

Gas _____ Cu. Ft.

Dry Hole _____

Abandoned _____

Date

MAY 12 1937 19**E. D. Hatfield**

Scout

Map No. 17 Sec. 27 Twp. 23 R. 13Well No. 1-PinonC. C. Hubbard Company

Contractor

CORRECTION

SECTION PLAT

Ft. from N. Line

1120

Ft. from S. Line

990

Ft. from E. Line

200

Ft. from W. Line

330

		0	

Location _____

Rig up _____

Drilling and Remarks:

RECORD

Cased _____ in., _____ ft.

Sand _____

Gas _____

Oil _____

Total Depth _____

PRODUCTION

1st 24 hrs. Nat. _____

1st 24 hrs. after shot _____

Gas _____ Cu. Ft.

Dry-Hole _____

Abandoned _____

Date

JUN 9 1937₁₉

H. D. Hatfield

Scout

Was first reported
as loc. in
C W L NE

Is this a twin well *no*
we show a completed well at this
location. Check and advise
Sam

*Loc. was corrected last
week but no foot meas.
given out.*

H.

2

RAY

Returned	<i>[Signature]</i>
Cards	<i>[Signature]</i>
Tracing	<i>[Signature]</i>
France Map	<i>[Signature]</i>
Scarborough Map	<i>[Signature]</i>
Moody Map	<i>[Signature]</i>
Scarborough Plat Book	
Moody Plat Book	

KANSAS

26 1M Bks. 2-25

Greenwood

Map No. 17^M Sec. 27 Twp. 23 R. 13^E

Well No. 1- Pinon

Kansas City Producing

Company

Purchased From C.C. Hubbard

Contractor

CORRECTION

SECTION PLAT

		0	

_____ Ft. from N. Line

1120 Ft. from S. Line

_____ Ft. from E. Line

200 Ft. from W. Line

Location _____

Rig up _____

Drilling and Remarks:

was drilled by
C.C. Hubbard and
sold To above Co.

RECORD

Cased _____ in., _____ ft.

Sand _____

Gas _____

Oil _____

Total Depth _____

PRODUCTION

1st 24 hrs. Nat. _____

1st 24 hrs. after shot _____

Gas _____ Cu. Ft.

Dry Hole _____

Abandoned _____

Date

OCT - 6 1937 19

E. D. Hatfield

Scout

Map No. _____ Sec. 27 Twp. 23 R. 13EWell No. 1 Pinon

K. C. Producing Company
 (Formerly C.C. Hubbard) Contractor

COMPLETED

SECTION PLAT

NW SW NE
 1120 Ft. from N. Line
 1120 Ft. from S. Line
 _____ Ft. from E. Line
 200 Ft. from W. Line

		0	

Location _____

Rig up _____

Drilling and Remarks:

*2000 Acid**POT- 12 oil
10 water*

RECORD

Cased 7 in., 1773 ft.Sand MISS 1780

Gas _____

Oil _____

Total Depth 1810

PRODUCTION

1st 24 hrs. Nat. _____

1st 24 hrs. after shot _____

Gas _____ Cu. Ft.

Dry Hole _____

Abandoned _____

Date

OCT 26 1937

19

H. D. Hatfield Scout