
Form 51—10M—8-19—CroMac

Map No. _____ Sec. 11 Twp. 23 R. 4

Well No. J. F. D. Bell Farm

Kansolo Oil Co. Company

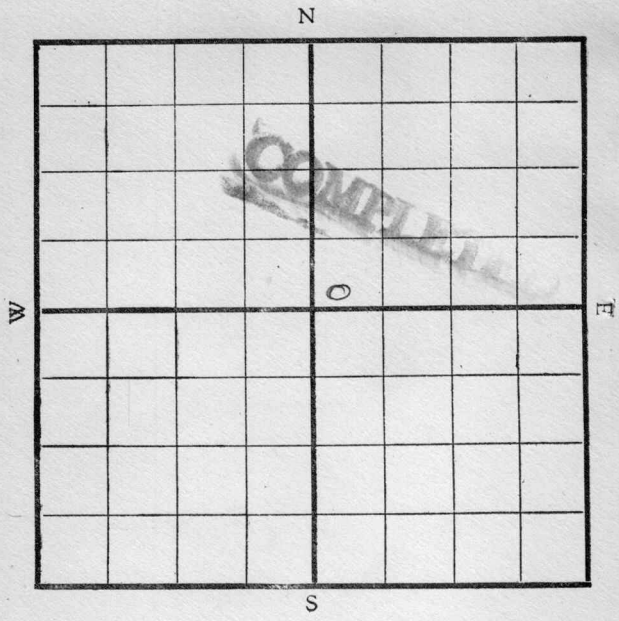

Location _____

Drilling Remarks:

Rig Up _____

Drilling Remarks:

RECORD

Cased _____ in. _____ ft.

Sand _____

Gas _____

Oil _____

Total Depth _____

PRODUCTION

1st 24 hrs. Nat. _____

1st 24 hrs. after shot _____

Gas _____ cu. ft.

Dry Hole _____

Abandoned _____

Form 252A 2M-10-19 CroMac.

Map No. _____ Sec. 11 Twp. 23 R. 4

Well No. 1. F. I. Bell Farm

Hamota Oil & Gas Co. Company

_____ Contractor


NE. Quarter

_____ Ft. from N. Line

700 Ft. from S. Line

_____ Ft. from E. Line

700 Ft. from W. Line

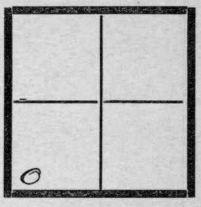

Date	REPORT
10/31	Rig up FIRST REPORT
11/4	Rig
12	Rig
19	Tools.
25	Spudding.
12/2	DR 400
9	Fishing tools 700'
16	Fish tools 700'
23	Fishing 700'
11/30	Fishing tools 700'
6	870'
14	DR 1440'
19	H. R. 8¼ to 1845'
27	H. R. 8¼ to 1845'
29/2	DR 1455'
9	Hole full water 2535'
16	Dry & abandoned 2535' COMPLETED

Form 26—1M—4-19—Mid-West


Map No. K14 Sec. 11 Twp. 23 R. 4

Well No. 1 F. I. Bell

Tamoto O & G Company

Contractor

SECTION PLAT

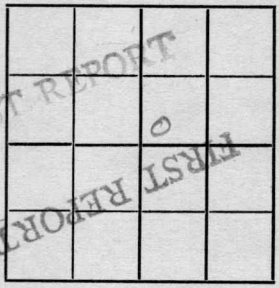

Ft. from N. Line

200 Ft. from S. Line

Ft. from E. Line

200 Ft. from W. Line

Location

Rig up ✓

Drilling and Remarks:

RECORD

Cased in., ft.

Sand

Gas

Oil

Total Depth

PRODUCTION

1st 24 hrs. Nat.

1st 24 hrs. after shot

Gas Cu. Ft.

Dry Hole

Abandoned

Date

10/31/191 9.

Pyle Scout

Butler

FORM 26 250 BKS. 4-28 WESTERN

K14 KANSAS SEC. 11 TWP. 23S R. 4E


WELL NO. 1 Bell

Skamata O & G. COMPANY

CONTRACTOR

ABANDONED

SECTION PLAT

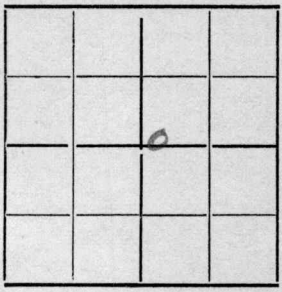

_____ FT. FROM N. LINE

_____ FT. FROM S. LINE

_____ FT. FROM E. LINE

_____ FT. FROM W. LINE

LOCATION _____

RIG UP _____

DRILLING AND REMARKS:

OK

RECORD

CASED _____ IN., _____ FT.

SAND _____

GAS _____

OIL _____

TOTAL DEPTH 2535

PRODUCTION

1ST 24 HRS. NAT. _____

1ST 24 HRS. AFTER SHOT _____

GAS _____ CU. FT.

DRY HOLE ✓

ABANDONED ✓

DATE 2/9

_____ 1920 _____ SCOUT

Form 26—1M—4-19—Mid-West

Map No. K 14 Sec. 11 Twp. 23 R. 4

Well No. 1 Bell

Okamoto O & G Company

Contractor

SECTION PLAT



Ft. from N. Line

200 Ft. from S. Line

Ft. from E. Line

200 Ft. from W. Line

COMPLETED

Location

Rig up

Drilling and Remarks:

RECORD

Cased in., ft.

Sand

Gas

Oil

Total Depth

PRODUCTION

1st 24 hrs. Nat.

1st 24 hrs. after shot

Gas /Cu. Ft.

Dry Hole 2535

Abandoned

Date

2/16 1920.

Pyle Scout