


Greenwood

Form 51-5M-2-29-34703

Map No **KANSAS** Sec. *27* Twp. *23* R. *13*

Well No. *37* *Pinon* Farm
Darby et al Company

NORTH

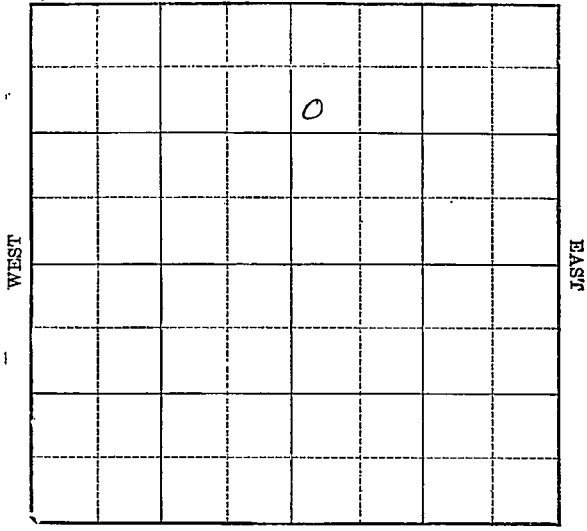

Location _____
Drilling Remarks _____

RECORD

Cased _____ in. _____ ft.
Sand _____
Gas _____
Oil _____
Total Depth _____

Rig Up _____
Drilling Remarks _____

PRODUCTION

1st 24 hrs. Nat. _____
1st 24 hrs. after shot _____
Gas _____ cu. ft. _____
Dry Hole _____
Abandoned _____

Greenwood

Map No. 1ks Sec. 27 Twp. 23 R. 13Well No. 3 PinonDarby et al Company

Contractor

FIRST REPORTS

ABANDONED

Ft. from N. Line

Ft. from S. Line

Ft. from E. Line

Ft. from W. Line

SECTION PLAT

		0	

Location

Rig up

Drilling and Remarks:

40/no record

RECORD

Cased _____ in., _____ ft.

Sand 1773-1806

Gas _____

Oil _____

Total Depth 1806

PRODUCTION

1st 24 hrs. Nat. _____

1st 24 hrs. after shot _____

Gas _____ Cu. Ft.

Dry Hole _____

Abandoned 1806

Date

7/22/21 192 Shenwood Scout