


Map No. _____ Sec. 10 Twp. 26 R. 4

Well No. 4 Orban Farm
Carter Company

NORTH

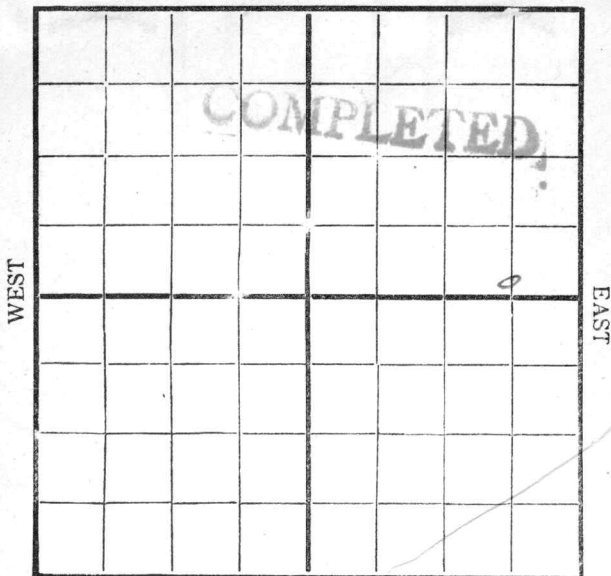

SOUTH

Location -----

Drilling Remarks:

Rig Up_____

Drilling Remarks:

RECORD

Cased_____ in_____Ft.

Sand -----

Gas -----

Oil -----

Total Depth_____

PRODUCTION

1st 24 hrs. Nat-----


1st 24 hrs. after shot-----

Gas_____Cu. Ft.

Dry Hole_____

Abandoned -----

Map No. _____ Sec. 10 Twp. 26 R. 4
 Well No. 4 Urban Farm _____
Easter Company _____
 NORTH

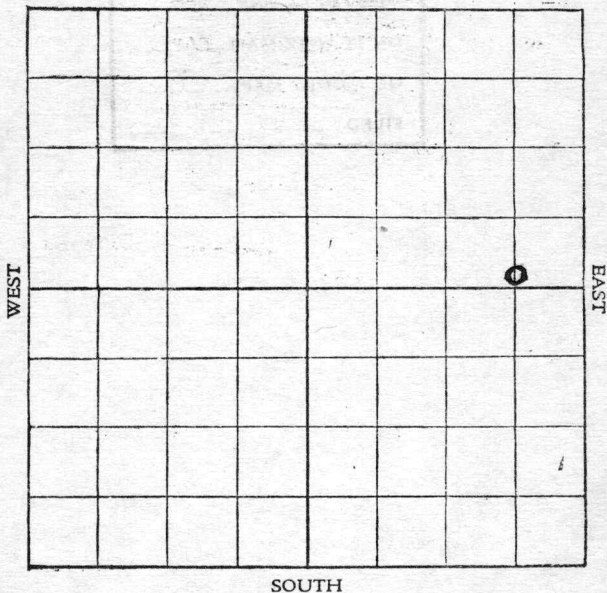

Location _____

Rig up _____

Drilling and remarks:

Rig up

RECORD

Cased _____ in. _____ Ft.

Sand _____

Gas _____

Oil _____

Total Depth _____

PRODUCTION

1st 24 hrs. Nat. _____

1st 24 hrs. after shot _____

Gas _____ Cu. Ft.

Dry Hole _____


Abandoned _____

Date

5/19, 1917, Brooker Scout

Map No. _____ Sec. 10 Twp. 26 R. 4Well No. 4 Orban FarmCarter Company

NORTH

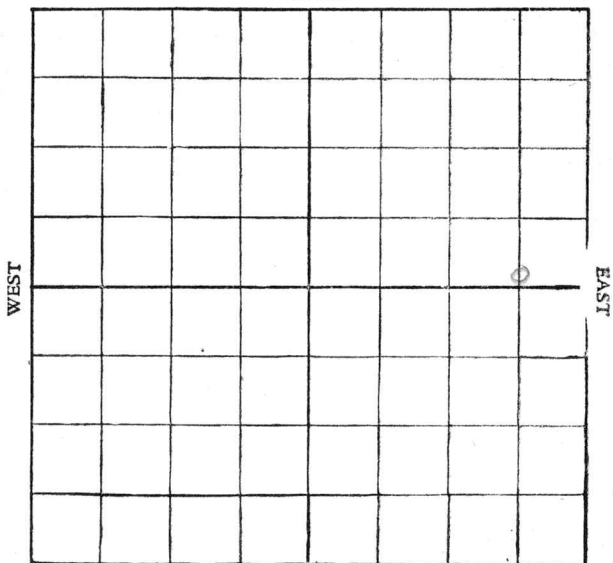

SOUTH

Location _____

Rig up _____

Drilling and remarks:

Rig up.

RECORD

Cased _____ in. _____ Ft.

Sand _____

Gas _____

Oil _____

Total Depth _____

PRODUCTION

1st 24 hrs. Nat. _____

1st 24 hrs. after shot _____

Gas _____ Cu. Ft.

Dry Hole _____


Abandoned _____

Date

5/26, 1917, Brocker Scout

Map No. _____ Sec. 10 Twp. 26 R. 4Well No. 4 Orban Farm_____ Carter Company

NORTH

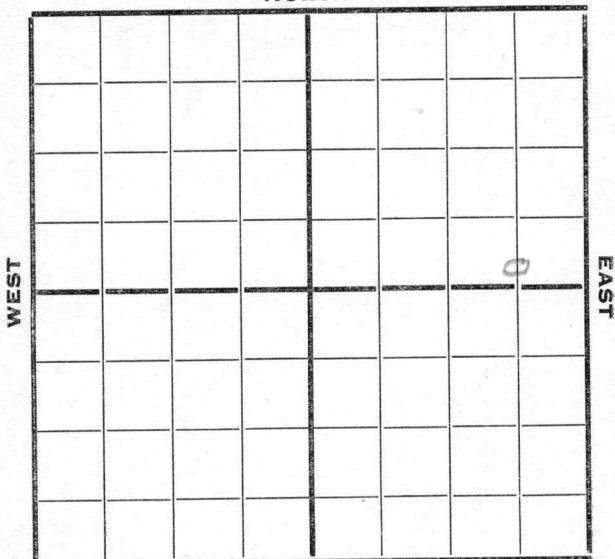

SOUTH

Location _____

Rig up _____

Drilling and Remarks:

Rig

RECORD

Cased _____ in. _____ Ft.

Sand _____

Gas _____

Oil _____

Total Depth _____

PRODUCTION

1st 24 hrs. Nat. _____

1st 24 hrs. after shot _____

Gas _____ Cu. Ft.

Dry Hole _____

Abandoned _____

Date

6/2, 1917, C. T. Crocker Scout

Map No. _____ Sec. 10 Twp. 26 R. 4


Well No. 4 Orban Farm

Carter Company

NORTH

WEST

EAST

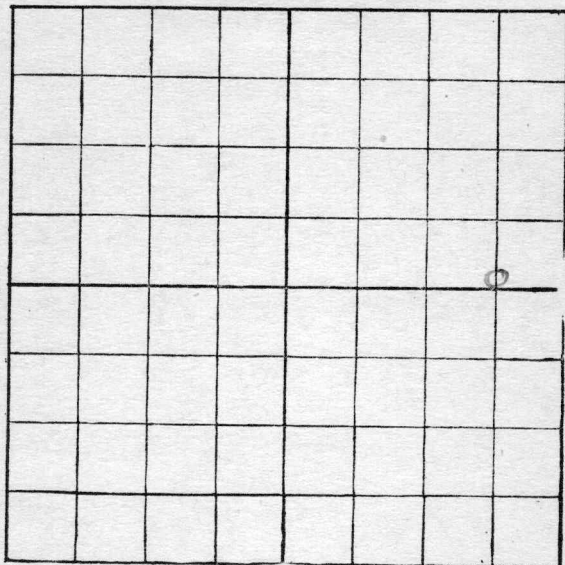

SOUTH

Location _____

Rig up _____

Drilling and remarks:

Rig.

RECORD

Cased _____ in. _____ Ft.

Sand _____

Gas _____

Oil _____

Total Depth _____

PRODUCTION

1st 24 hrs. Nat. _____

1st 24 hrs. after shot _____

Gas _____ Cu. Ft.

Dry Hole _____

Abandoned _____

Date


JUN 9 - 1917

G. T. Crocker

_____, 191_____, Scout

Map No. _____ Sec. 10 Twp. 26 R. 4Well No. 4 Urban Farm
Carter Company

NORTH

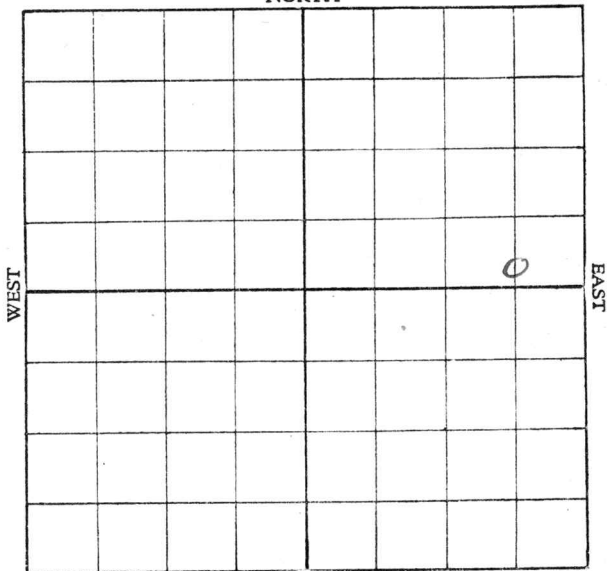

SOUTH

Location _____

Rig up _____

Drilling and remarks:

Rign up

RECORD

Cased _____ in. _____ Ft.

Sand _____

Gas _____

Oil _____

Total Depth _____

PRODUCTION

1st 24 hrs. Nat. _____

1st 24 hrs. after shot _____

Gas _____ Cu. Ft.

Dry Hole _____

Abandoned _____


Date

JUN 16 1917

, 191

E. J. Crocker
Scout

Map No. _____ Sec. 10 Twp. 26 R. 4
 Well No. 4 Orbays Farm _____
Cartier Company _____

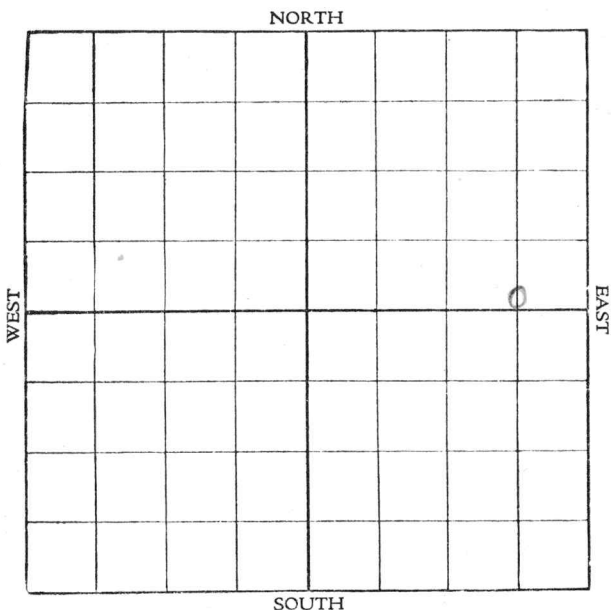

Location _____
 Rig up _____
 Drilling and remarks:

Rig up

RECORD

Cased _____ in. _____ Ft.
 Sand _____
 Gas _____
 Oil _____
 Total Depth _____

PRODUCTION

1st 24 hrs. Nat. _____
 1st 24 hrs. after shot _____
 Gas _____ Cu. Ft.
 Dry Hole _____
 Abandoned _____

Date


JUN 22 1917

, 191.

C. J. Crocker Scout

Map No. _____ Sec. 10 Twp. 26 R. 4
 Well No. H. Copan Farm _____
Carter Company _____

NORTH

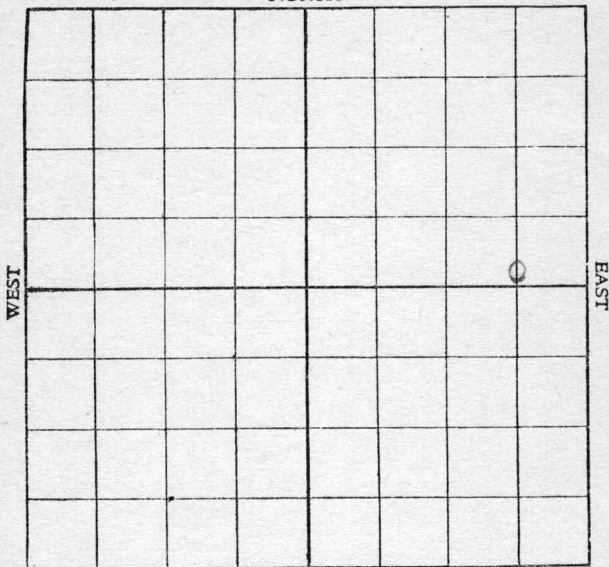

SOUTH

Location _____

Rig up _____

Drilling and remarks:

Rig

RECORD

Cased _____ in. _____ Ft.

Sand _____

Gas _____

Oil _____

Total Depth _____

PRODUCTION

1st 24 hrs. Nat. _____

1st 24 hrs. after shot _____

Gas _____ Cu. Ft.

Dry Hole _____

Abandoned _____

Date

JUN 22 1917

, 191


C. T. Crocker
 Scout

Map No. _____ Sec. 10 Twp. 26 R. 4

Well No. 4 Urban Farm _____

_____ Carter Company

NORTH

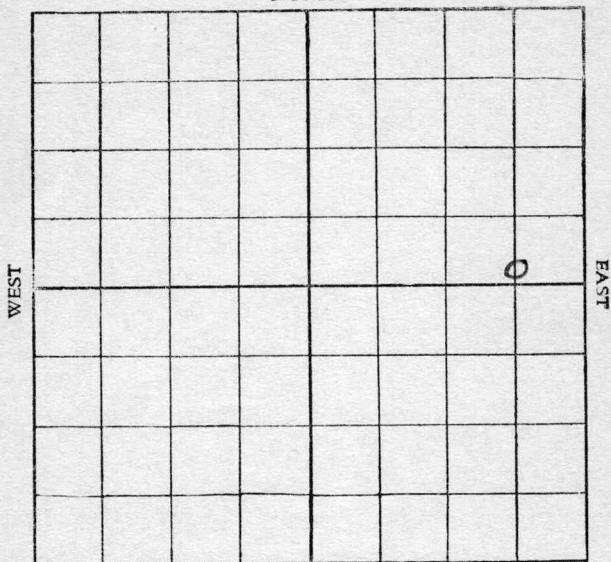

SOUTH

Location _____

Rig up _____

Drilling and remarks:

Spud.

RECORD

Cased _____ in. _____ Ft.

Sand _____

Gas _____

Oil _____

Total Depth _____

PRODUCTION

1st 24 hrs. Nat. _____

1st 24 hrs. after shot _____

Gas _____ Cu. Ft.

Dry Hole _____


Abandoned _____

Date JUN 30 1917

_____, 191____, *E. J. Crocker* Scout

Map No. _____ Sec. 10 Twp. 26 R. 4
 Well No. 4 Orban Farm
Carter Company

NORTH

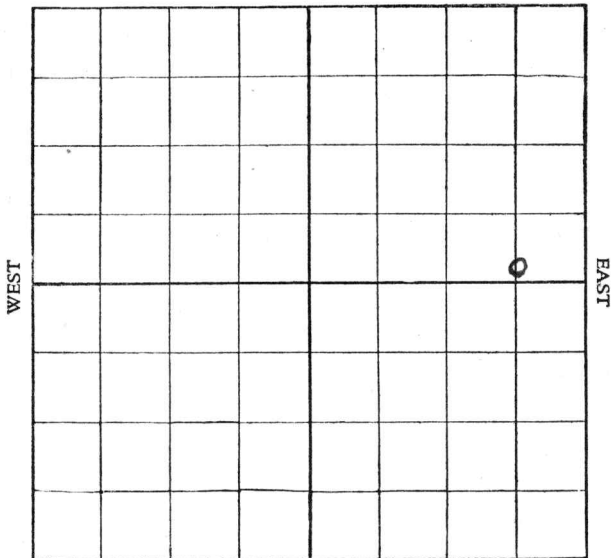

SOUTH

Location _____

Rig up _____

Drilling and remarks:

7/3 Rign

RECORD

Cased _____ in. _____ Ft.

Sand _____

Gas _____

Oil _____

Total Depth _____

PRODUCTION

1st 24 hrs. Nat. _____

1st 24 hrs. after shot _____

Gas _____ Cu. Ft.

Dry Hole _____


Abandoned _____

Date

JUL 7 1917

G. T. Crocker Scout

Map No. _____ Sec. 10 Twp. 26 R. 4
 Well No. 4 Orban Farm
Custer Company

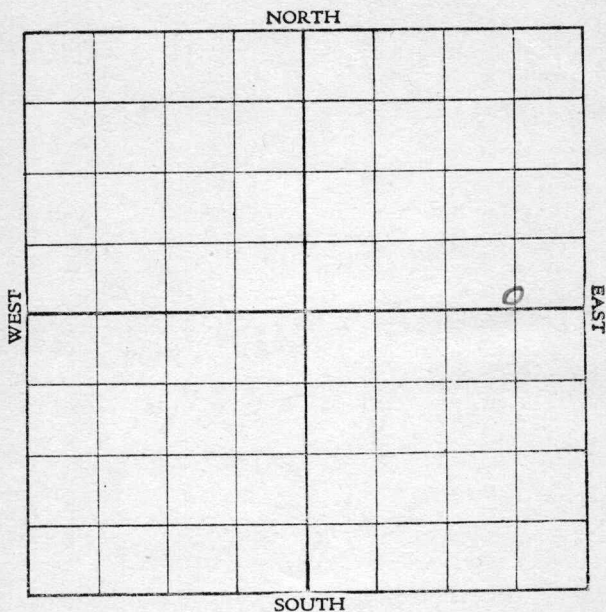

Location _____

Rig up _____

Drilling and remarks:

RECORD

Cased _____ in. _____ Ft.

Sand _____

Gas _____

Oil _____

Total Depth _____

PRODUCTION

1st 24 hrs. Nat. _____

1st 24 hrs. after shot _____

Gas _____ Cu. Ft.

Dry Hole _____

Abandoned _____

Rig up

Date


JUL 14 1917, 191 C. J. Crocker Scout

Map No. _____ Sec. 10 Twp. 26 R. 4

Well No. 4, Orban Farm _____
Carter Company _____

NORTH

WEST

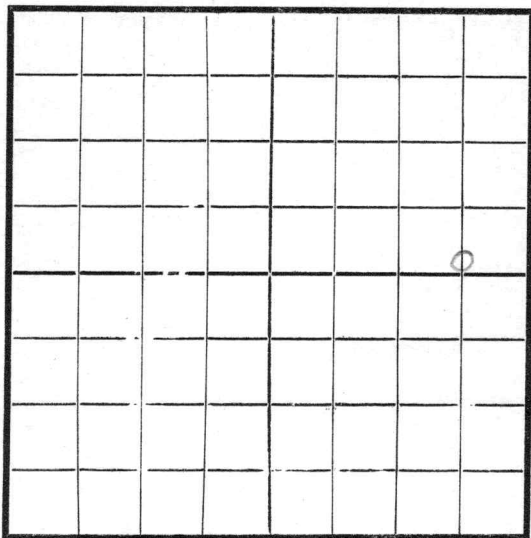

EAST

SOUTH

Location _____

Rig Up ☒ _____

Drilling and remarks _____

RECORD

Cased _____ in. _____ Ft.

Sand _____

Gas _____

Oil _____

Total Depth _____

PRODUCTION

1st 24 hrs. Nat. _____

1st 24 hrs. after shot _____

Gas _____ Cu. Ft.

Dry Hole _____

Abandoned _____


Date

8-24, 1917 Lantz Scout

Map No. _____ Sec. 10 Twp. 26 R. 4Well No. 4 Orban Farm _____

_____ Company

NORTH

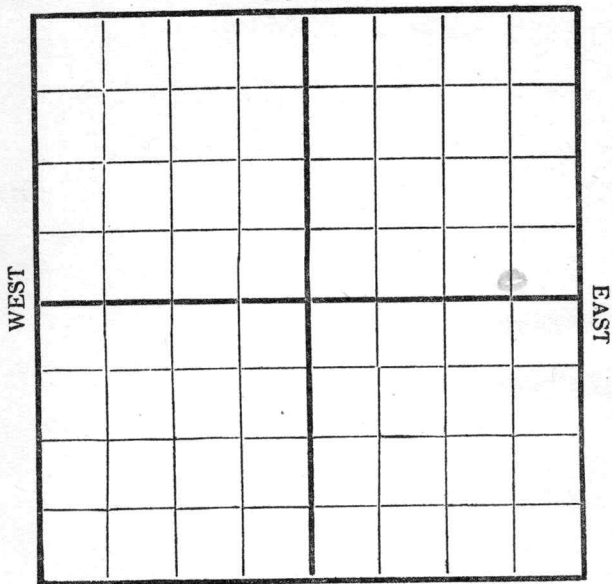

SOUTH

Location _____

Rig Up _____

Drilling and remarks

2045

RECORD

Cased _____ in. _____ Ft.

Sand _____

Gas _____

Oil _____

Total Depth _____

PRODUCTION

1st 24 hrs. Nat. _____

1st 24 hrs. after shot _____

Gas _____ Cu. Ft.

Dry Hole _____

Abandoned _____


Date

10/9, 1917, _____ Scout

Map No. _____ Sec. 10 Twp. 26 R. 4Well No. 4 Orban Farm _____Carter Company _____

NORTH

WEST

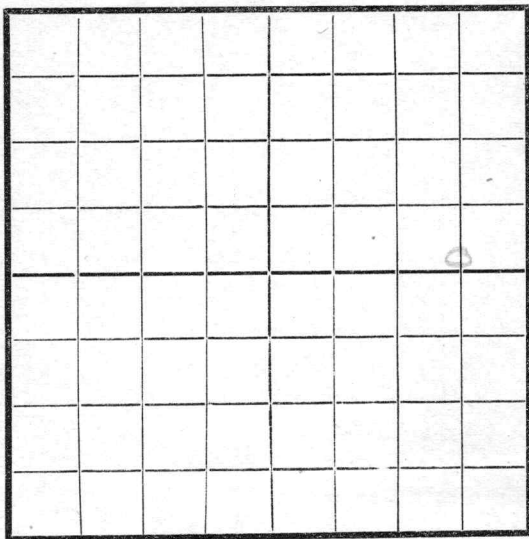

EAST

SOUTH

Location _____

Rig Up _____

Drilling and remarks

2250

RECORD

Cased _____ in. _____ Ft.

Sand _____

Gas _____

Oil _____

Total Depth _____

PRODUCTION

1st 24 hrs. Nat. _____

1st 24 hrs. after shot _____

Gas _____ Cu. Ft.

Dry Hole _____

Abandoned _____

Date


10/17, 1917 Carter Scout

Map No. _____ Sec. 10 Twp. 26 R. 4

Well No. 4 Orban Farm _____
Carter Company

NORTH

WEST

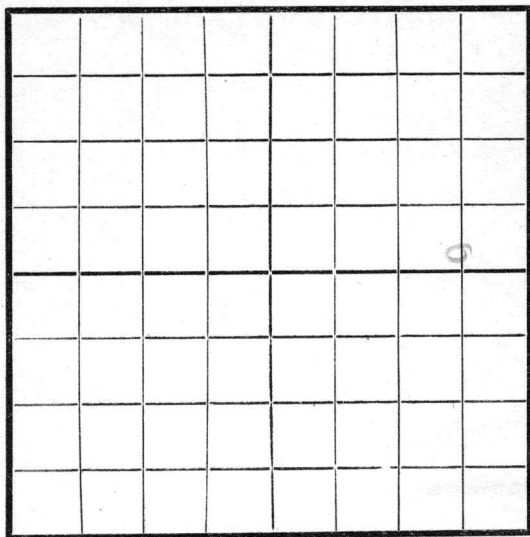

EAST

SOUTH

Location _____

Rig Up _____

Drilling and remarks

Top sand

2364

RECORD

Cased _____ in. _____ Ft.

Sand _____

Gas _____

Oil _____

Total Depth _____

PRODUCTION

1st 24 hrs. Nat. _____

1st 24 hrs. after shot _____

Gas _____ Cu. Ft.

Dry Hole _____

Abandoned _____


Date

10/24, 191 *7* *Carter* Scout

Map No. _____ Sec. 10 Twp. 26 R. 4Well No. 4 Orban Farm _____
Carter Company _____

NORTH

WEST

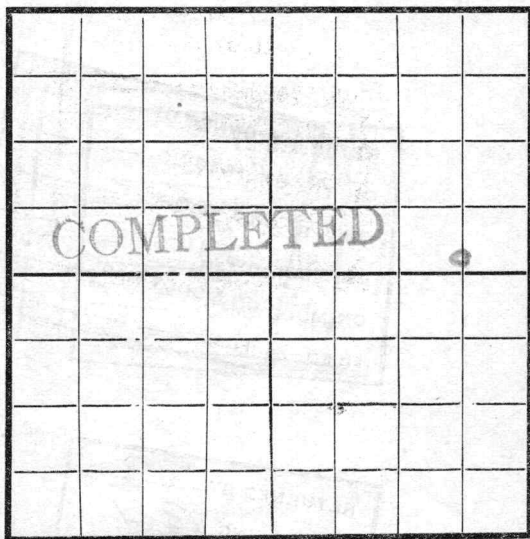

EAST

SOUTH

Location _____

Rig Up _____

Drilling and remarks

Estimated
at 75

Barrels

RECORD

Cased _____ in. _____ Ft.

Sand 2364-2450

Gas _____

Oil _____

Total Depth _____

PRODUCTION

1st 24 hrs. Nat. _____

1st 24 hrs. after shot _____

Gas _____ Cu. Ft.

Dry Hole _____

Abandoned _____

Date

10/31, 1917 Candiff Scout