


Map No. _____ Sec. 17 Twp. 23 R. 4
 Well No. 2 Lathrop Farm _____
Empire Company _____

NORTH

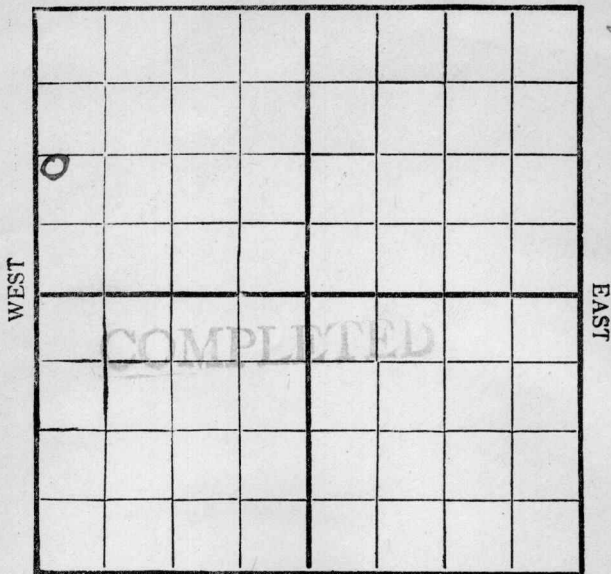

SOUTH

Location _____

Rig Up _____

Drilling Remarks:

Drilling Remarks:

RECORD

PRODUCTION

Cased _____ in. _____ ft.

1st 24 hrs. Nat. _____

Sand _____

1st 24 hrs. after shot _____

Gas _____

Gas _____ cu. ft.

Oil _____

Dry Hole _____

Total Depth _____

Abandoned _____

Map No. _____ Sec. 17 Twp. 23 R. 4

Well No. 2 Lathrop Fa. _____

Empire Gas Co Company _____

Contractor _____


MW. Quarter

_____ Ft. from N. Line

1120 Ft. from S. Line

_____ Ft. from E. Line

200 Ft. from W. Line

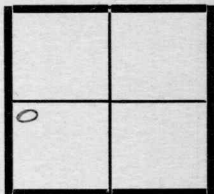

Date

REPORT

10/19
10/11 Drily 2375'
10/21 2375-2413' Swabbing 32 Bhp. per
10/31 2375-2413' 768 Bhp. 100
 24 Lb.

COMPLETED


Map No. K14 Sec. 17 Twp. 23 R. 4Well No. 2 LathropEmpire Company

Contractor

NORTH

WEST

EAST

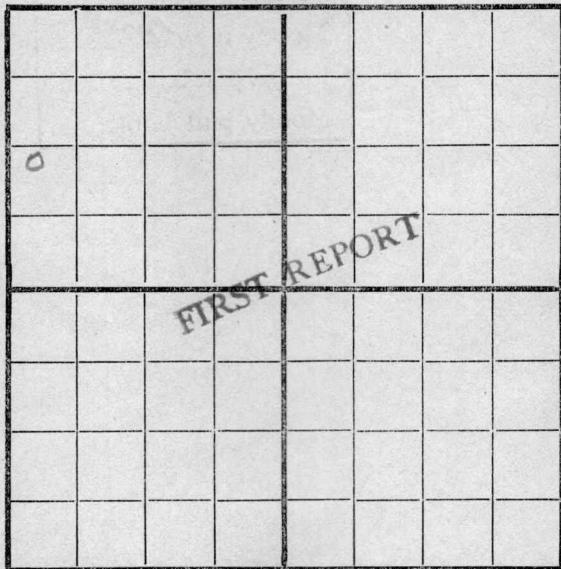

200 W

SOUTH

1120 S

Location _____

Rig up _____

Drilling and Remarks:

Timbers

RECORD

Cased _____ in., _____ ft.

Sand _____

Gas _____

Oil _____

Total Depth _____

PRODUCTION

1st 24 hrs. Nat. _____

1st 24 hrs. after shot _____

Gas _____ Cu. Ft.

Dry Hole _____


Abandoned _____

Date

7/1 1919 Cy u Scout

Map No. 1514 Sec. 17 Twp. 23 R. 4
 Well No. 2 Lathrop
Empire Company
 Contractor

NORTH

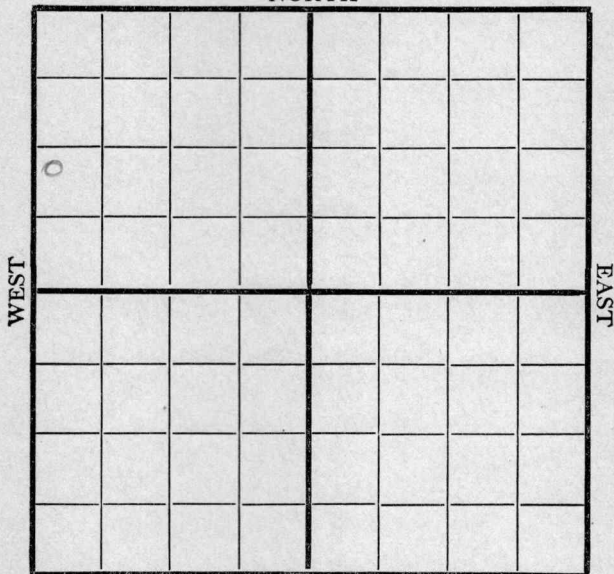

200 W

SOUTH

1120 S

Location _____
 Rig up _____
 Drilling and Remarks:

Timbers

RECORD

Cased _____ in., _____ ft.
 Sand _____
 Gas _____
 Oil _____
 Total Depth _____

PRODUCTION

1st 24 hrs. Nat. _____
 1st 24 hrs. after shot _____
 Gas _____ Cu. Ft.
 Dry Hole _____
 Abandoned _____


Date

7/12 1919 Pyle Scout

Map No. K14 Sec. 17 Twp. 23 R. 4Well No. 2 LathropEmpire Company

Contractor

NORTH

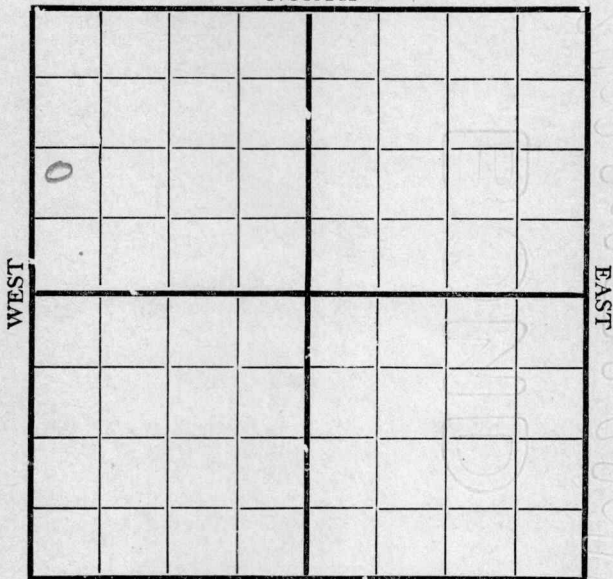

200 W SOUTH 1120 S

Location _____

Rig up. ☒ _____

Drilling and Remarks:

RECORD

Cased _____ in., _____ ft.

Sand _____

Gas _____

Oil _____

Total Depth _____

PRODUCTION

1st 24 hrs. Nat. _____

1st 24 hrs. after shot _____

Gas _____ Cu. Ft.


Dry Hole _____

Abandoned _____

Date

7/16 1919 Pyle Scout

Map No. K 14 Sec. 17 Twp. 23 R. 4
 Well No. 2 Lathrop
Empire Company
 Contractor

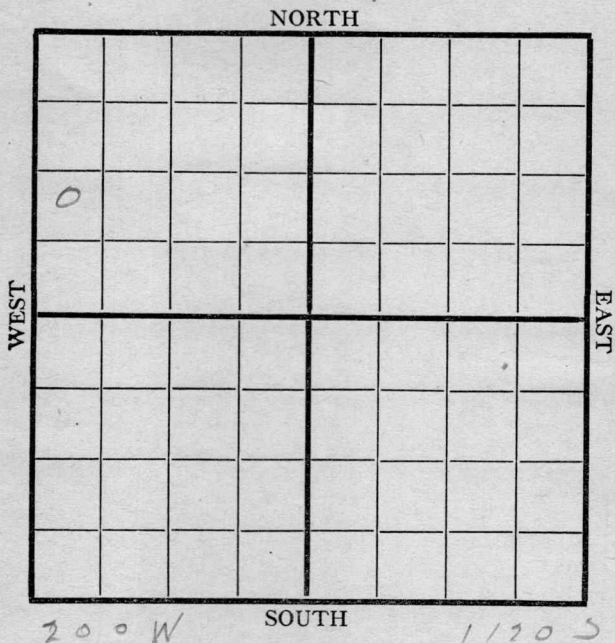

Location _____
 Rig up ☒ _____
 Drilling and Remarks:

RECORD

Cased _____ in., _____ ft.
 Sand _____
 Gas _____
 Oil _____
 Total Depth _____


PRODUCTION

1st 24 hrs. Nat. _____
 1st 24 hrs. after shot _____
 Gas _____ Cu. Ft.
 Dry Hole _____
 Abandoned _____

Date

7/25 1919 Coy Scout

Map No. K 14 Sec. 17 Twp. 23 R. 4
 Well No. 2 Lathrop
Empire Company
 Contractor

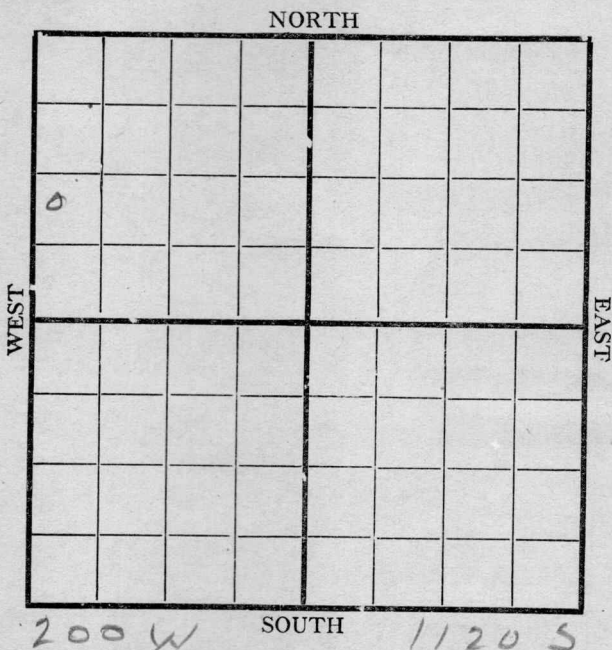

Location _____
 Rig up ☒
 Drilling and Remarks:

RECORD

Cased _____ in., _____ ft.
 Sand _____
 Gas _____
 Oil _____
 Total Depth _____

PRODUCTION

1st 24 hrs. Nat. _____
 1st 24 hrs. after shot _____
 Gas _____ Cu. Ft.
 Dry Hole _____
 Abandoned _____


Date 7/29 1919 Pyle Scout

Map No. K14 Sec. 17 Twp. 23 R. 4
 Well No. 2 Lathrop Farm
Empire Company

NORTH

WEST

EAST

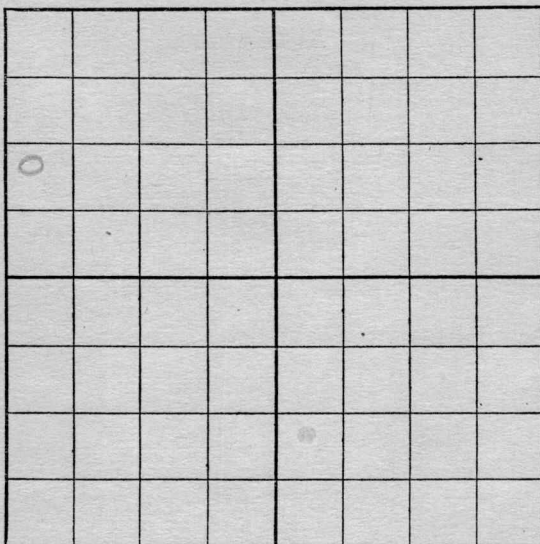

200 yd

SOUTH

11203

Location

Rig up

Drilling and Remarks:

*Pign
up*

RECORD

Cased in. Ft.

Sand

Gas

Oil

Total Depth

PRODUCTION

1st 24 hrs. Nat.

1st 24 hrs. after shot

Gas Cu. Ft.


Dry Hole

Abandoned

Date

8/5, 1919, Pyle Scout

Map No. K 14 Sec. 17 Twp. 23 R. 4
Well No. 2 Lathrop
Empire Company
Contractor

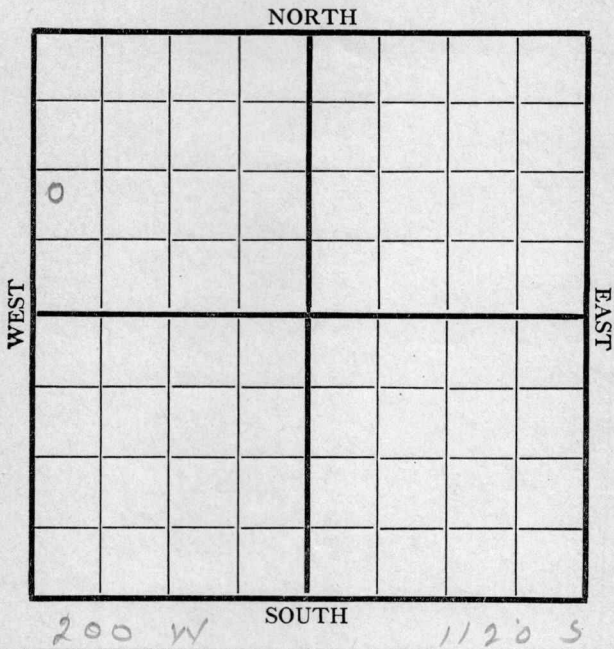


Location _____ Rig up _____ Drilling and Remarks: <i>Rig in up</i>	RECORD Cased _____ in., _____ ft. Sand _____ Gas _____ Oil _____ Total Depth _____ PRODUCTION 1st 24 hrs. Nat. _____ 1st 24 hrs. after shot _____ Gas _____ Cu. Ft. Dry Hole _____ Abandoned _____
--	--

Sec. 17 Twp. 23 Rge. 4
Owner Empire
Farm Lathrop Well No. 2
Contractor .

Feet from lines, N. _____ E. _____ S. 1120 W. 200
NORTH

Casing used _____
15½ _____ ft.
12½ _____ ft.
10 _____ ft.
8¼ _____ ft.
6⅝ _____ ft.
5 3-16 _____ ft.

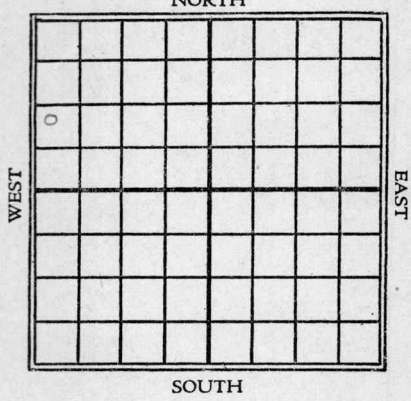

Location _____
Rig _____
Drilling at 250' ft. Fishing at _____ ft.
Total Depth _____ Completed _____
1st 24 Hrs. Nat. _____ Producing _____
1st 24 Hrs. Shot _____ Dry Hole _____
Gas _____ Cu. ft. Abandoned _____
Sands — give name and depth. Top _____ Bottom _____

Date of Report 8/23
Reported by Pyle

Map No. K 14 Sec. 17 Twp. 23 R. 4Well No. 2 LathropEmpire Company

Contractor

SECTION PLAT

⊙			

Ft. from N. Line

1120 Ft. from S. Line

Ft. from E. Line

200 Ft. from W. Line

Location

Rig up

Drilling and Remarks:

*fishing
tools @
820'*

RECORD

Cased _____ in., _____ ft.

Sand _____

Gas _____

Oil _____

Total Depth _____

PRODUCTION

1st 24 hrs. Nat. _____

1st 24 hrs. after shot _____

Gas _____ Cu. Ft.

Dry Hole _____

Abandoned _____

Date

8/30 1919

Pyle

Scout

Map No. K14 Sec. 17 Twp. 23 R. 4Well No. 2 LathropEmpire Company

Contractor

SECTION PLAT

Ft. from N. Line

1120 Ft. from S. Line

Ft. from E. Line

200 Ft. from W. Line

0			

Location -----

Rig up -----

Drilling and Remarks:

RECORD

Cased ----- in., ----- ft.

Sand -----

Gas -----

Oil -----

Total Depth -----

PRODUCTION

1st 24 hrs. Nat. -----

1st 24 hrs. after shot -----

Gas ----- Cu. Ft.

Dry Hole -----

Abandoned -----

Date

9/2 191 9

Pyle

Scout

Map No. K 14 Sec. 17 Twp. 23 R. 4
Well No. 2 Lathrop
Empire Company
Contractor

SECTION PLAT

_____Ft. from N. Line
1120 Ft. from S. Line
_____Ft. from E. Line
200 Ft. from W. Line

0			

Location _____
Rig up _____
Drilling and Remarks:
fish bit
@
1425

RECORD

Cased _____ in., _____ ft.
Sand _____
Gas _____
Oil _____
Total Depth _____

PRODUCTION

1st 24 hrs. Nat. _____
1st 24 hrs. after shot _____
Gas _____ Cu. Ft.
Dry Hole _____
Abandoned _____

Date 9/9 1919 Pyle Scout

Map No. K14 Sec. 17 Twp. 23 R. 4Well No. 2 LathropEmpire Company

Contractor

SECTION PLAT

0			

Ft. from N. Line

1120 Ft. from S. Line

Ft. from E. Line

200 Ft. from W. Line

RECORD

Location

Cased _____ in., _____ ft.

Rig up

Sand _____

Drilling and Remarks:

Gas _____

Oil _____

Total Depth _____

PRODUCTION

1st 24 hrs. Nat. _____

1st 24 hrs. after shot _____

Gas _____ Cu. Ft.

Dry Hole _____

Abandoned _____

Date

9/15 1919Pyle Scout

Map No. K 14 Sec. 17 Twp. 23 R. 4Well No. 2 LethropEmpire Company

Contractor

SECTION PLAT

Ft. from N. Line

1120 Ft. from S. Line

Ft. from E. Line

200 Ft. from W. Line

0			

Location

Rig up

Drilling and Remarks:

RECORD

Cased _____ in., _____ ft.

Sand _____

Gas _____

Oil _____

Total Depth _____

PRODUCTION

1st 24 hrs. Nat. _____

1st 24 hrs. after shot _____

Gas _____ Cu. Ft.

Dry Hole _____

Abandoned _____

Date

9/23 1919

Pyle

Scout

Map No. K14 Sec. 17 Twp. 23 R. 4Well No. 2 LathropEmpire Company

Contractor

SECTION PLAT

Ft. from N. Line

1120 Ft. from S. Line

Ft. from E. Line

200 Ft. from W. Line

0			

Location

Rig up

Drilling and Remarks:

RECORD

Cased _____ in., _____ ft.

Sand _____

Gas _____

Oil _____

Total Depth _____

PRODUCTION

1st 24 hrs. Nat. _____

1st 24 hrs. after shot _____

Gas _____ Cu. Ft.

Dry Hole _____

Abandoned _____

Date

9/30 1914

Scout

Pyle

Map No. K14 Sec. 17 Twp. 23 R. 4
Well No. 2 Lathrop
Empire Company
Contractor

SECTION PLAT

0			

-----Ft. from N. Line
1120 Ft. from S. Line
-----Ft. from E. Line
200 Ft. from W. Line

Location -----
Rig up -----
Drilling and Remarks:
Top 2375 S. & W.
8 ft in still
drilling. Hole
full oil

RECORD

Cased ----- in., ----- ft.
Sand -----
Gas -----
Oil -----
Total Depth -----

PRODUCTION

1st 24 hrs. Nat. -----
1st 24 hrs. after shot -----
Gas ----- Cu. Ft.
Dry Hole -----
Abandoned -----

Date

10/14 1919

Pyle

Scout

Map No. 514 Sec. 17 Twp. 23 R. 4Well No. 2 LathropEmpire Company

Contractor

SECTION PLAT

----- Ft. from N. Line

1120 ----- Ft. from S. Line

----- Ft. from E. Line

200 ----- Ft. from W. Line

0			

RECORD

Location -----

Rig up -----

Drilling and Remarks:

Cased ----- in., ----- ft.

Sand 2375 - 2413

Gas -----

Oil -----

Total Depth -----

PRODUCTION

1st 24 hrs. Nat. -----

1st 24 hrs. after shot -----

Gas ----- Cu. Ft.

Dry Hole -----

Abandoned -----

Date

10/21 1919

Pyle

Scout

Map No. _____ Sec. 17 Twp. 23 R. 4Well No. 2 LathropEmpire _____ Company

_____ Contractor

SECTION PLAT

_____ Ft. from N. Line

1120 Ft. from S. Line

_____ Ft. from E. Line

200 Ft. from W. Line

0			

COMPLETED

Location _____

Rig up _____

Drilling and Remarks:

RECORD

Cased _____ in., _____ ft.

Sand 2375 - 2413

Gas _____

Oil _____

Total Depth _____

PRODUCTION

1st 24 hrs. Nat. 768 bbls

1st 24 hrs. after shot _____

Gas _____ Cu. Ft.

Dry Hole _____

Abandoned _____

Date

10/311919

Pyle

Scout