


*Kansas*Map No. _____ Sec. 27 Twp. 23 R. 13Well No. 14 *Schindler* Farm _____*Mission Oil* Company _____

NORTH

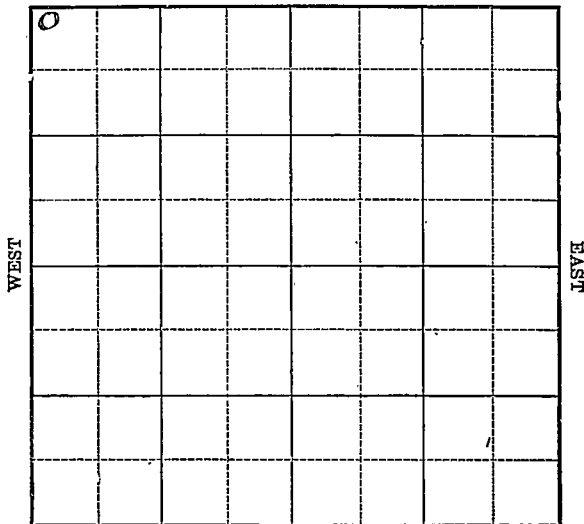

SOUTH

Location _____

Drilling Remarks:

Rig Up _____

Drilling Remarks:

RECORD

Cased _____ in. _____ ft.

Sand _____

Gas _____

Oil _____

Total Depth _____

PRODUCTION

1st 24 hrs. Nat. _____

1st 24 hrs. after shot _____

Gas _____ cu. ft.

Dry Hole _____

Abandoned _____


Map No. _____ Sec. 27 Twp. 23 R. 13Well No. #4 Schindler Farm
Mission Oil Company200 Ft. from N. Line

_____ Ft. from S. Line

_____ Ft. from E. Line

200 Ft. from W. Line

NORTH

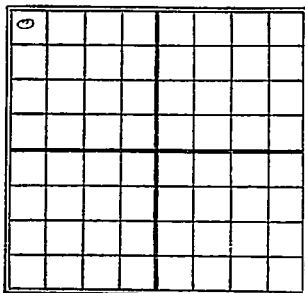

SOUTH

Date
1922

REPORT

5/21800' Dlg7/5top Line 1728 @ 1750'TD 1753 Shot 80 gts20 Bbls

Map No. 17 Sec. 21 Twp. 23 R. 13
 Well No. 4 Shinkler
Mission oil Company
 Contractor

FIRST REPORT

SECTION PLAT

200 Ft. from N. Line
 _____ Ft. from S. Line
 _____ Ft. from E. Line
200 Ft. from W. Line

○			

Location _____
 Rig up _____
 Drilling and Remarks:

Soakley

RECORD

Cased _____ in., _____ ft.
 Sand _____
 Gas _____
 Oil _____
 Total Depth _____

PRODUCTION

1st 24 hrs. Nat. _____
 1st 24 hrs. after shot _____
 Gas _____ Cu. Ft.
 Dry Hole _____
 Abandoned _____

Date
 MAY 21 1924

M. A. BENEAT

Map No. 17 27 Sec. 23 Twp. 13 R. 13Well No. 4 schindlerMason Company(as set) Contractor

COMPLETED

SECTION PLAT

0			
SPECIAL			

200 Ft. from N. Line

_____ Ft. from S. Line

_____ Ft. from E. Line

200 Ft. from W. Line

Location _____

Rig up _____

Drilling and Remarks:

Tephire 17287.0, 1750'7.0, 1753shot 80 ft20 ft

RECORD

Cased _____ in., _____ ft.

Sand _____

Gas _____

Oil _____

Total Depth _____

PRODUCTION

1st 24 hrs. Nat. _____

1st 24 hrs. after shot _____

Gas _____ Cu. Ft.

Dry Hole _____

Abandoned _____

Date

JUL 15 1922

M. A. BENEAR

Scout