
Form 51—5-19—5M—Mid-West

Map No. K14 Sec. 17 Twp. T 3 R. 4

Well No. 1 Lathrop Farm

Ramsey Pet Company

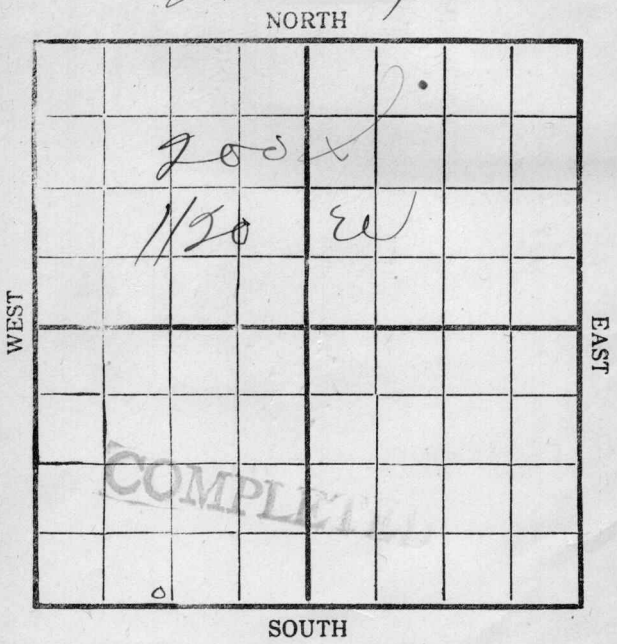

Location _____

Drilling Remarks:

Rig Up _____

Drilling Remarks:

RECORD

Cased _____ in. _____ ft.

Sand _____

Gas _____

Oil _____

Total Depth

PRODUCTION

1st 24 hrs. Nat. _____

1st 24 hrs. after shot _____

Gas _____ cu. ft.

Dry Hole

Form 252A 2M-9-19-CroMac.

Map No. _____ Sec. 17 Twp. 73 R. 4

Well No. 1 Luthrop Farm

Ramsey Pet. Co Company

_____ Contractor


Sw. Quarter

_____ Ft. from N. Lice

700 Ft. from S. Line

_____ Ft. from E. Line

1170 Ft. from W. Line

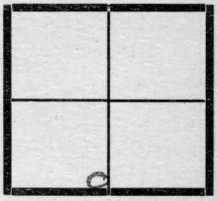

Date	REPORT
10/11	Drlg. 2040'
10/21	S.D. 2040'
10/31	Top Sand 2363'
11/4	Sand 2363 - 2395
	Swabbing 90 Bbl hr.
11/17	Sand 2363 - 95 - 1200 Bbl

COMPLETED

Form 26—1M—4-19—Mid-West


Map No. K 14 Sec. 17 Twp. 23 R. 4

Well No. 1 Lathrop

Ramsey Oil Company

Contractor

SECTION PLAT

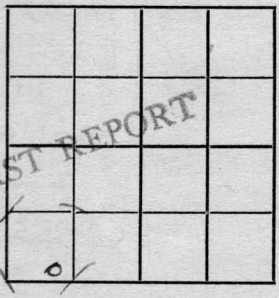

Ft. from N. Line

200 Ft. from S. Line

Ft. from E. Line

1120 Ft. from W. Line

Location

Rig up

Drilling and Remarks:

RECORD

Cased in., ft.

Sand

Gas

Oil

Total Depth

PRODUCTION

1st 24 hrs. Nat.

1st 24 hrs. after shot

Gas Cu. Ft.

Dry Hole

Abandoned

Date

9/8 1919.

Pyle Scout

Form 26—1M—4-19—Mid-West


Map No. K 14 Sec. 17 Twp. 23 R. 4

Well No. 1 Lathrop

Ramsey Oil Company

Contractor

SECTION PLAT

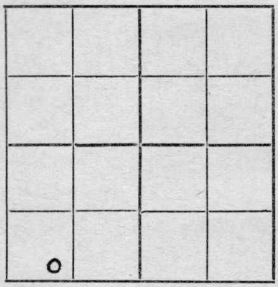

_____ Ft. from N. Line

200 Ft. from S. Line

_____ Ft. from E. Line

1120 Ft. from W. Line

Location _____

Rig up _____

Drilling and Remarks:

Rig is up

RECORD

Cased _____ in., _____ ft.

Sand _____

Gas _____

Oil _____

Total Depth _____

PRODUCTION

1st 24 hrs. Nat. _____

1st 24 hrs. after shot _____

Gas _____ Cu. Ft.

Dry Hole _____

Abandoned _____

Date

9/15/1919

Pyle Scout

Form 26—1M—4-19—Mid-West


Map No. K 14 Sec. 17 Twp. 23 R. 4

Well No. 1 Zathop

Ramsey Pet Company

Contractor

SECTION PLAT

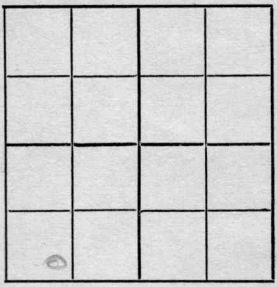

Ft. from N. Line

900 Ft. from S. Line

Ft. from E. Line

1120 Ft. from W. Line

Location

Rig up

Drilling and Remarks:

500'

RECORD

Cased in., ft.

Sand

Gas

Oil

Total Depth

PRODUCTION

1st 24 hrs. Nat.

1st 24 hrs. after shot

Gas Cu. Ft.

Dry Hole

Abandoned

Date

4/23/191 9.

Pyle Scout

Form 26—1M—4-19—Mid-West


Map No. K14 Sec. 17 Twp. 23 R. 4

Well No. 1 Lathrop

Ramsey Oil Company

Contractor

SECTION PLAT

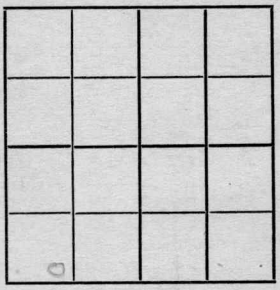

Ft. from N. Line

200 Ft. from S. Line

Ft. from E. Line

1120 Ft. from W. Line

Location

Rig up

Drilling and Remarks:

1050'

RECORD

Cased in., ft.

Sand

Gas

Oil

Total Depth

PRODUCTION

1st 24 hrs. Nat.

1st 24 hrs. after shot

Gas Cu. Ft.

Dry Hole

Abandoned

Date

9/30/1919

Pyle

Scout

Form 26—1M—4-19—Mid-West


Map No. K14 Sec. 17 Twp. 23 R. 4

Well No. 1 Lathrop

Ramsey Oil Company

Contractor

SECTION PLAT

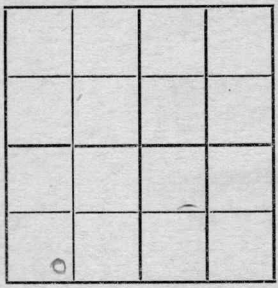

Ft. from N. Line

200 Ft. from S. Line

Ft. from E. Line

1120 Ft. from W. Line

Location

Rig up

Drilling and Remarks:

2040 Dry.

RECORD

Cased in., ft.

Sand

Gas

Oil

Total Depth

PRODUCTION

1st 24 hrs. Nat.

1st 24 hrs. after shot

Gas Cu. Ft.

Dry Hole

Abandoned

Date

10/14 1919

Pyle Scout

Form 26—1M—4-19—Mid-West


Map No. K14 Sec. 17 Twp. 23 R. 4

Well No. 1 Lathrop

Ramsey Pet Company

Contractor

SECTION PLAT

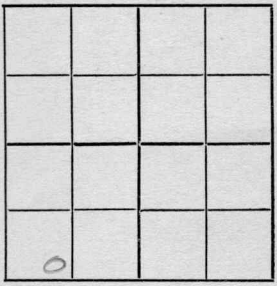

Ft. from N. Line

200 Ft. from S. Line

Ft. from E. Line

1120 Ft. from W. Line

Location

Rig up

Drilling and Remarks:

2040
D.D.

RECORD

Cased in., ft.

Sand

Gas

Oil

Total Depth

PRODUCTION

1st 24 hrs. Nat.

1st 24 hrs. after shot

Gas Cu. Ft.

Dry Hole

Abandoned

Date

10/21/19

Pyle Scout

Form 26—1M—4-19—Mid-West

Map No. 1514 Sec. 17 Twp. 23 R. 4

Well No. 1 Lathrop

Ramsey Pet Company

Contractor

SECTION PLAT



Ft. from N. Line

200 Ft. from S. Line

Ft. from E. Line

1120 Ft. from W. Line

Location

Rig up

Drilling and Remarks:

RECORD

Cased in., ft.

Sand 2363 - 2395

Gas

Oil

Total Depth

PRODUCTION

1st 24 hrs. Nat. 1200 bbls

1st 24 hrs. after shot

Gas Cu. Ft.

Dry Hole

Abandoned

Date

11/12 1919

Pyle Scout