


Section 10 Township 26 Range 4-E

Well No. #4 Ordan

Company B & R Drlg  
Miscellaneous

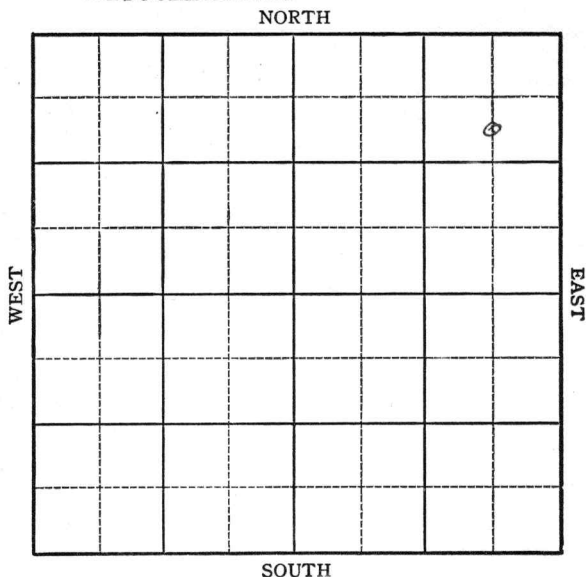

Butler

KANSAS

Sec. 10 Twp. 26 R. 4E

Well No. #4 Ordan Farm \_\_\_\_\_  
B & R Drlg. \_\_\_\_\_ Company \_\_\_\_\_

Miscellaneous (B&R Drlg.. Cont'd)


990' Ft. from N. Line

\_\_\_\_\_ Ft. from S. Line

660' Ft. from E. Line

\_\_\_\_\_ Ft. from W. Line

C S L NE NE

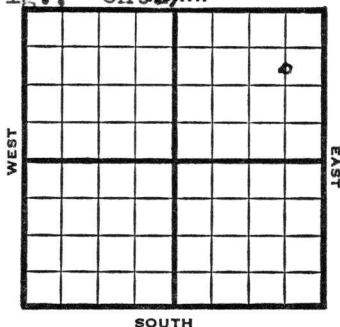

1949 Elev. 1357' REPORT

11/16 8" @ 83'  
Drlg. 2125'  
11/23 Arbuckle 2375  
TD 2378'  
5" @ 2375'  
11/29 "  
12/7 "  
12/14 Arb 2375'  
7" @ 2375'  
Pump 35 oil Pot.  
Gr. 38°  
TD 2393'

COMPLETED

Map No. \_\_\_\_\_ Sec. 10 Twp. 26 R. 4E

Well No. 4 Ordan

B & R Drlg. \_\_\_\_\_ Company \_\_\_\_\_

B & R Drlg. \_\_\_\_\_ Contractor \_\_\_\_\_

C S L NE NE


**FIRST REPORT  
SECTION PLAT**

990 Ft. from N. Line

\_\_\_\_\_ Ft. from S. Line

660 Ft. from E. Line

\_\_\_\_\_ Ft. from W. Line

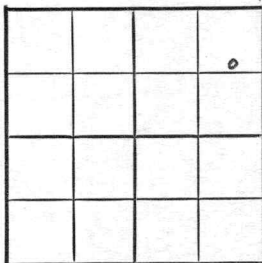

Butler County

Location \_\_\_\_\_

Rig up \_\_\_\_\_

Drilling and Remarks: \_\_\_\_\_

8" @ 83

drlg. 2125

**RECORD**

Cased \_\_\_\_\_ in., \_\_\_\_\_ ft.

Sand \_\_\_\_\_

Gas \_\_\_\_\_

Oil \_\_\_\_\_

Total Depth \_\_\_\_\_

**PRODUCTION**

1st 24 hrs. Nat. \_\_\_\_\_

1st 24 hrs. after shot \_\_\_\_\_

Gas \_\_\_\_\_ Cu. Ft.

Dry Hole \_\_\_\_\_

Abandoned \_\_\_\_\_

Date

NOV 16 1949 19

S. J. LEWIS Scout

Map No. \_\_\_\_\_ Sec. 10 Twp. 26 R. 4E

Well No. 4 Ordan

B & R Drlg. Company

COMPLETE

Contractor

C S L NE NE.


*F 1357*  
SECTION PLAT

990 Ft. from N. Line

\_\_\_\_\_ Ft. from S. Line

660 Ft. from E. Line

\_\_\_\_\_ Ft. from W. Line

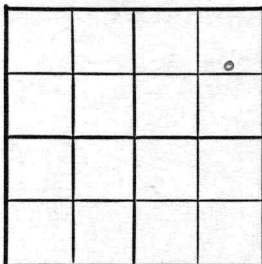

Butler County

Location \_\_\_\_\_

Rig up \_\_\_\_\_

Drilling and Remarks:

*Core 2375*

*7" C 2375*

*Pump 35 oil Rd*

*38° S*

RECORD

Cased \_\_\_\_\_ in., \_\_\_\_\_ ft.

Sand \_\_\_\_\_

Gas \_\_\_\_\_

Oil \_\_\_\_\_

Total Depth 2583

PRODUCTION

1st 24 hrs. Nat. \_\_\_\_\_

1st 24 hrs. after shot \_\_\_\_\_

Gas \_\_\_\_\_ Cu. Ft.

Dry Hole \_\_\_\_\_

Abandoned \_\_\_\_\_

Date

DEC 14 1949

19

S. J. LEWIS

Scout