
FORM 51 25M 8-50 WESTERN Butler KANSAS

Section 10 Township 26 Range 4E

Well No. #6 Orbon

Company B & R Drlg.

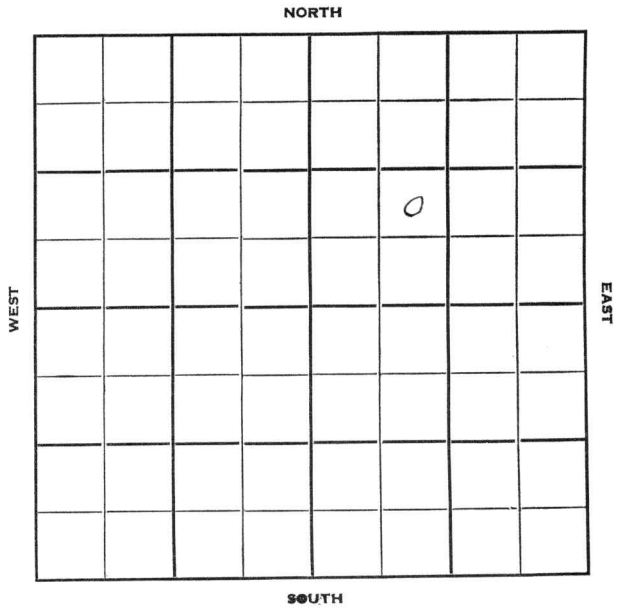

FORM 252-B
10M 11-50 PETROL

Butler KANSAS

Sec. 10 Twp. 26 R. 4E

Well No. #6 Orban Farm

B & R Drlg. Company

B & R Drlg. - Contr. Contractor

El Dorado Pool


Ft. from N. Line

750' Ft. from S. Line

Ft. from E. Line

990' Ft. from W. Line

NE SW NE

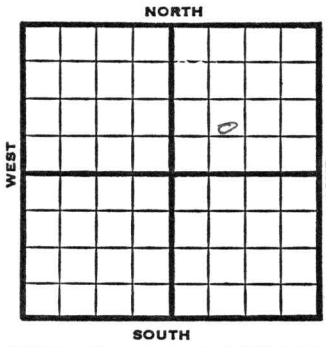

1950	Elev 1332' REPORT
12/20	Spud 12-12-50 8" @ 80' Drlg. 2240'
1951 1/10	Spud 12-12-50 8" @ 80 Arb 2385-89 5" @ 2387 TD 2389 15 goph 250A 30 goph 500 A Comp 25 bopd Completed

COMPLETED

FORM 275 FOR SALE BY KANSAS BLUE PRINT CO.


County Butler State Kansas

Sec. 10 (Blk. Twp.) 26 (Sur. Rge.) 4E Map No.

Operator B & R Drlg.

Well No. 6 Farm Orban

Elev. Location NE SW NE

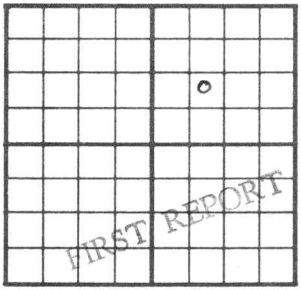

750 Ft. From S Line NE

990 Ft. From W Line Quarter

1st. Report DEC 20 1950

Completion

Remarks

B & R Drlg. - Contr.

Spudding Date 12-12-50

Drlg. Data ElDorado Pool

8" @ 80 drlg. 2240

J. E. TYRA

FORM 275 FOR SALE BY KANSAS BLUE PRINT CO.


County Butler State Kansas

Sec. 10 (Blk. Twp.) 26 (Sur. Rge.) 4E Map No.

Operator B & R Drlg.

Well No. 6 Farm Orban

Elev. 1332 Location NE SW NE

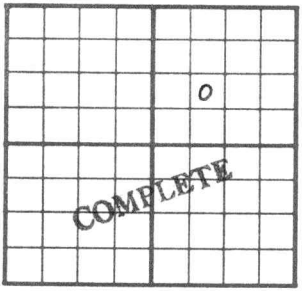

750 Ft. From S Line NE

990 Ft. From W Line Quarter

1st. Report

Completion JAN 1 0 1951

Remarks ElDorado Pool
B & R Drlg. - Contr.

Spudding Date 12-12-50

Drlg. Data Oil well TD 2389

8" @ 80 Arb. 2385-89 5½@ 2387

TD 2389 15 goph 250 A 30 goph

500 A Comp. 25 bopd

J. E. TYRA