


Map No. K13 Sec. 11 Twp. 23 R. 3
 Well No. 1 Cartwright Farm
B + mail Company

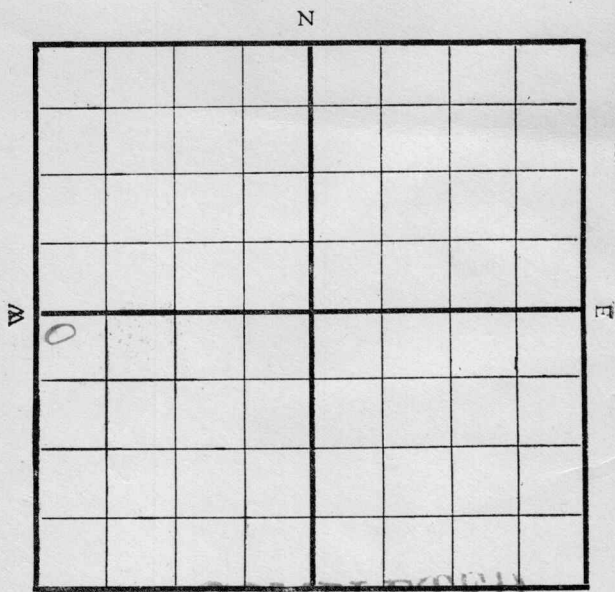

COMPLETED

Location -----

Drilling Remarks:

RECORD

Cased ----- in. ----- ft.
 Sand -----
 Gas -----
 Oil -----
 Total Depth -----

Rig Up -----


Drilling Remarks:

PRODUCTION

1st 24 hrs. Nat. -----
 1st 24 hrs. after shot -----
 Gas ----- cu. ft.
 Dry Hole -----
 Abandoned -----

Map No. _____ Sec. 11 Twp. 23 R. 3Well No. 1 Carterwright Farm
Born. Oil Co. Company_____
Contractor Sw. Quarter200 Ft. from N. Line

Ft. from S. Line

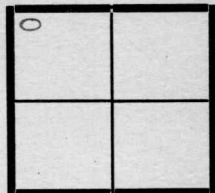Ft. from E. Line
200 Ft. from W. Line

Date	REPORT
10/11	Drlg. 750
10/21	Drlg. 1000'
10/31	Drlg. 1200'
11/4	SD 1385
12	SD 1385 for 10"
18	Set 10" 1385
25	N.A.W. 1760'
12/1	8 1/4" 1770 Set 1900 N.F.W.
9	SD. 1900'
15	SD. 1900'
22	" 1900'
31	" "
1/6/20	Drl 2050'
14	Set by tools 2050'
19	Spud rig
27	" "
2/2	Spud
9	Fishing Tools. — 100'
16	Drlg 500'
23	fish Tools 960'
3/1	" — 960'
8	SD 960 (over)

3/15/20 22 96.0

~~22~~ 2104-

22 10" 1415'

29 Collapsed 10" 1415'

4/12

24 SD 1415'

30

5/3

10

22 - AD 1415'

25 P.D. 1415'

31 Cal. 10" @ 1415'

6/7 Drq @ 1400'

15 W.R. 8" to 1495'

24 Dlg 2085'

28 F 2300'

7/13 W.R. 5" to 2370'

74 Drq. @ 2500'

26 P.D. @ 2500'

8/2 W.R. to 2600'

8/14 S. V. @ 2600'

16 SD 2600'

8/23 - Dlg @ 2610'

9/13 D & A 2635'

Map No. K 13 Sec. 11 Twp. 23 R. 3Well No. 1 CartwrightB. H. M. Oil Company

Contractor

SECTION PLAT

200 Ft. from N. Line

Ft. from S. Line

Ft. from E. Line

200 Ft. from W. Line

Location

Rig up ☒

Drilling and Remarks:

RECORD

Cased _____ in., _____ ft.

Sand _____

Gas _____

Oil _____

Total Depth _____

PRODUCTION

1st 24 hrs. Nat. _____

1st 24 hrs. after shot _____

Gas _____ Cu. Ft.

Dry Hole _____

Abandoned _____

Date

9/30 1919 Pyle Scout

Map No. K13 Sec. 11 Twp. 23 R. 3

Well No. 1 Cartwright
B & M Cliff Company

Contractor

SECTION PLAT

200 Ft. from N. Line
_____ Ft. from S. Line
_____ Ft. from E. Line
200 Ft. from W. Line

0.			

Location _____

Rig up _____

Drilling and Remarks:

750' seg.

RECORD

Cased _____ in., _____ ft.
Sand _____
Gas _____
Oil _____
Total Depth _____

PRODUCTION

1st 24 hrs. Nat. _____
1st 24 hrs. after shot _____
Gas _____ Cu. Ft.
Dry Hole _____
Abandoned _____

Date 10/14 1919 Pyle Scout

Map No. K 13 Sec. 11 Twp. 23 R. 3Well No. 1 Cartwright
B & M. Oil Company

Contractor

SECTION PLAT

200 Ft. from N. Line

Ft. from S. Line

Ft. from E. Line

200 Ft. from W. Line

0			

Location

Rig up

Drilling and Remarks:

1000'

RECORD

Cased _____ in., _____ ft.

Sand _____

Gas _____

Oil _____

Total Depth _____

PRODUCTION

1st 24 hrs. Nat. _____

1st 24 hrs. after shot _____

Gas _____ Cu. Ft.

Dry Hole _____

Abandoned _____

Date

10/21 1919

Pyle

Scout

Map No. K13 Sec. 11 Twp. 23 R. 3Well No. 1 CartwrightB T M Oil Company

Contractor

SECTION PLAT

6			

200 Ft. from N. Line

Ft. from S. Line

Ft. from E. Line

200 Ft. from W. Line

Location

Rig up

Drilling and Remarks:

RECORD

Cased _____ in., _____ ft

Sand _____

Gas _____

Oil _____

Total Depth _____

PRODUCTION

1st 24 hrs. Nat. _____

1st 24 hrs. after shot _____

Gas _____ Cu. Ft

Dry Hole 2632

Abandoned _____

Date

9/14 1920

Pyle

Scout