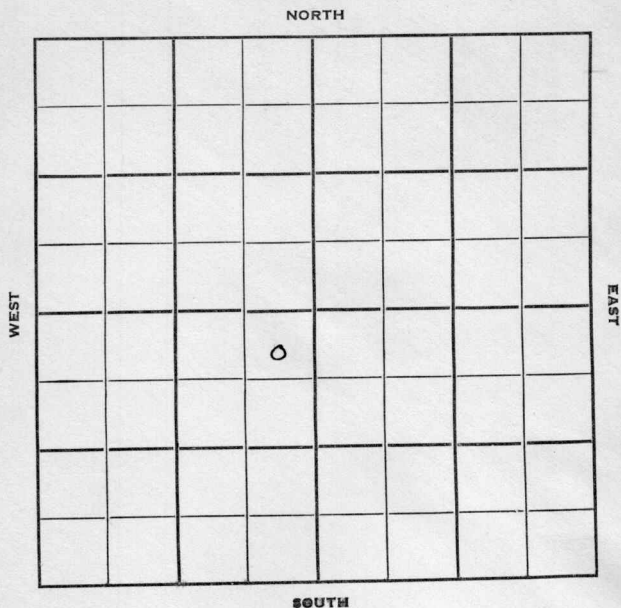


Section 12 Township 23 Range 3EWell No. #1 HornCompany Don Ingling et al

See map page
26-22-05

Butler

KANSAS

Sec. 12 Twp. 23 R. 3 E

Well No. # 1 Horn Farm

Don Ingling et al Company

Ingling Contractor

Wildcat


330 Ft. from N. Line

 Ft. from S. Line

330 Ft. from E. Line

 Ft. from W. Line

NE NE SW

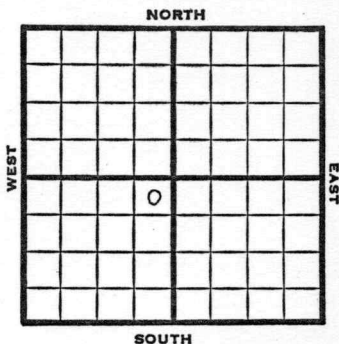

1951 Elev. 1421' REPORT

8/8 Spud 8-4-51

8" @ 108

Drlg. 400'

8/29 Spud 8-4-51

D & A TD 2827'

8" @ 108 Miss 2513' Hunton 2689'

Maq. 2726' Viola 2748'

Simp. 2814-27' TD

D & A

ABANDONED


County **Butler** State **Kansas**Sec. **12** (Blk. Twp.) **23** (Sur. Rge.) **3E** Map No.Operator **Don Ingling et al.**Well No. **1** Farm **Horn**Elev. **1421** Location **NE NE SW****330** Ft. From **N** Line **SW****330** Ft. From **E** Line **Quarter**1st. Report **AUG 8 1951**

Completion

Remarks

Ingling - Contr.Spudding Date **8-4-51**Drlg. Data **Wilcoat****3" @ 108 drlg. 400****J. E. TYRA**

County Butler State Kansas
 Sec. 12 (Blk.) 23 (Sur.) 3E Map No.
 Operator Don Ingling et al.
 Well No. 1 Farm Horn
 Elev. 1421 Location NE NE SW

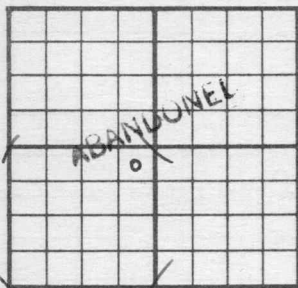

330 Ft. From N Line SW
330 Ft. From E Line Quarter

1st. Report

Completion AUG 29 1951

Remarks Wildcat

Ingling - Contr.

Spudding Date 8-4-51

Drlg. Data D & A TD 2827

8" @ 108 Miss. 2513 Hunton 2689

Maq. 2726 Viola 2748 Simp. 2814-27 TD

D & A

J. E. TYLER