

Section 30 Township 23 Range 3EWell No. 1 HarmsCompany J. P. Gaty et al

NORTH

WEST

EAST

	0						

SOUTH

Butler

KANSAS

SEC.	TWP.	R.
30	23	3E

WELL NO.

#1 Harms

FARM

COMPANY

J.P. Gaty et al

CONTRACTOR

Pabco Drlg.

Wildcat.

990

Ft. from N. Line


Ft. from S. Line

Ft. from E. Line

990

Ft. from W. Line

SE NW NW

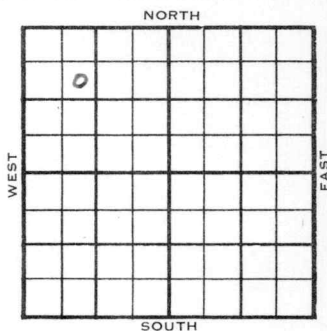

1955

ELEVATION

1420'

REPORT

2/9

R U R

2/23

Spud 2-9-55 - D&A

TD 2950'

8" @ 95'

Lans. 2093', Marm. 2486', Miss 2750',

Kh. 2929'

TD 2950'

D&A

ABANDONED

County **Butler** State **Kansas**

Sec. **30** (Blk.) **23** (Sur.) **3E** Map No.

Operator **J. P. Gaty et al.**

Well No. **1** Farm **Harms**

Elev.	Location	SE	NW	NW
-------	----------	----	----	----


990 Ft. From **N** Line **NW**

990 Ft. From W Line Quarter

1st. Report FEB 9 1955

Completion

Remarks


Pabco Drlg. - Contr.

Spudding Date _____

Drlg. Data Wildcat

R U R

FABEN GILSTRAP

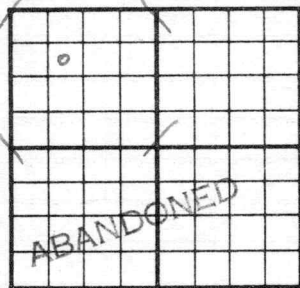County Butler State KanSec. 30 (Blk.
Twp.) 23 (Sur.
Rge.) 3E Map No.Operator J. P. Gaty et al.Well No. 1 Farm HarmsElev. 1420 Location SE NW NW990 Ft. From N Line NW990 Ft. From W Line Quarter1st. ReportCompletion FEB 23 1955Remarks WildcatPabco Drlg. - Contr.Spudding Date 2-9-55Drlg. Data D & A TD 29508" @ 95 Lans. 2093 Marm. 2486Miss. 2750 Kh. 2929 TD 2950D & A