
Butler KANSAS

SECTION 35 TOWNSHIP 23S RANGE 3E

WELL NO. #1 Paulson

COMPANY Adair

NORTH NW NW NE

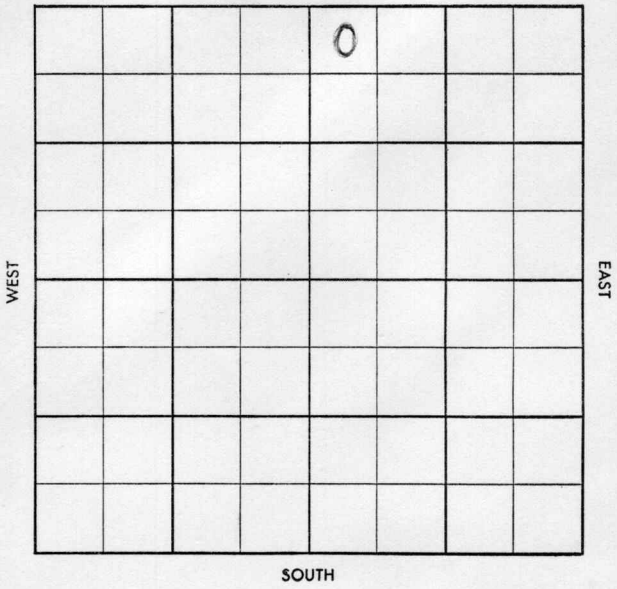

FORM 504-3 SUNRAY

WILDCAT

S-513-B

County Butler Elev.

Sec. 35 Twp. 23 Rge. 3E

Company Adair

Farm Name Paulson No. 1

TOPS	DEPTH	LOG	DATUM
Anh.			
Tp.			
H.			
Tr.			
Dg.			
B.L.			
L.			
K.C.			
B.K.C.			
Ce.			
C.			
M.			
M.			
K.			
Mz.			
Mq.			
V.			
S.			
S.			
A.			
R.			
Pf.			
G.			
T.D.			

Loc. in Sec. NW NW NE

Geol.

Contr. Co. Tools #3

Pool Wildcat



No.

Sec.

Date Comm. 2/6/58

8" @ 150, Drlg. 713

Typ. ____ Pool ____

Co. ____ Facet ____

S-513-B

County Butler Elev. 1391 DF 1394 KB

Sec. 35 Twp. 23 Rge. 3E

Company Adair

Farm Name Paulson No. 1

TOPS	DEPTH	LOG	DATUM
Anh.			
Tp.			
H.			
Tr.			
Dg.			
B.L.			
L.	1909		
K.C.	2125		
B.K.C.	2296		
Ce.			
C.	2505		
M.	2516		
M.			
K.			
Mz.			
Mq.			
V.			
S.			
S.			
A.			
R.			
Pf.			
G.			
T.D.	2529		

Loc. in Sec. NW NW NE

Geol. ____

Contr. Co. Tools #3

Pool Paulson Disc

~~Wildcat~~

COMPLETE

MAY 21 '58

Date Comm. 2/6/58

8" @ 150, Drlg. 713 FEB 28 '58 MAR 5 '58 5"

2519 CO MAR 12 '58 DST 2519-29

60" 150' oil 180' MCO BHP 670

CO 2529 FU 200' oil & 5 Bo ph

NIW NT FU 1500' oil 12 hrs

POP NIT MAR 19 '58 MAR 26 '58 APR 2 '58 APR 9 '58

APR 16 '58 APR 23 '58 APR 30 '58 P/2 bo ph nw

MAY 7 '58 MAY 14 '58 P 35 BO pd NIW MAY 21 '58

Pot 35 Bopd ~~Wtr~~ 5% Wtr 37°-39°

Co. Lse No. Sec. T. R.