
Butler

KANSAS

SECTION 35 TOWNSHIP 23S RANGE 3E

WELL NO. #1 Stephens

COMPANY E. H. Adair

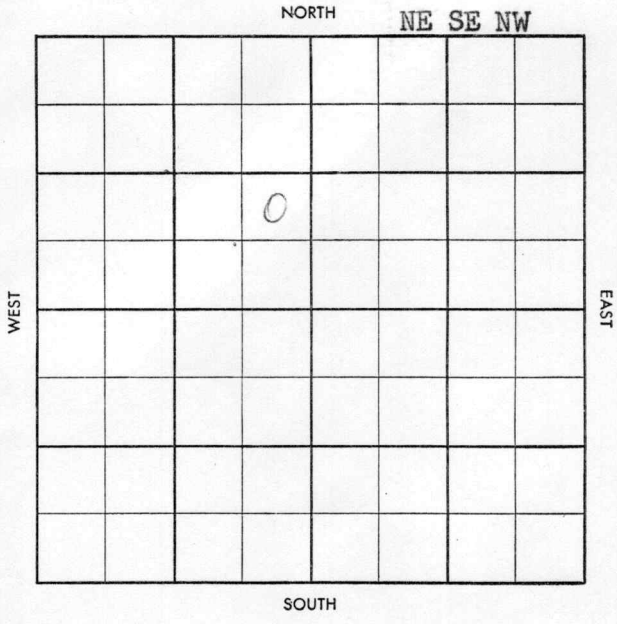

FORM 504-3 SUNRAY

Twp. X Feet 1

Rge. X Feet 10

S-513-B

County Butler Elev.

Sec. 35 Twp. 23 Rge. 3E

Company E. H. Adair

Farm Name Stephens No. 1

TOPS	DEPTH	LOG	DATUM
Anh.			
Tp.			
H.			
Tr.			
Dg.			
B. L.			
L.			
K.C.			
B.K.C.			
Ce.			
C.			
M.			
M.			
K.			
Mz.			
Mq.			
V.			
S.			
S.			
A.			
R.			
Pf.			
G.			
T.D.			

Loc. in Sec. NE SE NW

Geol. Compton

Contr. Co. Tools #3

Pool Paulson



Date Comm. 5/18/58

8" @ 148 w/100, Drlg. Ahead.

Co. Lse. No. Sec. T. R.

Twp. X Pool X

Co. X Feet X

1

S-513-B

Co.

County Butler Elev. 1404 DF 1407 RB

Sec. 35 Twp. 23 Rge. 3E

Company E. H. Adair

Farm Name Stephens No. 1

TOPS	DEPTH	LOG	DATUM
Anh.			
Tp.			
H.			
Tr.			
Dg.			
B.L.			
L.	1923		
K.C.	2133		
B.K.C.	2312		
Ce.			
C.			
M. Chert	2530		
M.			
K.			
Mz.			
Mq.			
V.			
S.			
S.			
A.			
R.			
Pf.			
G.			
T.D.	2583		

Loc. in Sec. NE SE NW

Geol. Compton

Contr. Co. Tools #3

Lse.

Pool Paulson

ABANDONED

JUL 2 '58

No.

Date Comm. 5/18/58

Sec.

8" @ 148 w/100, Drlg. Ahead. MAY 30 '58 JUN 3 '58

DST 2533-53 op/hr 60' SO spt mud

790 5" 2583 co JUN 11 '58 JUN 18 '58

T.

48/2533-48 bk to 80 1hr ½ FV 150'

oil 900' w 24 hrs frac 10 x 4.8

JUN 25 '58 JUL 2 '58 & 480 +120 BW

R.

T & A