

Section 35 Township 23 Range 3 EWell No. # 1 T. StevensCompany R. J. Wickson

NORTH

		0					

WEST

EAST

SOUTH

Butler

KANSAS

Sec. 35 Twp. 23 R. 3E

Well No. #1 T. Stevens Farm

R. J. Wickson Company

Wickson - Contr. Contractor

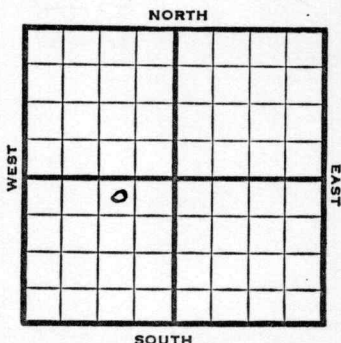
Wildcat
330' Ft. from N. Line

 Ft. from S. Line

990' Ft. from E. Line

 Ft. from W. Line

NW NE SW



1952

Elev. 1416'

REPORT

2/13

Spud 2-11-52

3/19

Spud 2-11-52

D & A TD 2790' 15" @ 131

10" @ 1335 Lans. 1890'

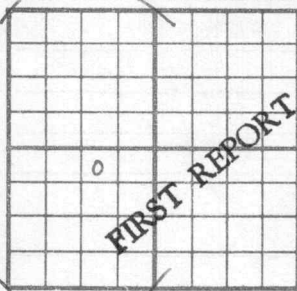
8" @ 1955' KC 2170' Cong. 2520'

Chat 2570' Kh. 2695' 5" @ 2723'

Hunton 2783' TD 2790' HFW

D & A

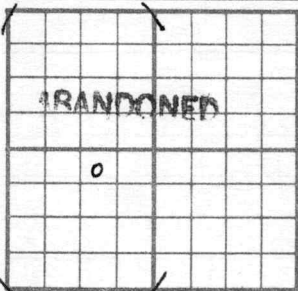
ABANDONED

County **Butler** State **Kansas**Sec. **35** (Blk.) **23** (Sur.) **3E** Map No.Operator **R. J. Wickson**Well No. **1** Farm **T. Stevens**Elev. Location **NW NE SW****330** Ft. From **N** Line **SW****990** Ft. From **E** Line Quarter1st. Report **FEB 13 1952**

Completion

Remarks

Wickson - Contr.Spudding Date **2-11-52**Drlg. Data **Wildcat****J. G. McGEHEE**

County Butler State KansasSec. 35 (Blk.
Twp.) 23 (Sur.
Rge.) 3E Map No. _____Operator R. J. WixsonWell No. 1 Farm T. StevensElev. 1416 Location NW NE SW330 Ft. From N Line SW990 Ft. From E Line Quarter

1st. Report _____

Completion MAR 19 1952Remarks WildcatWixson - Contr.Spudding Date 2-11-52Drlg. Data D & A TD 279015" @ 131 10" @ 1335 Lans. 18908" @ 1955 KC 2170 Cong. 2520Chat 2570 Kh. 2695 5" @ 2723Hunton 2783 TD 2790 HFWD & A

J. G. McGEHEE