


Map No. \_\_\_\_\_ Sec. 3 Twp. 23 R. 4  
 Well No. 1 Little Farm \_\_\_\_\_  
Davis & Co Company \_\_\_\_\_

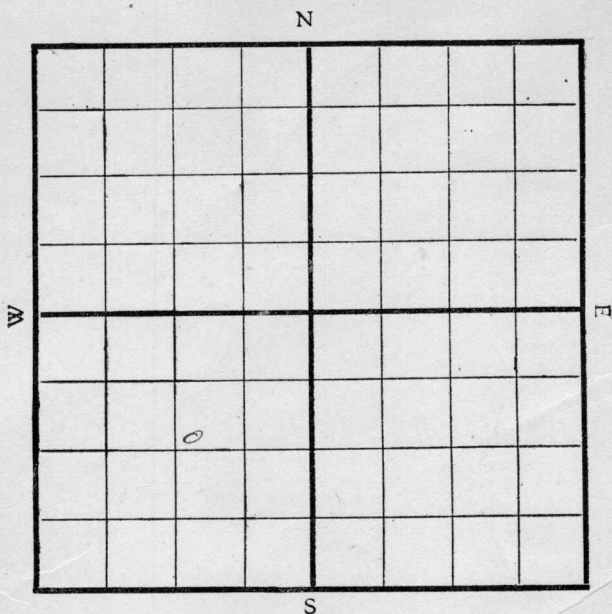

Location \_\_\_\_\_

Drilling Remarks:

Rig Up \_\_\_\_\_

Drilling Remarks:

COMPLETED

### RECORD

Cased \_\_\_\_\_ in. \_\_\_\_\_ ft.

Sand \_\_\_\_\_

Gas \_\_\_\_\_

Oil \_\_\_\_\_

Total Depth \_\_\_\_\_

### PRODUCTION

1st 24 hrs. Nat. \_\_\_\_\_

1st 24 hrs. after shot \_\_\_\_\_

Gas \_\_\_\_\_ cu. ft.

Dry Hole \_\_\_\_\_


Abandoned \_\_\_\_\_

Map No. \_\_\_\_\_ Sec. 2 Twp. 23 R. 4Well No. 1 Little Farm  
Davis et al Company1120 Ft. from N. Line

\_\_\_\_\_ Ft. from S. Line

1120 Ft. from E. Line

\_\_\_\_\_ Ft. from W. Line

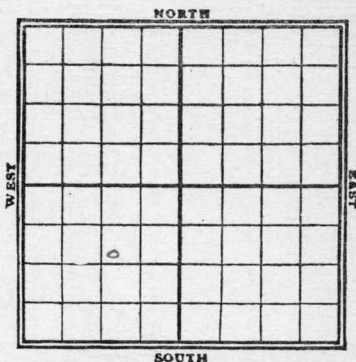1920  
Date

REPORT

1/6 Location14 Rig19 Tools27 Spud2/2 Drl 400'9 Dreg. 980'16 10" - 1460'21 10" - 1460'3/1 Dreg. 1475'8 10" - 152015 Dreg 192022 205029 6 5/8 24184/12 Dry & Aband 2550

FIRST REPORT

COMPLETED

Map No. K 14 Sec. 3 Twp. 23 R. 4Well No. 1 Tuttle  
Davis Oil Company

Contractor

## SECTION PLAT

1120 Ft. from N. Line

Ft. from S. Line

1120 Ft. from E. Line

Ft. from W. Line

|  |  |  |  |
|--|--|--|--|
|  |  |  |  |
|  |  |  |  |
|  |  |  |  |
|  |  |  |  |
|  |  |  |  |

FIRST REPORT

Location

Rig up

Drilling and Remarks:

## RECORD

Cased \_\_\_\_\_ in., \_\_\_\_\_ ft.

Sand \_\_\_\_\_

Gas \_\_\_\_\_

Oil \_\_\_\_\_

Total Depth \_\_\_\_\_

## PRODUCTION

1st 24 hrs. Nat. \_\_\_\_\_

1st 24 hrs. after shot \_\_\_\_\_

Gas \_\_\_\_\_ Cu. Ft.

Dry Hole \_\_\_\_\_

Abandoned \_\_\_\_\_

Date

Pyle

1/6 1919

Scout

Sec. 3 Twp. 23 Rge. 4

Owner Davis Oil

Farm Tuttle Well No. 1

Contractor \_\_\_\_\_

Feet from lines, N. 1120 E. 1120 S. \_\_\_\_\_ W. \_\_\_\_\_

NORTH

Casing used \_\_\_\_\_

15½ \_\_\_\_\_ ft.

12½ \_\_\_\_\_ ft.

10 \_\_\_\_\_ ft.


8¼ \_\_\_\_\_ ft.

6⅝ \_\_\_\_\_ ft.

5 3-16 \_\_\_\_\_ ft.

Location \_\_\_\_\_

Rig \_\_\_\_\_

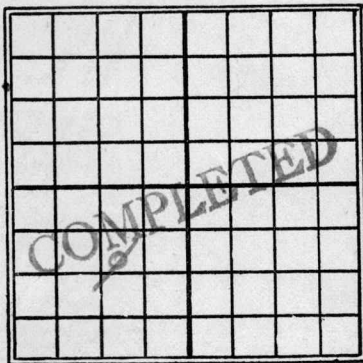

SOUTH

Drilling at \_\_\_\_\_ ft. Fishing at \_\_\_\_\_ ft.

Total Depth \_\_\_\_\_ Completed \_\_\_\_\_

1st 24 Hrs. Nat. \_\_\_\_\_ Producing \_\_\_\_\_

1st 24 Hrs. Shot \_\_\_\_\_ Dry Hole 2550'

Gas \_\_\_\_\_ Cu. ft. Abandoned \_\_\_\_\_

Sands — give name and depth. Top \_\_\_\_\_ Bottom \_\_\_\_\_

Date of Report 4/12

Reported by Pyle

K14 Butler  
 MAP No. KANSAS SEC. 3 TWP. 23S R. 4E

WELL No. 1 Buttle

Blair Oil Corp COMPANY

CONTRACTOR

### SECTION PLAT

ABANDONED

|  |  |  |  |
|--|--|--|--|
|  |  |  |  |
|  |  |  |  |
|  |  |  |  |
|  |  |  |  |

\_\_\_\_\_ FT. FROM N. LINE

\_\_\_\_\_ FT. FROM S. LINE

\_\_\_\_\_ FT. FROM E. LINE

\_\_\_\_\_ FT. FROM W. LINE

### RECORD

LOCATION \_\_\_\_\_

CASED \_\_\_\_\_ IN. \_\_\_\_\_ FT.

RIG UP \_\_\_\_\_

SAND \_\_\_\_\_

DRILLING AND REMARKS:

GAS \_\_\_\_\_

OIL \_\_\_\_\_

TOTAL DEPTH 2550

### PRODUCTION

1ST 24 HRS. NAT. \_\_\_\_\_

1ST 24 HRS. AFTER SHOT \_\_\_\_\_

GAS \_\_\_\_\_ CU. FT.

DRY HOLE ✓

ABANDONED ✓

DATE

4/12 1920 SCOUT