


NORTH

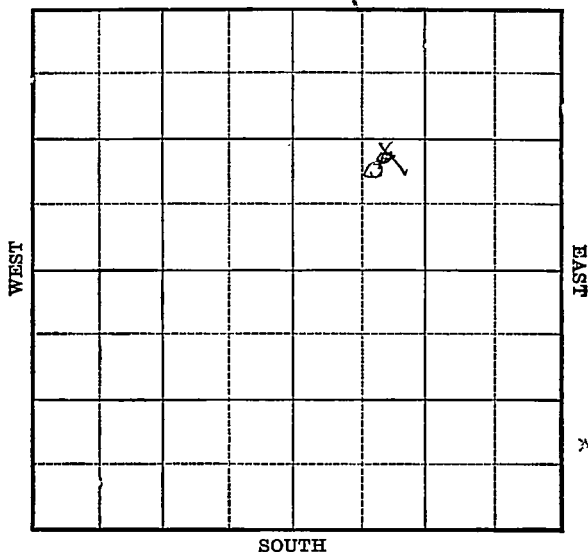

Rig Up_____

Drilling Remarks

PRODUCTION

1st 24 hrs. Nat. _____

1st 24 hrs. after shot_____

Gas_____cu. ft.

Dry Hole

Abandoned

Greenwood

Map No. 117N Sec. 28 Twp. 23 R. 13Well No. 8 Dehlinger "A" Farm
Mid-Cont Pet Corp Company

NORTH


1520 Ft. from N. Line

_____ Ft. from S. Line

_____ Ft. from E. Line

1173
843 Ft. from W. Line

WEST

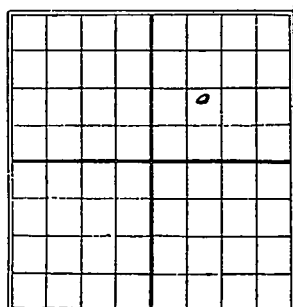

EAST

SOUTH

1926

Date

REPORT

8/4 Location

8/11

8/18 rigging up

8/25 same

8-31 Aug. 205'

9/15 Drlg 915'

9/22 " 1185'

9/29 " 1650

10/13 cleaning out & swabbing

10/20 sand 1745-1758

top lime 1725

60/15 bbb

17 **KANSAS** 28 **Benwood** 23 13
 Map No. Sec. Twp. R.
 Well No. 8 Deblinger "H"
 MID-CONT Pet Corp Company

Contractor

FIRST REPORTS

SECTION PLAT

1520 Ft. from N. Line

Ft. from S. Line

Ft. from E. Line

843 Ft. from W. Line

		0	

Location ✓

Rig up

Drilling and Remarks:

RECORD

Cased _____ in., _____ ft.

Sand _____

Gas _____

Oil _____

Total Depth _____

PRODUCTION

1st 24 hrs. Nat. _____

1st 24 hrs. after shot _____

Gas _____ Cu. Ft.

Dry Hole _____

Abandoned _____

Date

AUG 4 1926

CHAS. L. SHERWOOD

192

Scout

Sheltonwood
 Map No. **17** **KANSAS** Sec. **28** Twp. **23** R. **13**
 Well No. **8 Dehlinger #**
M. J. Con. & Let Corp Company

CORRECTION

Contractor

SECTION PLAT

		o	

1520 Ft. from N. Line

Ft. from S. Line

Ft. from E. Line

1173 Ft. from W. Line*Prod Reported @ 843' from West line.*

Location

Rig up

Drilling and Remarks:

Ok 1185'
ch feet near
to shoe.

RECORD

Cased _____ in., _____ ft.

Sand _____

Gas _____

Oil _____

Total Depth _____

PRODUCTION

1st 24 hrs. Nat. _____

1st 24 hrs. after shot _____

Gas _____ Cu. Ft.

Dry Hole _____

Abandoned _____

Date

SEP 22 1926

CHAS. L. SHERWOOD

192

Scout

Chas L Sherwood
 17 KANSAS 28 23 13
 Map No. Sec. Twp. R.
 Well No. 8 *Dehlinger #*
Med Cont Oil Corp Company

Contractor

COMPLETED

SECTION PLAT

1520 Ft. from N. Line

_____ Ft. from S. Line

_____ Ft. from E. Line

1173 Ft. from W. Line

		o	

Location _____

Rig up _____

Drilling and Remarks:

Top line 1725

bay 15 lbs.

RECORD

Cased _____ in. _____ ft.

Sand *1745-1758*

Gas _____

Oil _____

Total Depth *1760*

PRODUCTION

1st 24 hrs. Nat. _____

1st 24 hrs. after shot _____

Gas _____ Cu. Ft.

Dry Hole _____

Abandoned _____

Date

OCT 20 1926

CHAS. L. SHERWOOD

192

Scout