

WEST

EAST

SOUTH

COMPLETED SOUTH

Drilling Remarks:

Drilling Remarks:

Cased----- in.----- ft.

Sand -----

Gas -----

Oil -----

Total Depth_____

1st 24 hrs. Nat.-----

1st 24 hrs. after shot-----

Gas----- cu. ft.

Dry Hole -----

Abandoned _____


Map No. _____ Sec. 3 Twp. 26 R. 4Well No. 1 KnappaDerby et al Company

Contractor _____

NORTH

WEST

EAST

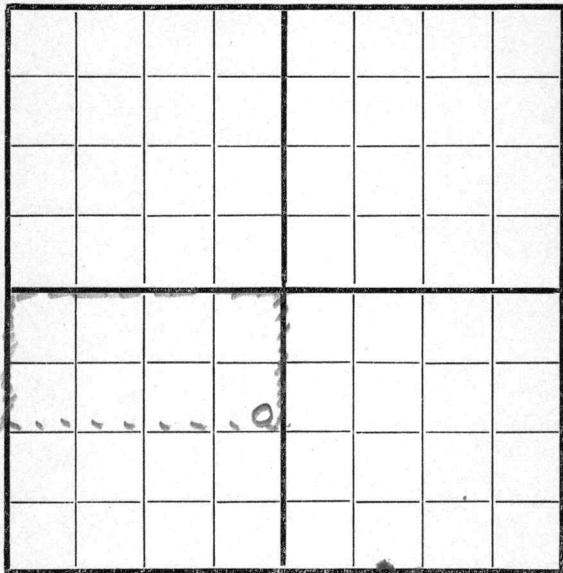

SOUTH

200' ~~W~~ E 1/20' ~~W~~ S

Location _____

Rig up ☒

Drilling and Remarks:

RECORD

Cased _____ in., _____ ft.

Sand _____

Gas _____

Oil _____

Total Depth _____

PRODUCTION

1st 24 hrs. Nat. _____

1st 24 hrs. after shot _____

Gas _____ Cu. Ft.

Dry Hole _____

Abandoned _____

Date

7/31

191

8 Canby

Scout


Map No. 114 Sec. 3 Twp. 26 R. 4Well No. 1 KnappaCompany Derby et al

Contractor _____

NORTH

WEST

EAST

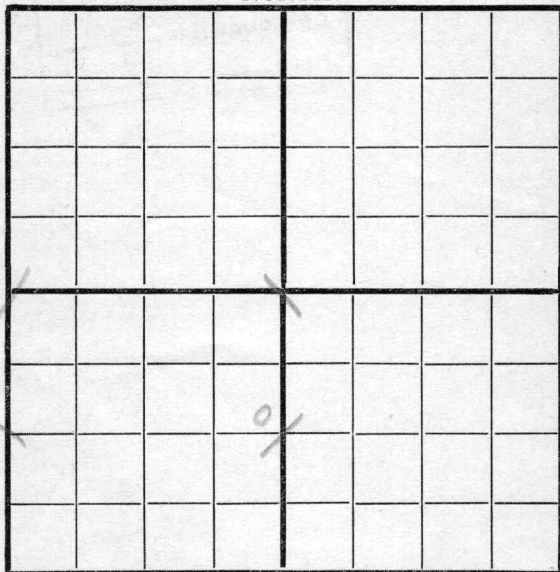

SOUTH

1120' N - 200 E

Location _____

Rig up ☒ _____

Drilling and Remarks:

FIRST REPORT

RECORD

Cased _____ in., _____ ft.

Sand _____

Gas _____

Oil _____

Total Depth _____

PRODUCTION

1st 24 hrs. Nat. _____

1st 24 hrs. after shot _____

Gas _____ Cu. Ft.

Dry Hole _____

Abandoned _____

Date


8/1 191 8 Scout

Map No. _____ Sec. 3 Twp. 26 R. 4
 Well No. 1 Trapp _____ Company _____
 _____ Contractor _____

NORTH

WEST

EAST

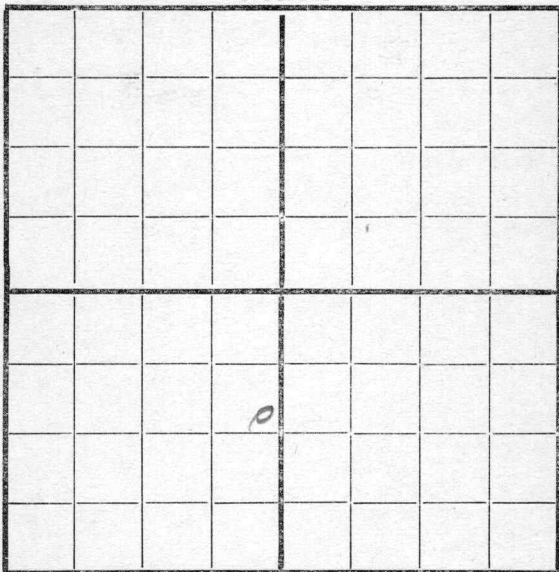

SOUTH

200 E 1120 N

Location _____

Rig up ✓ _____

Drilling and Remarks:

RECORD

Cased _____ in., _____ ft.

Sand _____

Gas _____

Oil _____

Total Depth _____

PRODUCTION

1st 24 hrs. Nat. _____

1st 24 hrs. after shot _____

Gas _____ Cu. Ft.

Dry Hole _____

Abandoned _____

Date

8/2 1918 Candy Scout

Map No. _____ Sec. 3 Twp. 26 R. 4Well No. 1 _____


Company _____

Contractor _____

NORTH

WEST

EAST

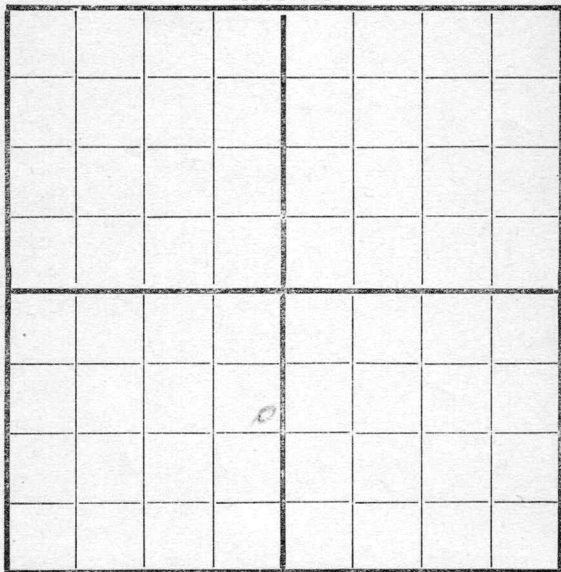

SOUTH

Location 11202
2008

Rig up _____

Drilling and Remarks:

Spudding

RECORD

Cased _____ in., _____ ft.

Sand _____

Gas _____

Oil _____

Total Depth _____

PRODUCTION

1st 24 hrs. Nat. _____

1st 24 hrs. after shot _____

Gas _____ Cu. Ft.

Dry Hole _____

Abandoned _____

Date

8/16 1915 C. E. C. Co. Scout

Map No. _____ Sec. 3 Twp. 26 R. 4Well No. 1 Knappa


Company _____

Contractor _____

NORTH

WEST

EAST

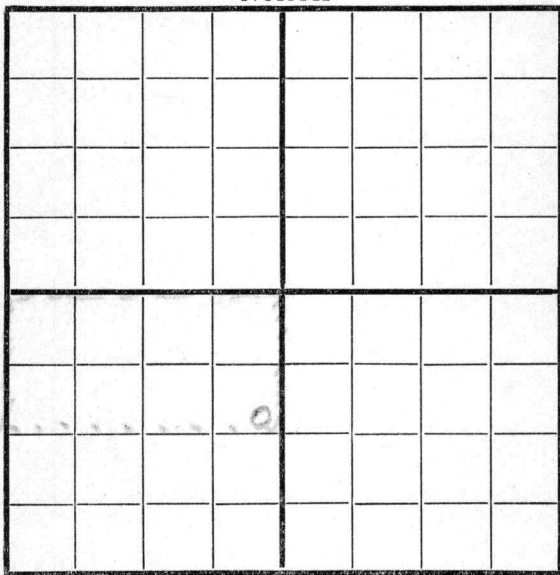

SOUTH

Location _____

Rig up _____

Drilling and Remarks:

350'

RECORD

Cased _____ in., _____ ft.

Sand _____

Gas _____

Oil _____

Total Depth _____

PRODUCTION

1st 24 hrs. Nat. _____

1st 24 hrs. after shot _____

Gas _____ Cu. Ft.

Dry Hole _____

Abandoned _____

Date

8/211918

Pyle

Scout


Map No. 1514 Sec. 3 Twp. 26 R. 4Well No. 1514Company Deery et al

Contractor _____

NORTH

WEST

EAST

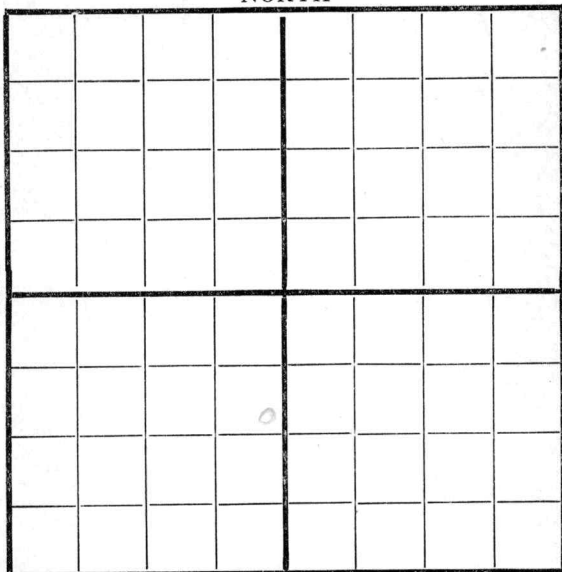

SOUTH

1120 x 200 E

Location _____

Rig up _____

Drilling and Remarks:

900

RECORD

Cased _____ in., _____ ft.

Sand _____

Gas _____

Oil _____

Total Depth _____

PRODUCTION

1st 24 hrs. Nat. _____

1st 24 hrs. after shot _____

Gas _____ Cu. Ft.

Dry Hole _____

Abandoned _____

Date

8/28 J. C. Cady Scout

Map No. 1514 Sec. 3 Twp. 26 R. 4

Well No. 1514


Deery et al Company

Contractor

NORTH

WEST

EAST

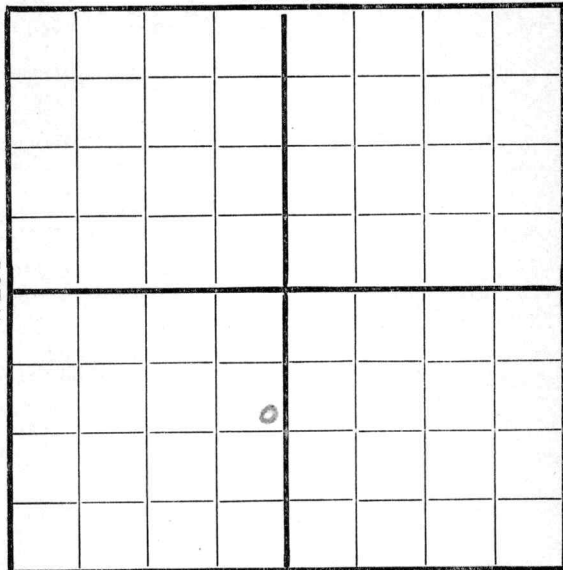

SOUTH

1120 x 200 E

RECORD

Location _____

Cased _____ in., _____ ft.

Rig up _____

Sand _____

Drilling and Remarks:

Gas _____

Oil _____

Total Depth _____

PRODUCTION

1st 24 hrs. Nat. _____

1st 24 hrs. after shot _____

Gas _____ Cu. Ft.

Dry Hole _____

Abandoned _____

Date

9/4 191 Deery Scout


Map No. 1514 Sec. 3 Twp. 26 R. 4Well No. 1 KnappaDarby Petrol Company

Contractor

NORTH

WEST

EAST

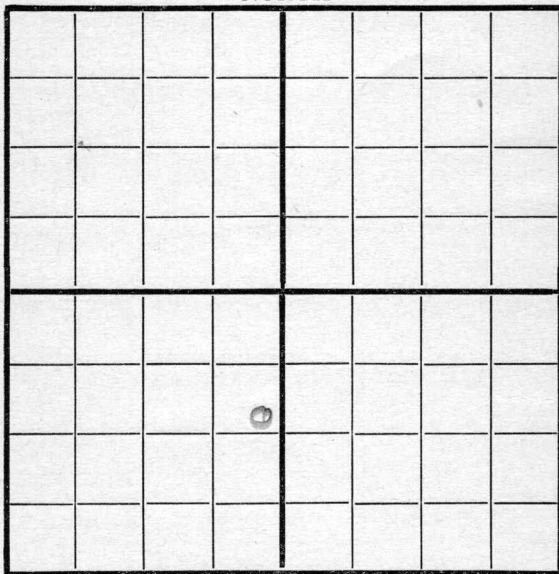

SOUTH

1130 N - 200 E

RECORD

Location _____

Cased _____ in., _____ ft.

Rig up _____

Sand _____

Drilling and Remarks:

Gas _____

Oil _____

Total Depth _____

PRODUCTION

1st 24 hrs. Nat. _____

1st 24 hrs. after shot _____

Gas _____ Cu. Ft.

Dry Hole _____

Abandoned _____


Date

9/111918Candy

Scout

Map No. 1514 Sec. 3 Twp. 26 R. 4

Well No. 1 1514
Darby Petrol Company
 Contractor

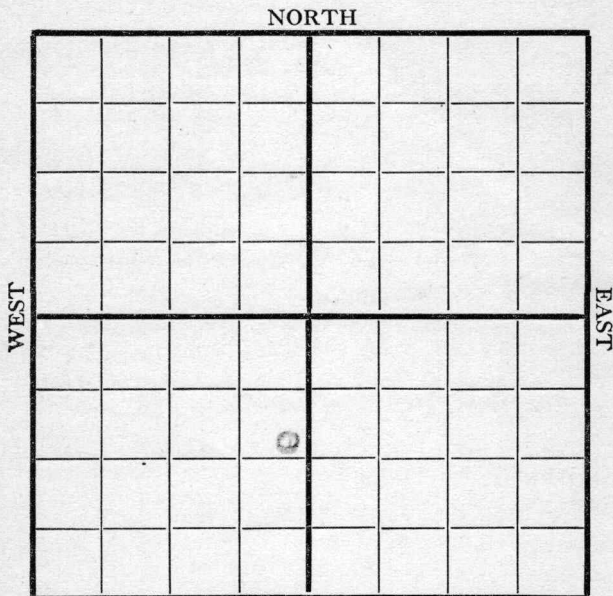

1120 N. 3rd E

Location _____

Rig up _____

Drilling and Remarks:

2320

RECORD

Cased _____ in., _____ ft.

Sand _____

Gas _____

Oil _____

Total Depth _____

PRODUCTION

1st 24 hrs. Nat. _____

1st 24 hrs. after shot _____

Gas _____ Cu. Ft.

Dry Hole _____

Abandoned _____

Date


9/18

191

8 Quincy

Scout

Map No. 1574 Sec. 3 Twp. 26 R. 4
Well No. 1 Triangle
Derby et al Company
Contractor

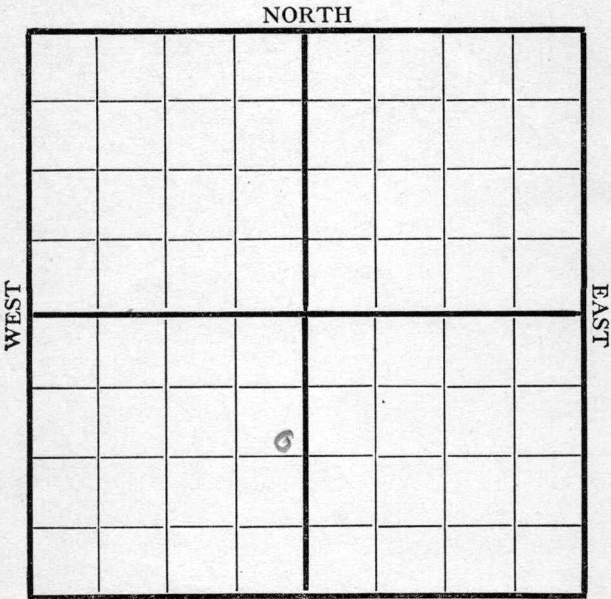

1120 N - 200 E

	RECORD	
Location	Cased.....in.,ft.	
Rig up.....	Sand.....	
Drilling and Remarks:	Gas.....	
<u>Top Sand</u> <u>2412:</u> <u>Good showing</u>	Oil.....	
	Total Depth.....	
	PRODUCTION	
	1st 24 hrs. Nat.	
	1st 24 hrs. after shot.....	
	Gas.....Cu. Ft.	
	Dry Hole.....	
	Abandoned.....	

Date 9/25 8 Condy Scout

Map No. 1514 Sec. 3 Twp. 26 R. 4Well No. 1 TringaleCompany Derby et al

Contractor _____

NORTH

WEST

COMPLETED

EAST

SOUTH

RECORD

Location _____

Cased _____ in., _____ ft.

Rig up _____

Sand 2412-2428

Drilling and Remarks:

Gas _____

Oil _____

Total Depth _____

PRODUCTION

1st 24 hrs. Nat. _____

1st 24 hrs. after shot _____

Gas _____ Cu. Ft.

Dry Hole _____

Abandoned _____

Date

10/1 1918 Conder Scout