


Map No. _____ Sec. 4 Twp. 23 R. 4
 Well No. 2 Hawk Farm _____
Pine Oil Company _____

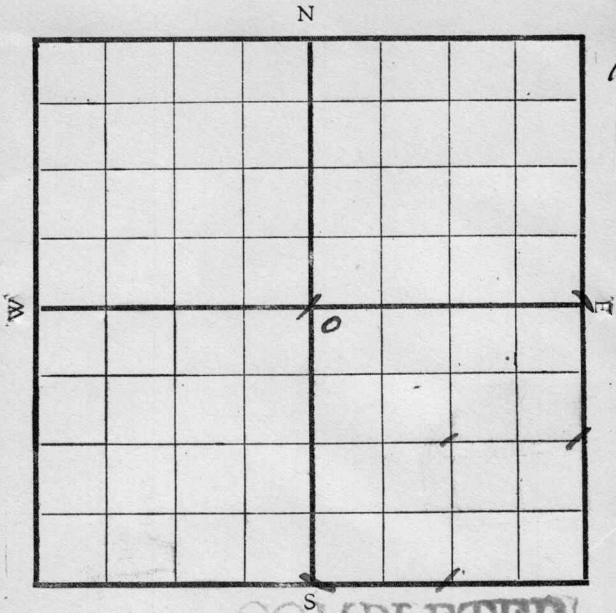

COMPLETED

Location _____

Drilling Remarks:

RECORD

Cased _____ in. _____ ft.
 Sand _____
 Gas _____
 Oil _____
 Total Depth _____

Rig Up _____

Drilling Remarks:


PRODUCTION

1st 24 hrs. Nat. _____
 1st 24 hrs. after shot _____
 Gas _____ cu. ft.
 Dry Hole _____
 Abandoned _____

Map No. _____ Sec. 4 Twp. 23 R. 4Well No. 2 Hawk Farm _____
The Pure Oil Company200 Ft. from N. Line

_____ Ft. from S. Line

_____ Ft. from E. Line

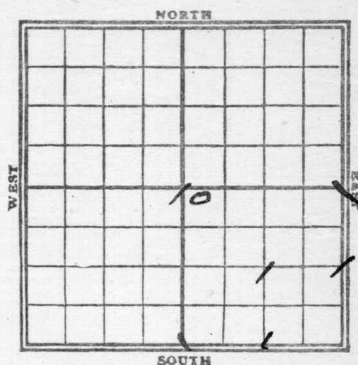200 Ft. from W. Line

REPORT

FIRST REPORT

7/13

Timber

24~~24~~8/28/14169/13202710/18

Rig

Rig

Rig

Rig 1980

2275'

2310

2385.90 - 25 bbl.

Map No. K14 Sec. 4 Twp. 23 R. 4Well No. 2 HawkThe Pure Oil Company

Contractor

SECTION PLAT

200 Ft. from N. Line

Ft. from S. Line

Ft. from E. Line

200 Ft. from W. Line~~CHANGE LESSEE NAME~~

RECORD

Location

Cased _____ in., _____ ft.

Rig up

Sand _____

Drilling and Remarks:

Gas _____

Oil _____

Total Depth _____

PRODUCTION

1st 24 hrs. Nat. _____

1st 24 hrs. after shot _____

Gas _____ Cu. Ft.

Dry Hole _____

Abandoned _____

Date

Pyle

7/13 1920

Scout

Map No. K14 Sec. 4 Twp. 23 R. 4Well No. 2 Hawk
The Pure Oil Company

Contractor

SECTION PLAT

200 Ft. from N. Line

Ft. from S. Line

Ft. from E. Line

200 Ft. from W. Line

		•	

COMPLETED

Location

Rig up

Drilling and Remarks:

RECORD

Cased _____ in., _____ ft.

Sand 2385-90

Gas _____

Oil _____

Total Depth _____

PRODUCTION

1st 24 hrs. Nat. 25 bbls

1st 24 hrs. after shot _____

Gas _____ Cu. Ft.

Dry Hole _____

Abandoned _____

Date

10/18 19120

Pyle

Scout