


Section 4 Township 23 Range 4E

Well No. 12 Hawk

Company Magnolia Petroleum

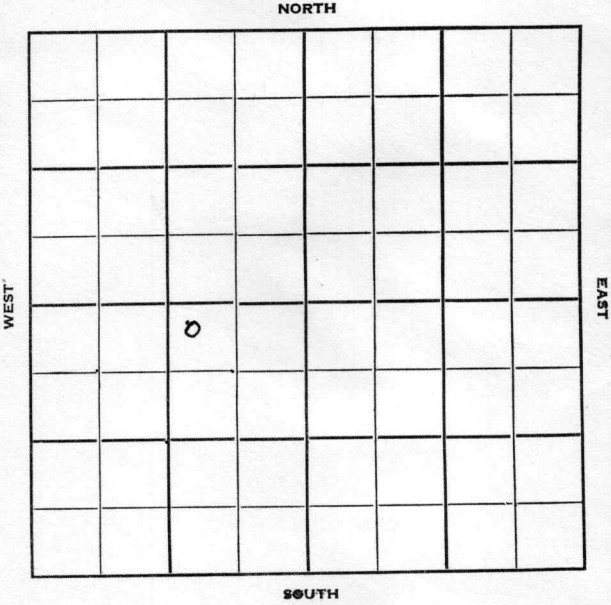

Butler

KANSAS
4E

Sec. 4 Twp. 23 R. 4E

Well No. #12 Hawk Farm

Magnolia Petroleum Company

Contractor


280' Ft. from N. Line

Ft. from S. Line

760' Ft. from E. Line

Ft. from W. Line

NW NE SW

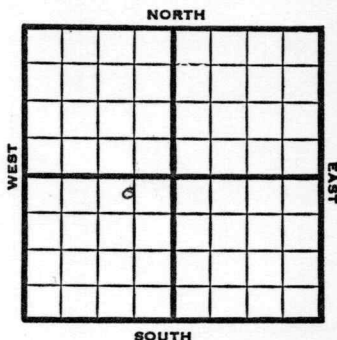

1951

Elev. 1440' REPORT

7/18

Location

8/29

Spud 7-19-51

SWD well TD 2881'

8" @ 105' Lans. 1826' KC 1999'

Misenoer 2412' Viola 2416'

DST 2440-64 open 1 hr. rec 1975' water

Cored 2464-74 rec 8½' dol.

Cored 2471-91 rec 16' shale.

Arb. 2572'

DST 2573-85 open 1 hr. rec 248' mud

& water TD 2881' 5" @ 2583'

CO to 2881 2500 A

Comp. for SWD well

Input 3250 BSWPD

ABANDONED

County **Butler** State **Kansas**

Sec. **4** (Blk. **23** (Sur. **4E** Map No.

Operator Magnolia Petroleum

Well No. 12 Farm Hawk

Elev.	Location	NW	NE	SW
-------	----------	----	----	----

0

FIRST REPORT

280 Ft. From N Line SW

760 Ft. From E Line Quarter

1st. Report JUL 18 1951

Completion

Remarks

Spudding Date _____

Drlg. Data

Location

J. E. TYRA

County Butler State KansasSec. 4 (Blk.) 23 (Sur.) 4E Map No.Operator Magnolia PetroleumWell No. 12 Farm HawkElev. 1440 Location NW NE SW280 Ft. From N Line SW760 Ft. From E Line Quarter

1st. Report

Completion AUG 29 1951

Remarks

Spudding Date 7-19-51Drlg. Data SWD well TD 28818" @ 105 Lans. 1826 KC 1999Misener 2412 Viola 2416 DST 2440-64open 1 hr. Rec. 1975' water Cored2464-74 rec. 8 $\frac{1}{2}$ ' dol. Cored 2471-91rec. 16' shale Arb. 2572 DST 2573-85open 1 hr. Rec. 248' mud & waterTD 2881 5" @ 2583 CO to 2881 2500 AComp. for SWD well Input 3250 bswpd

J. E. TYRA