


Section 4 Township 23 Range 4 EWell No. # 6 D. HoldenCompany Magnolia Pet.

NORTH

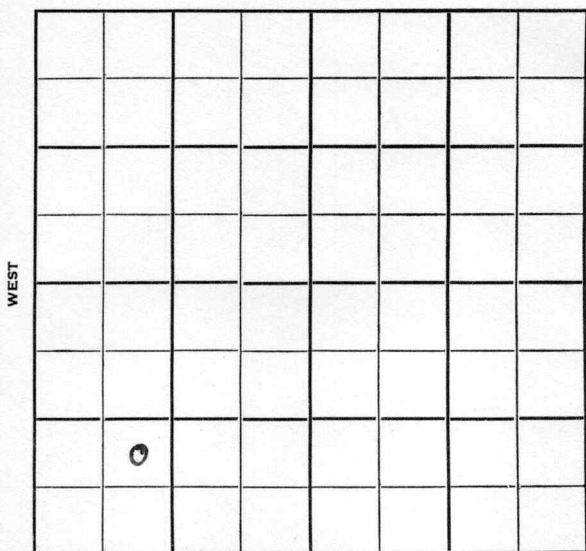

SOUTH

13

Butler

KANSAS

Sec. 4 Twp. 23 R. 4E

Well No. #6 D. Holden Farm

Magnolia Company

Contractor

Ft. from N. Line

990'


Ft. from S. Line

Ft. from E. Line

990'

Ft. from W. Line

NE SW SW

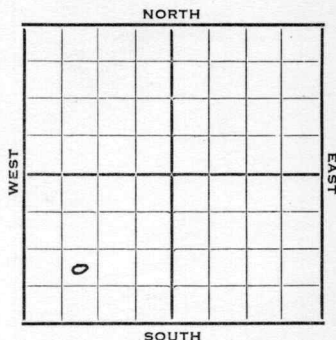

1952

Elev. 1434'

REPORT

3/19

Location

4/30

Spud 3-22-52

8" @ 102'

Lans. 1845

KC 2030

TD 2151 5" @ 2151 CO to 2145

80/ 2098-2118 1000 A S/ 4 bo

10 bw 20 hr.

Comp. 4 bopd 7 bw

COMPLETED

County	Butler			State	Kansas
Sec.	4	(Blk.) (Twp.)	23	(Sur.) (Rge.)	4E
					Map No.

Sec. **4** (Blk.) **23** (Sur.) **4E** Map No.

Operator **Magnolia**

Well No. **6** Farm **D. Holden**

Elev.	Location	NE	SW	SW
-------	----------	----	----	----

990 Ft. From S Line SW

990 Ft. From W Line Quarter

1st. Report MAR 19 1952

Completion

Remarks

Spudding Date

Drlq. Data

Location

J. G. McGEHEE

Operator Magnolia Pet.

Well No. 6 Farm D. Holden

Elev. 1434 Location NE SW SW

A 10x10 grid. The word "COMPLETE" is written diagonally across the top half of the grid. A small circle is located in the bottom left corner of the grid.

990 Ft. From S Line SW

990 Ft. From W Line Quarter

1st. Report

Completion APR 30 1959

Remarks

Spudding Date **3-22-52**

Drlg. Data Oilwell TD 2151

8" @ 102 Lens. 1845 KC 2030

TD 2151 5" @ 2151 CO to 2145

80/ 2098-2118 1000 A S/ 4 bo 10 bw

20 hr. Comp. 4 bopd 7 bw

J. G. McGEHEE