


Map No. 15 Sec. 4 Twp. 23 R. 4
 Well No. 2 Supermaught Farm
Leahoma Pet Company

N (Supermaught)

5

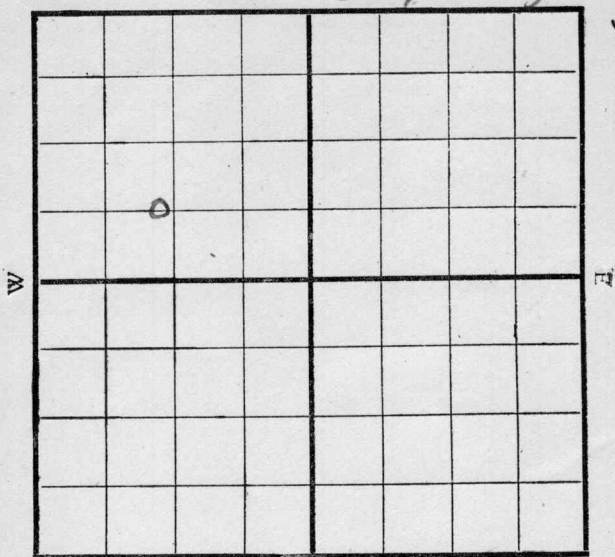

COMPLETED

Location _____

Drilling Remarks:

RECORD

Cased _____ in. _____ ft.
 Sand _____
 Gas _____
 Oil _____
 Total Depth _____

Rig Up _____

Drilling Remarks:

PRODUCTION

1st 24 hrs. Nat. _____
 1st 24 hrs. after shot _____
 Gas _____ cu. ft.
 Dry Hole _____
 Abandoned _____


Map No. _____ Sec. 4 Twp. 23 R. 4
 Well No. 2 Supernangle Farm
Tephoma P.H. Company

_____ Ft. from N. Line

660 Ft. from S. Line

_____ Ft. from E. Line

1120 Ft. from W. Line

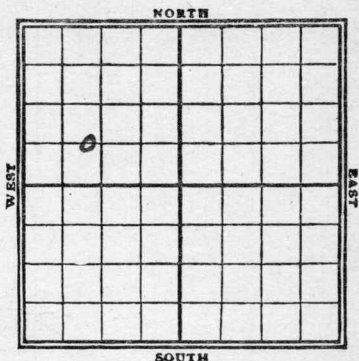

1920

REPORT

FIRST REPORT

6/28 Rig up
 7/13 300
 24 Limb Rig @ 860'
 26 Oel @ 1565'
 8/2 @ 2150
 8/14 20lg @ 2295'
 16 2452-59 HFW. Plug back to 2212
 9/13 Plugged back
 Sand 5032' - 2183 TO 2457
 70 BOP

Map No. K 14 Sec. H Twp. 23 R. 4Well No. 2 SupermaughTephond Pet Company

Contractor

SECTION PLAT

o			

Ft. from N. Line

660 Ft. from S. Line

Ft. from E. Line

1120 Ft. from W. Line

RECORD

Location

Rig up

Drilling and Remarks:

Cased _____ in., _____ ft.

Sand _____

Gas _____

Oil _____

Total Depth _____

PRODUCTION

1st 24 hrs. Nat. _____

1st 24 hrs. after shot _____

Gas _____ Cu. Ft.

Dry Hole _____

Abandoned _____

Date

6/28 1912

Pyle

Scout

Map No. K14 Sec. 4 Twp. 23 R. 4Well No. 2 SupernayghLephoma Pet Company

Contractor

SECTION PLAT

Ft. from N. Line

660 Ft. from S. Line

Ft. from E. Line

1120 Ft. from W. Line

COMPLETED

Location

Rig up

Drilling and Remarks:

Plugged
back to
2212

RECORD

Cased _____ in., _____ ft.

Sand 2035-2185

Gas _____

Oil _____

Total Depth 2459

PRODUCTION

1st 24 hrs. Nat. 70 bbls

1st 24 hrs. after shot _____

Gas _____ Cu. Ft.

Dry Hole _____

Abandoned _____

Date

9/14 1920

Pyle

Scout